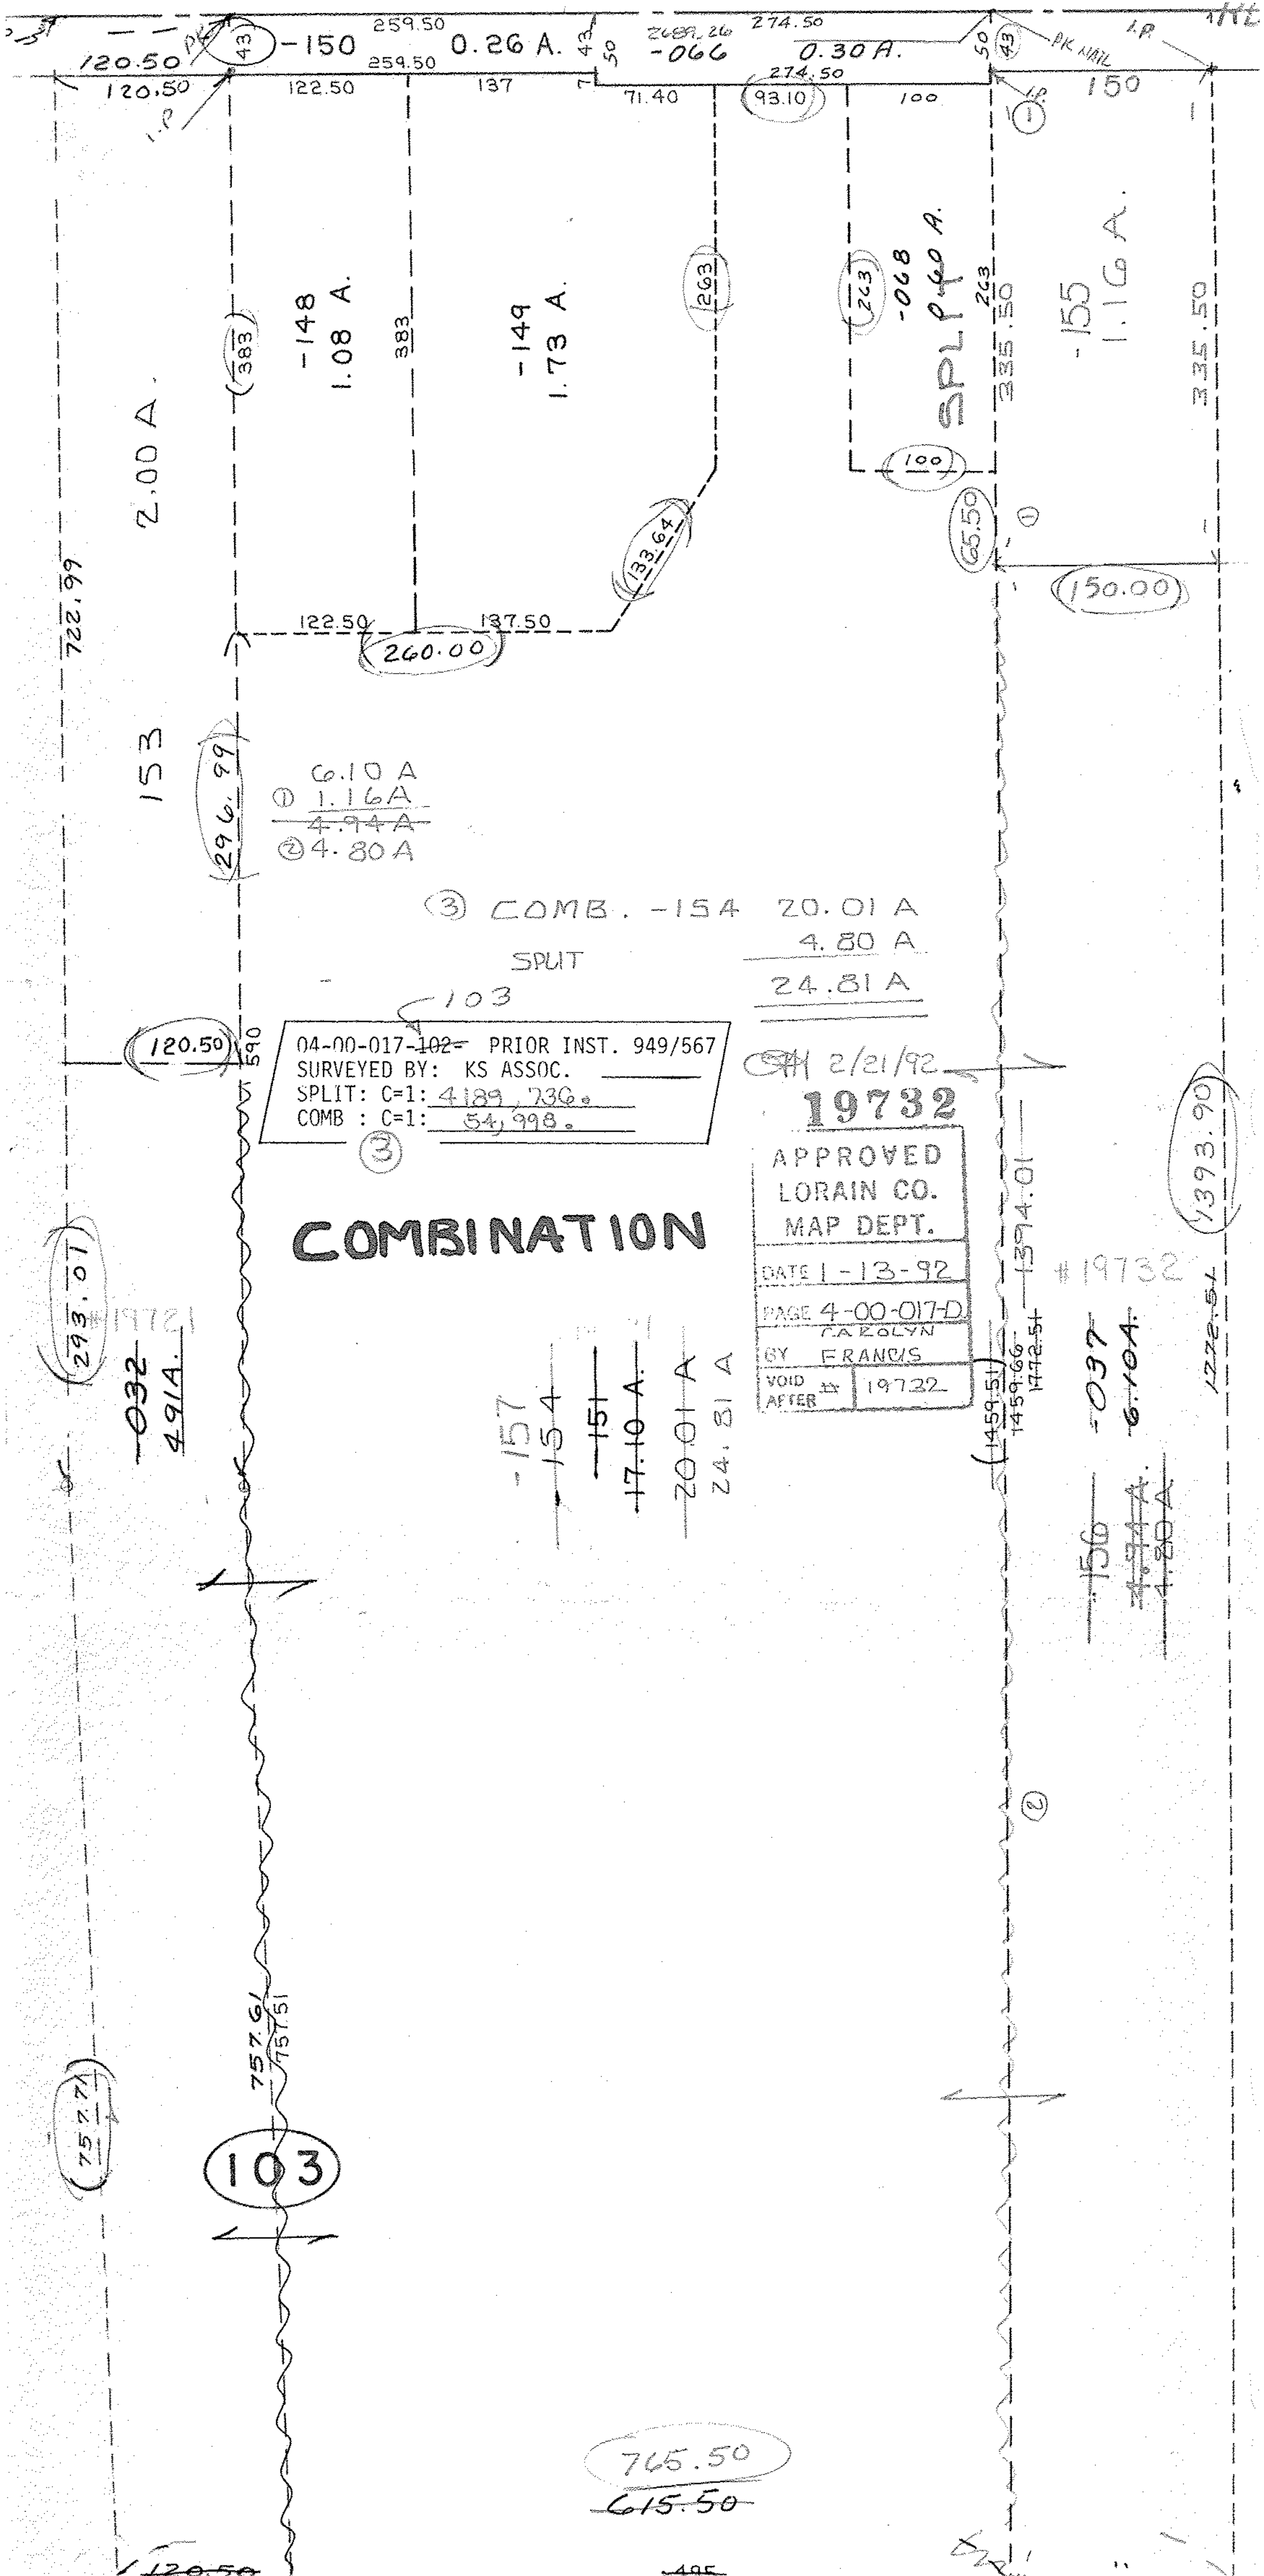
-150
0.26 A.
259.50
120.50
122.50
137
71.40
-066
0.30 A.
274.50
93.10
100
PK NAIL
I.P.
150
-148
1.08 A.
-149
1.73 A.
383
263
-068
SPLIT
-155
1.16 A.
335.50
2.00 A.
722.99
153
296.99
6.10 A
1.16A
4.94A
4.80 A
100
65.50
150.00
122.50
137.50
260.00
133.64
COMB. -154 20.01 A
4.80 A
24.81 A
SPLIT
103
120.50
590
04-00-017-102- PRIOR INST. 949/567
SURVEYED BY: KS ASSOC.
SPLIT: C=1: 4189,736.
COMB : C=1: 54,998.
3
COMBINATION
2/21/92
19732
APPROVED
LORAIN CO.
MAP DEPT.
DATE 1-13-92
PAGE 4-00-017-D
BY CAROLYN FRANCIS
VOID AFTER 19732
1394.01
1459.51
1772.51
1393.90
293.01
#19732
-032
4914.
-157
-154
-151
17.10 A.
20.01 A
24.81 A
-037
6.104.
-156
4.80 A.
757.61
757.51
757.71
103
765.50
615.50