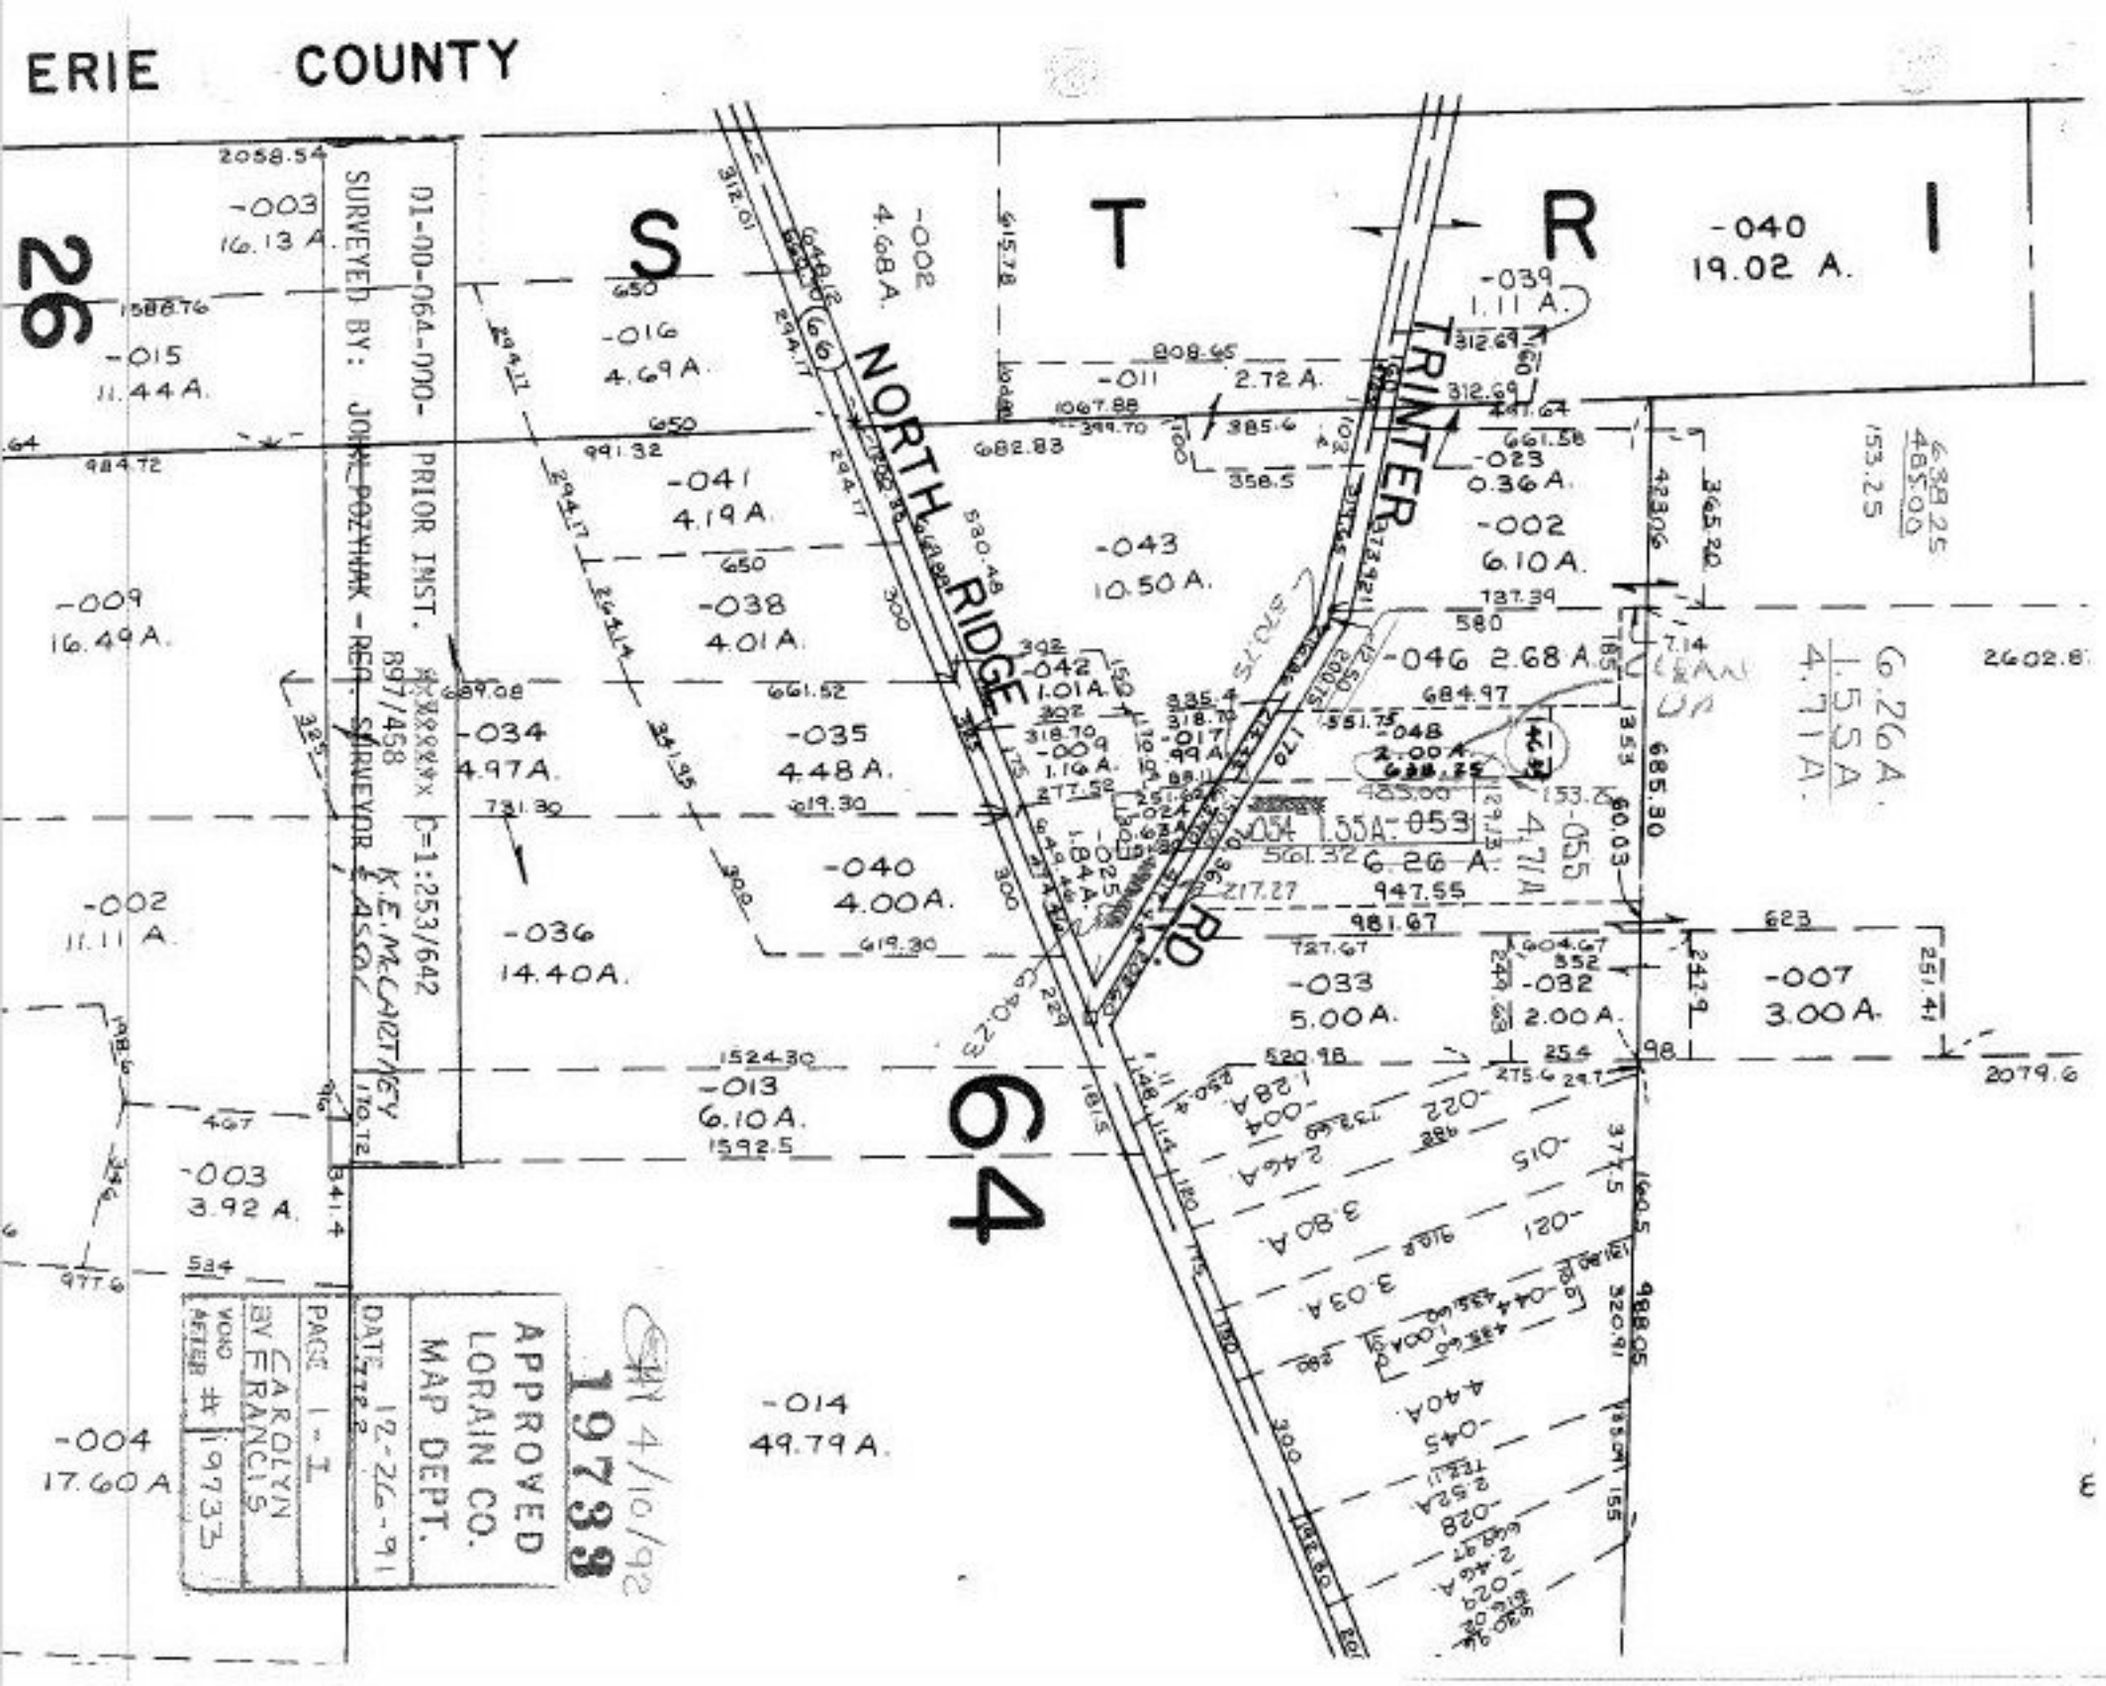
ERIE COUNTY
26
64
S T R I
NORTH RIDGE RD.
TRIMTER RD.
01-00-064-000-
PRIOR INST. #
897/458
SURVEYED BY: JOHN POZYHAK - REG. SURVEYOR #
K.E. McCARTNEY & ASSOC.
-003 16.13 A.
-015 11.44 A.
-009 16.49 A.
-002 11.11 A.
-003 3.92 A.
-004 17.60 A.
-002 4.68 A.
-016 4.69 A.
-041 4.19 A.
-038 4.01 A.
-034 4.97 A.
-036 14.40 A.
-013 6.10 A.
-014 49.79 A.
-043 10.50 A.
-035 4.48 A.
-040 4.00 A.
-042 1.01 A.
-025 1.84 A.
-011 2.72 A.
-039 1.11 A.
-040 19.02 A.
-023 0.36 A.
-002 6.10 A.
-046 2.68 A.
-048 2.00 A.
-054 1.55A.
-053 6.26 A.
-055 4.71 A.
6.26 A. 1.55A 4.71 A.
-033 5.00 A.
-032 2.00 A.
-007 3.00 A.
APPROVED
LORAIN CO.
MAP DEPT.
DATE 12-26-91
PAGE 1 - I
BY CAROLYN FRANCIS
VOID AFTER # 19733
4/10/92
19738