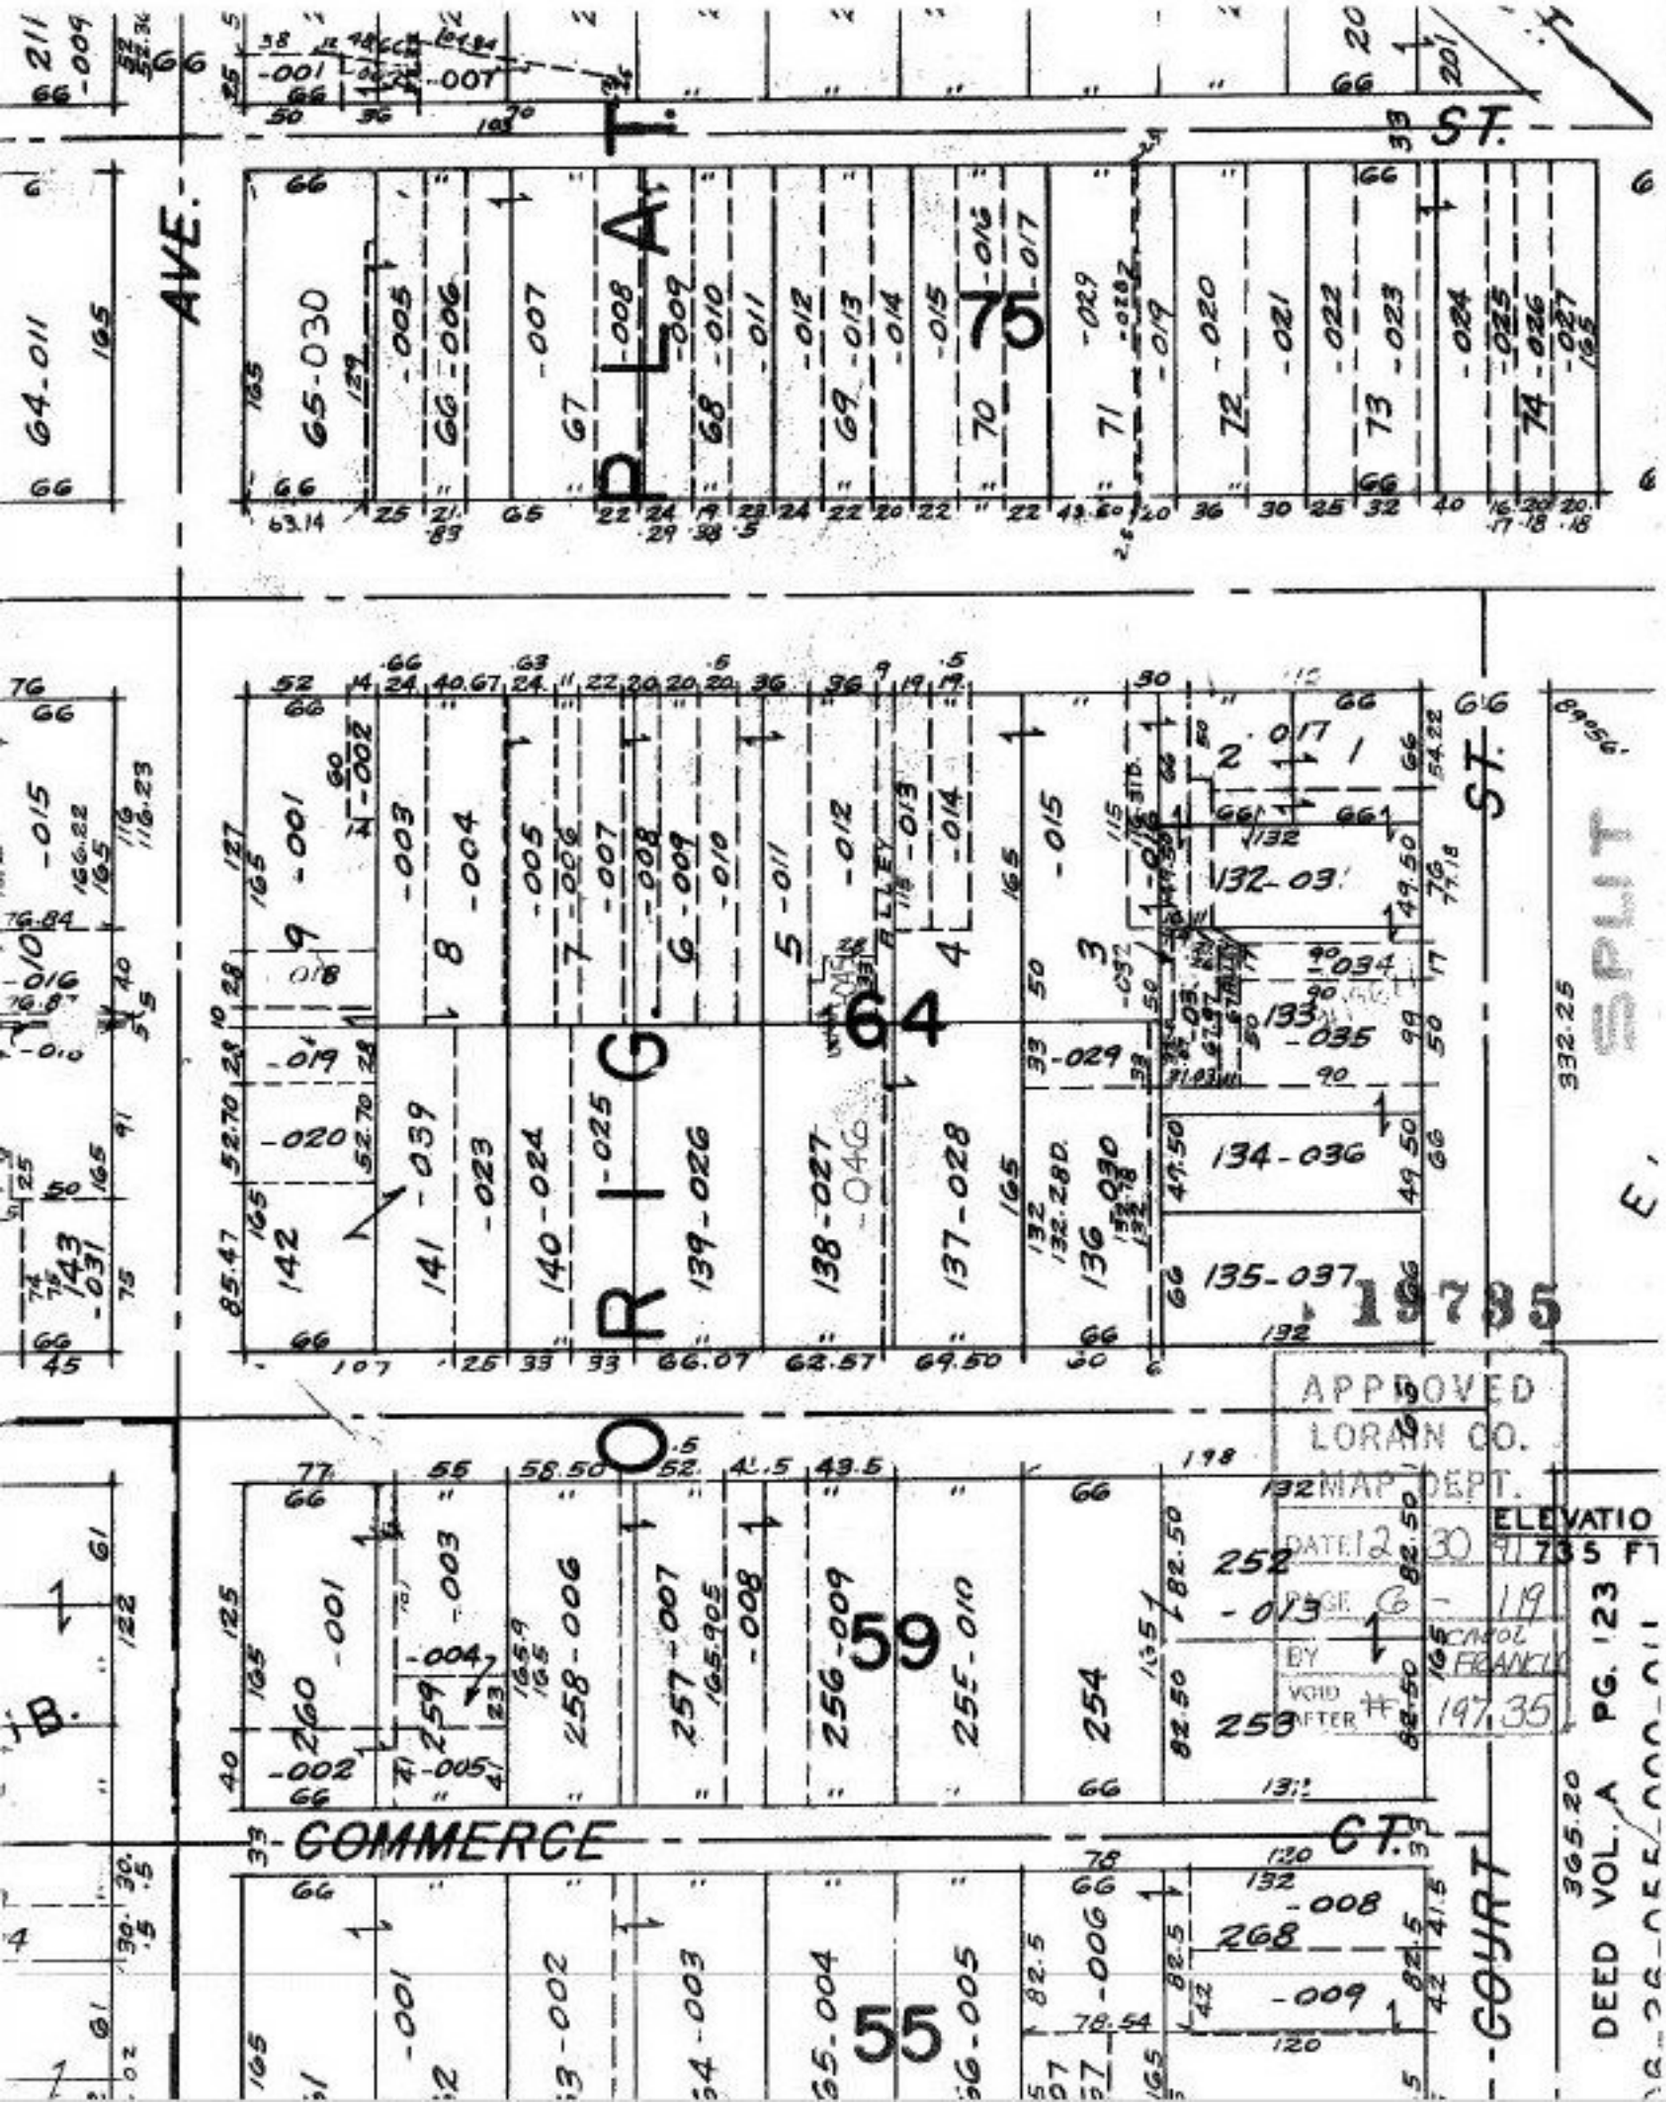

ST.
AVE.
PLAT
75
ORIG
64
59
55
COMMERCE
CT.
COURT
SPLIT
ELEVATIO
735 FT
DEED VOL. A PG. 123
19785
APPROVED
LORAIN CO.
MAP DEPT.
DATE 12 30 91
PAGE 6 - 119
BY
VOID AFTER
197.35