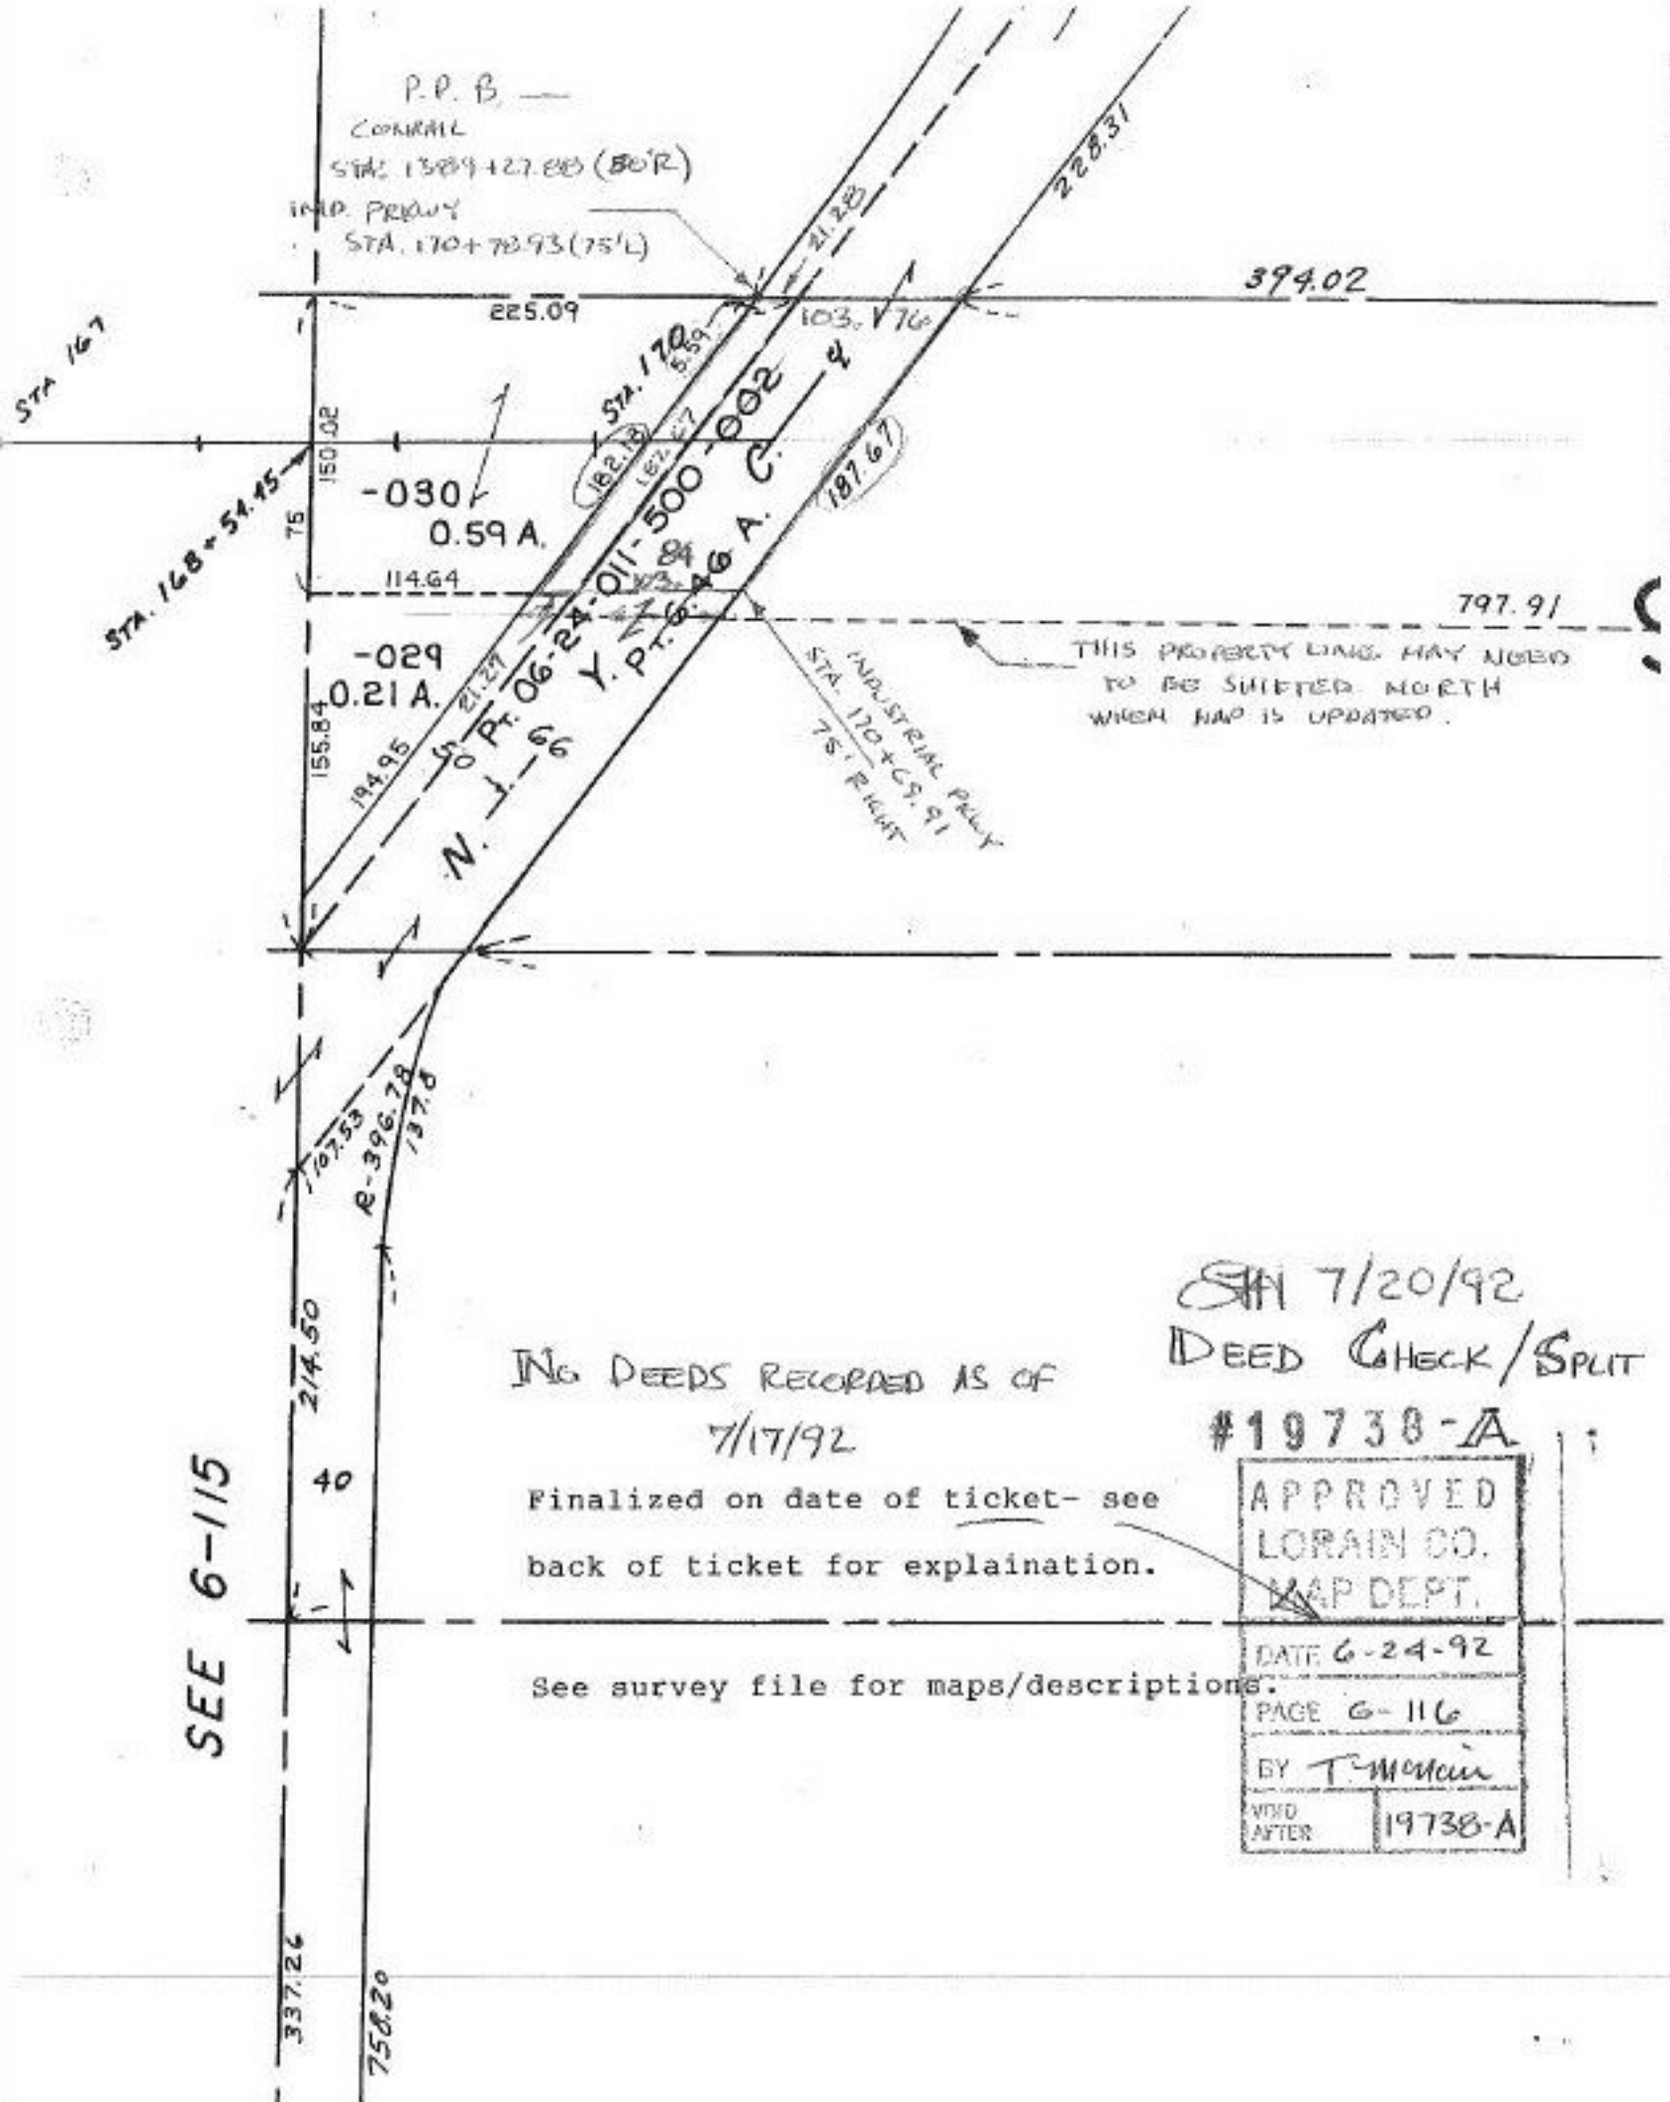

SH 7/20/92
DEED CHECK/SPLIT
#19738-A

NO DEEDS RECORDED AS OF 7/17/92

Finalized on date of ticket- see back of ticket for explaination.

See survey file for maps/descriptions.

APPROVED
LORAIN CO.
MAP DEPT.
DATE 6-24-92
PAGE 6-116
BY T. McClain
VOID AFTER 19738-A