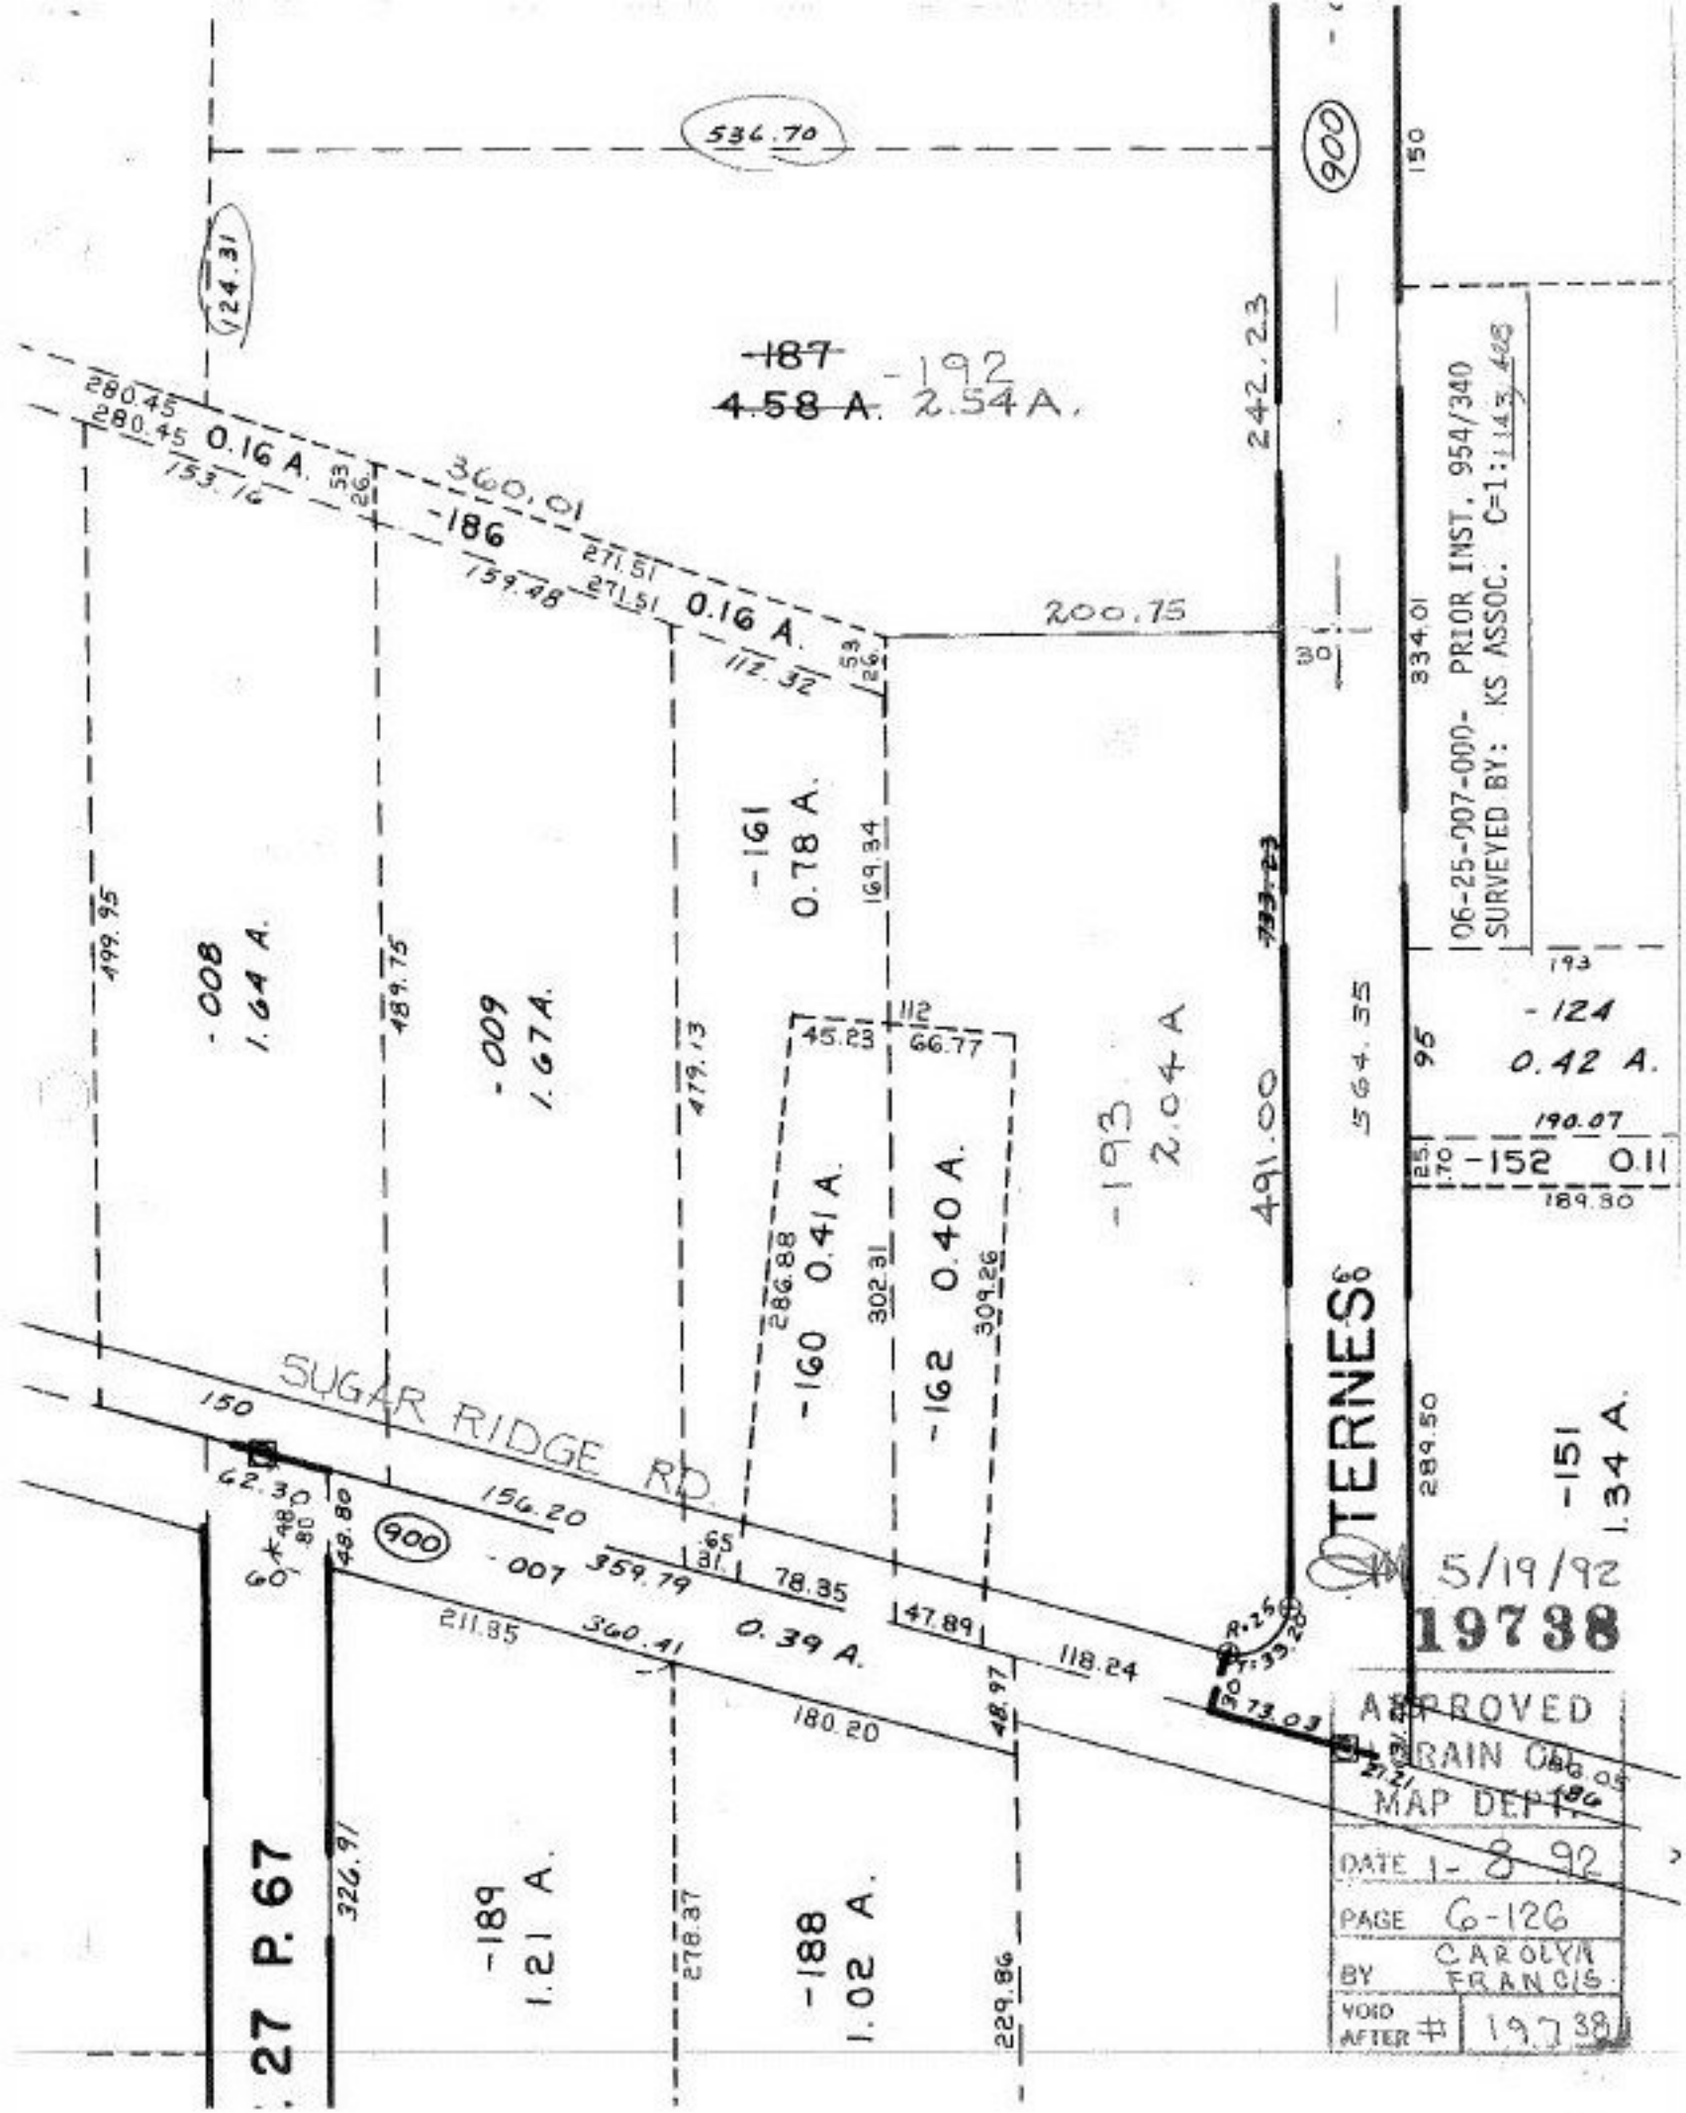

536.70
124.31
900
150
242.23
~~187~~ -192
~~4.58 A.~~ 2.54 A.
280.45
280.45
0.16 A.
153.16
53
26
360.01
-186
271.51
159.48
271.51
0.16 A.
112.32
53
26
200.75
30
334.01
06-25-007-000- PRIOR INST. 954/340
SURVEYED BY: KS ASSOC. C=1:1143.428
-161
0.78 A.
169.34
499.95
-008
1.64 A.
489.75
-009
1.67 A.
479.13
45.23
112
66.77
-193
2.04 A
491.00
564.35
193
-124
0.42 A.
95
190.07
25.70
-152
0.11
189.30
286.88
-160
0.41 A.
302.31
-162
0.40 A.
309.26
SUGAR RIDGE RD.
150
62.30
48.80
48.80
60
156.20
900
-007
359.79
.65
31
78.35
47.89
118.24
211.85
360.41
0.39 A.
180.20
48.97
73.03
289.50
-151
1.34 A.
TERNES
5/19/92
19738
APPROVED
DRAIN CO.
MAP DEPT.
DATE 1-8-92
PAGE 6-126
BY CAROLYN FRANCIS
VOID AFTER # 19738
326.91
-189
1.21 A.
278.37
-188
1.02 A.
229.86
27 P. 67