CITY ORD.

36-65

66-6

1974

APPROVED
LORAIN CO.
MAP DEPT.
DATE 7-26-68
5-00-061-A..
BY Kolbert

7-14-86 88.

9/25/68 R.K.

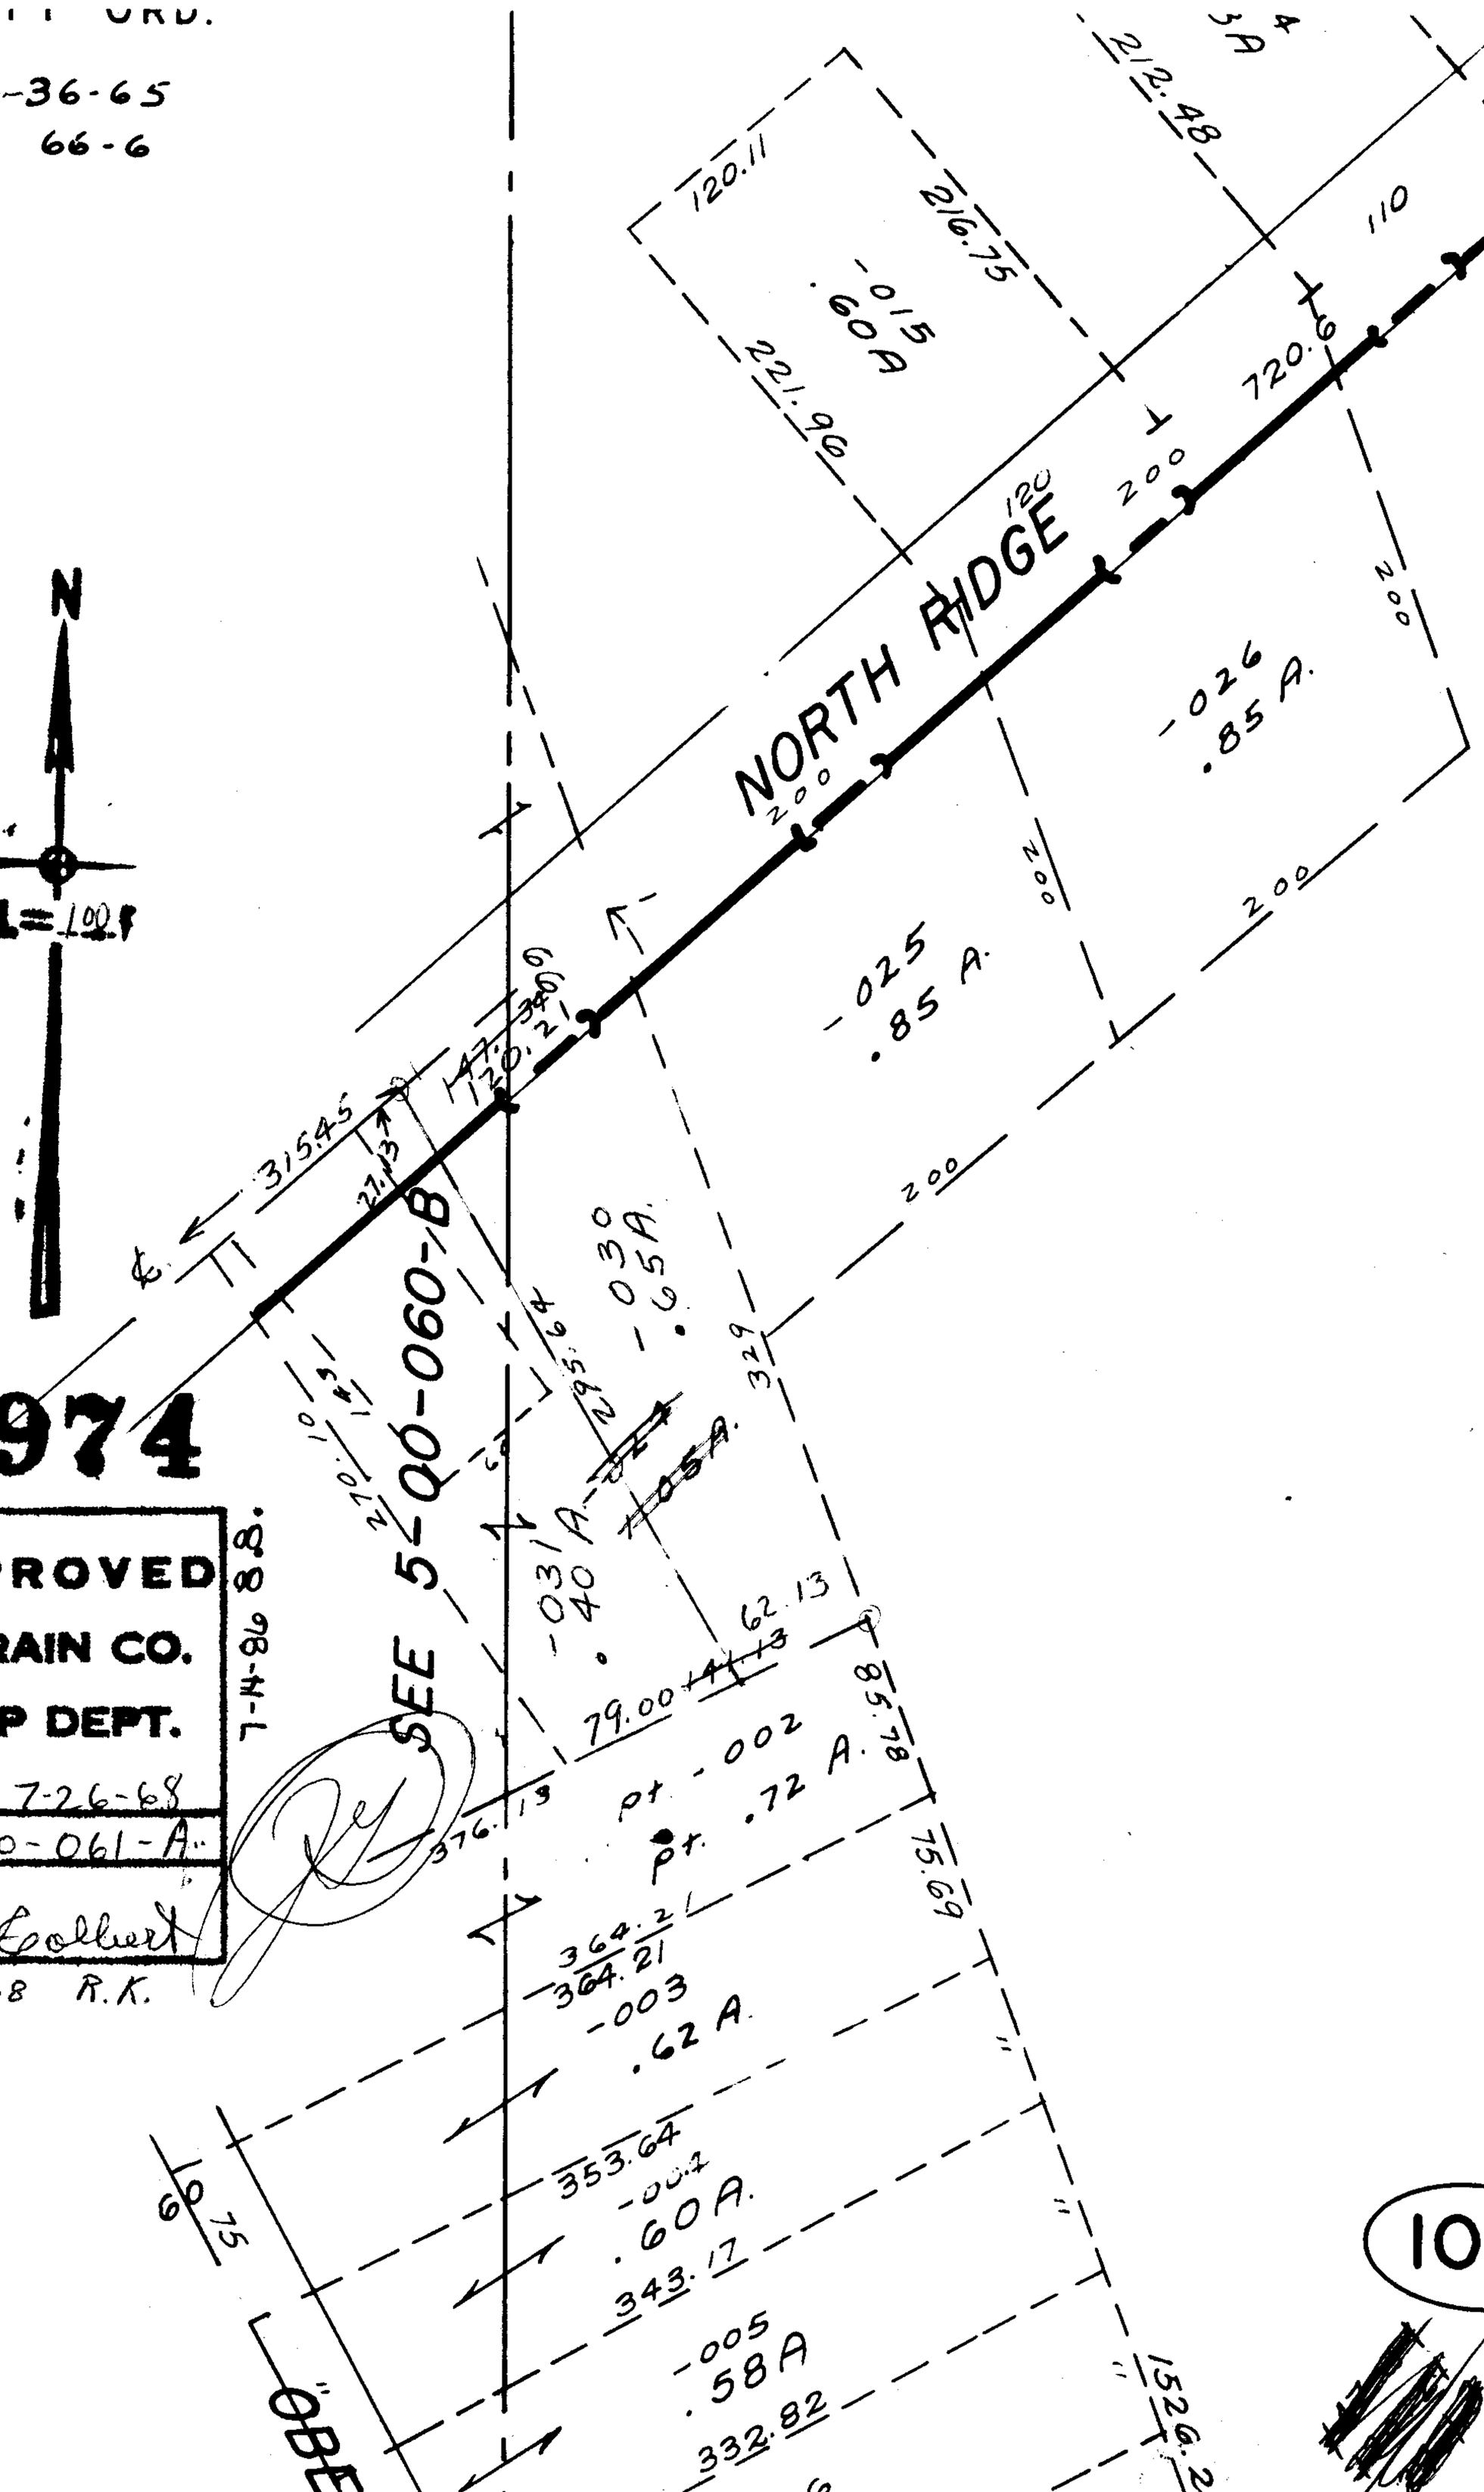

104