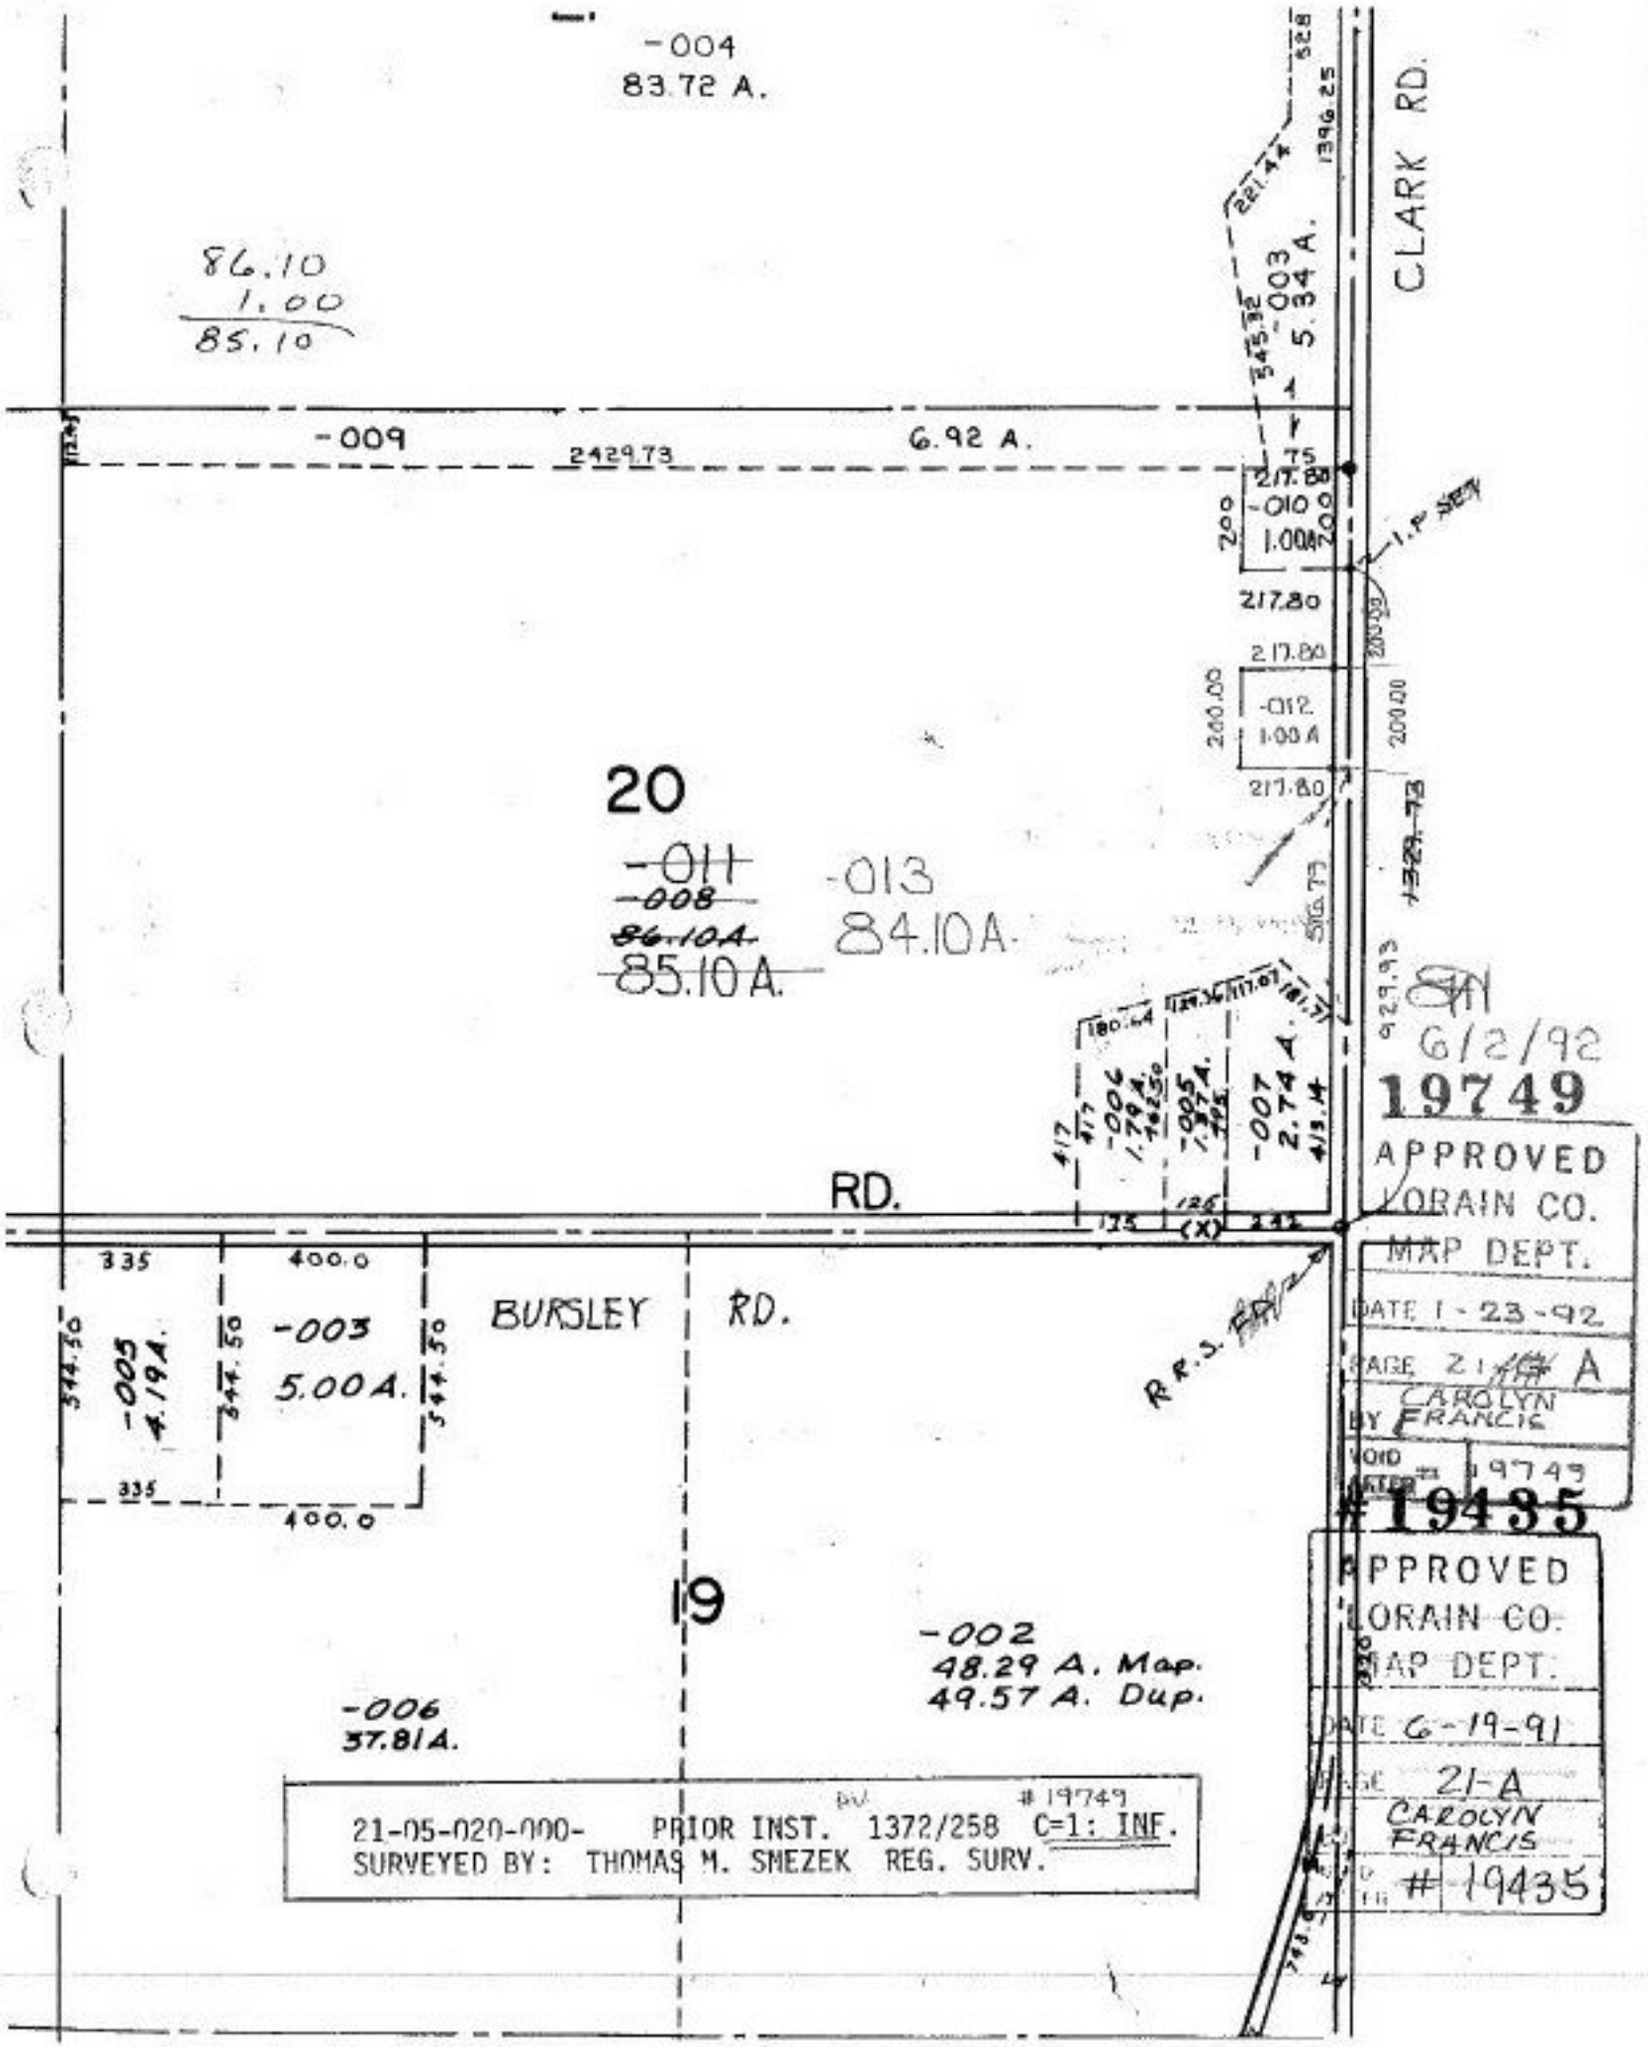
-004
83.72 A.
86.10
1.00
85.10
CLARK RD.
-003
5.34 A.
-009
6.92 A.
2429.73
-010
1.00A
217.80
200.00
-012
1.00 A
20
-011
-008
86.10A
85.10 A.
-013
84.10A
-006
1.79 A.
-005
1.37 A.
-007
2.74 A.
RD.
BURSLEY RD.
-005
4.19A.
-003
5.00A.
335
400.0
344.50
19
-002
48.29 A. Map.
49.57 A. Dup.
-006
37.81A.
21-05-020-000- PRIOR INST. 1372/258 C=1: INF.
SURVEYED BY: THOMAS M. SMEZEK REG. SURV.
6/2/92
19749
APPROVED
LORAIN CO.
MAP DEPT.
DATE 1-23-92
PAGE 21-A
BY CAROLYN FRANCIS
VOID AFTER # 19749
#19435
APPROVED
LORAIN CO.
MAP DEPT.
DATE 6-19-91
PAGE 21-A
BY CAROLYN FRANCIS
VOID AFTER # 19435