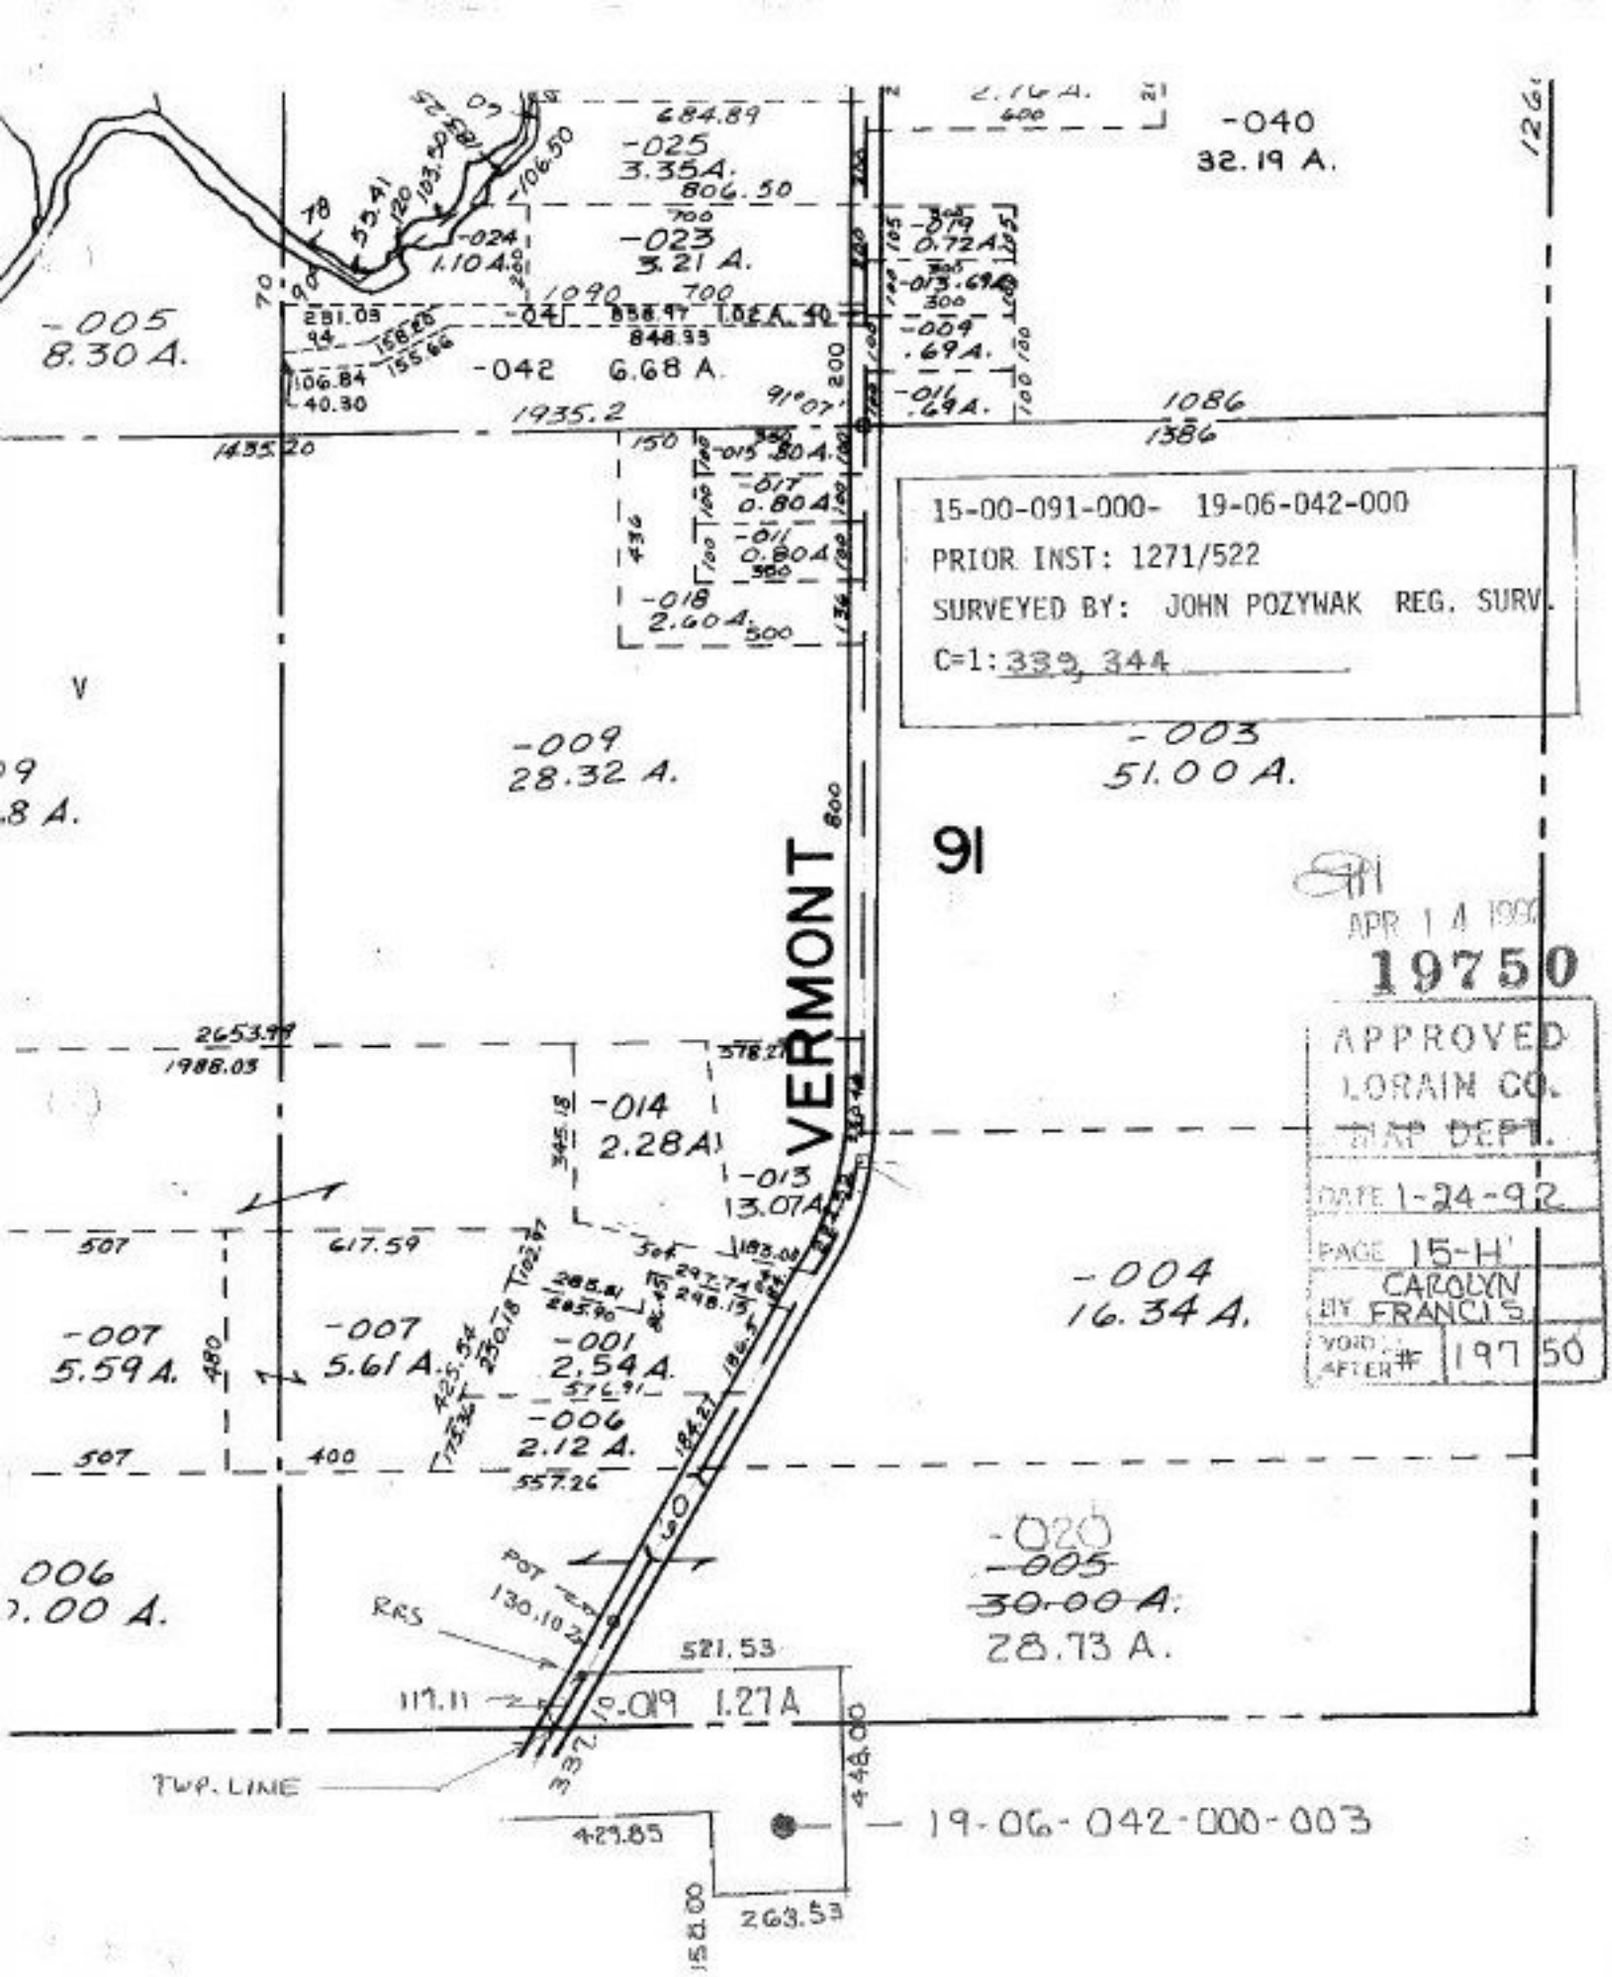
-040
32.19 A.
-025
3.35A.
-024
1.10A.
-023
3.21 A.
-005
8.30 A.
-042
6.68 A.
-009
28.32 A.
-003
51.00 A.
-004
16.34 A.
-014
2.28A
-013
13.07A
-007
5.59 A.
-007
5.61 A.
-001
2.54 A.
-006
2.12 A.
-020
-005
30.00 A.
28.73 A.
-019 1.27A
VERMONT
91
TWP. LINE
POT
RRS
15-00-091-000- 19-06-042-000
PRIOR INST: 1271/522
SURVEYED BY: JOHN POZYWAK REG. SURV.
C=1: 339, 344
APR 14 1992
19750
APPROVED
LORAIN CO.
MAP DEPT.
DATE 1-24-92
PAGE 15-H'
BY CAROLYN FRANCIS
VOID AFTER # 19750
19-06-042-000-003