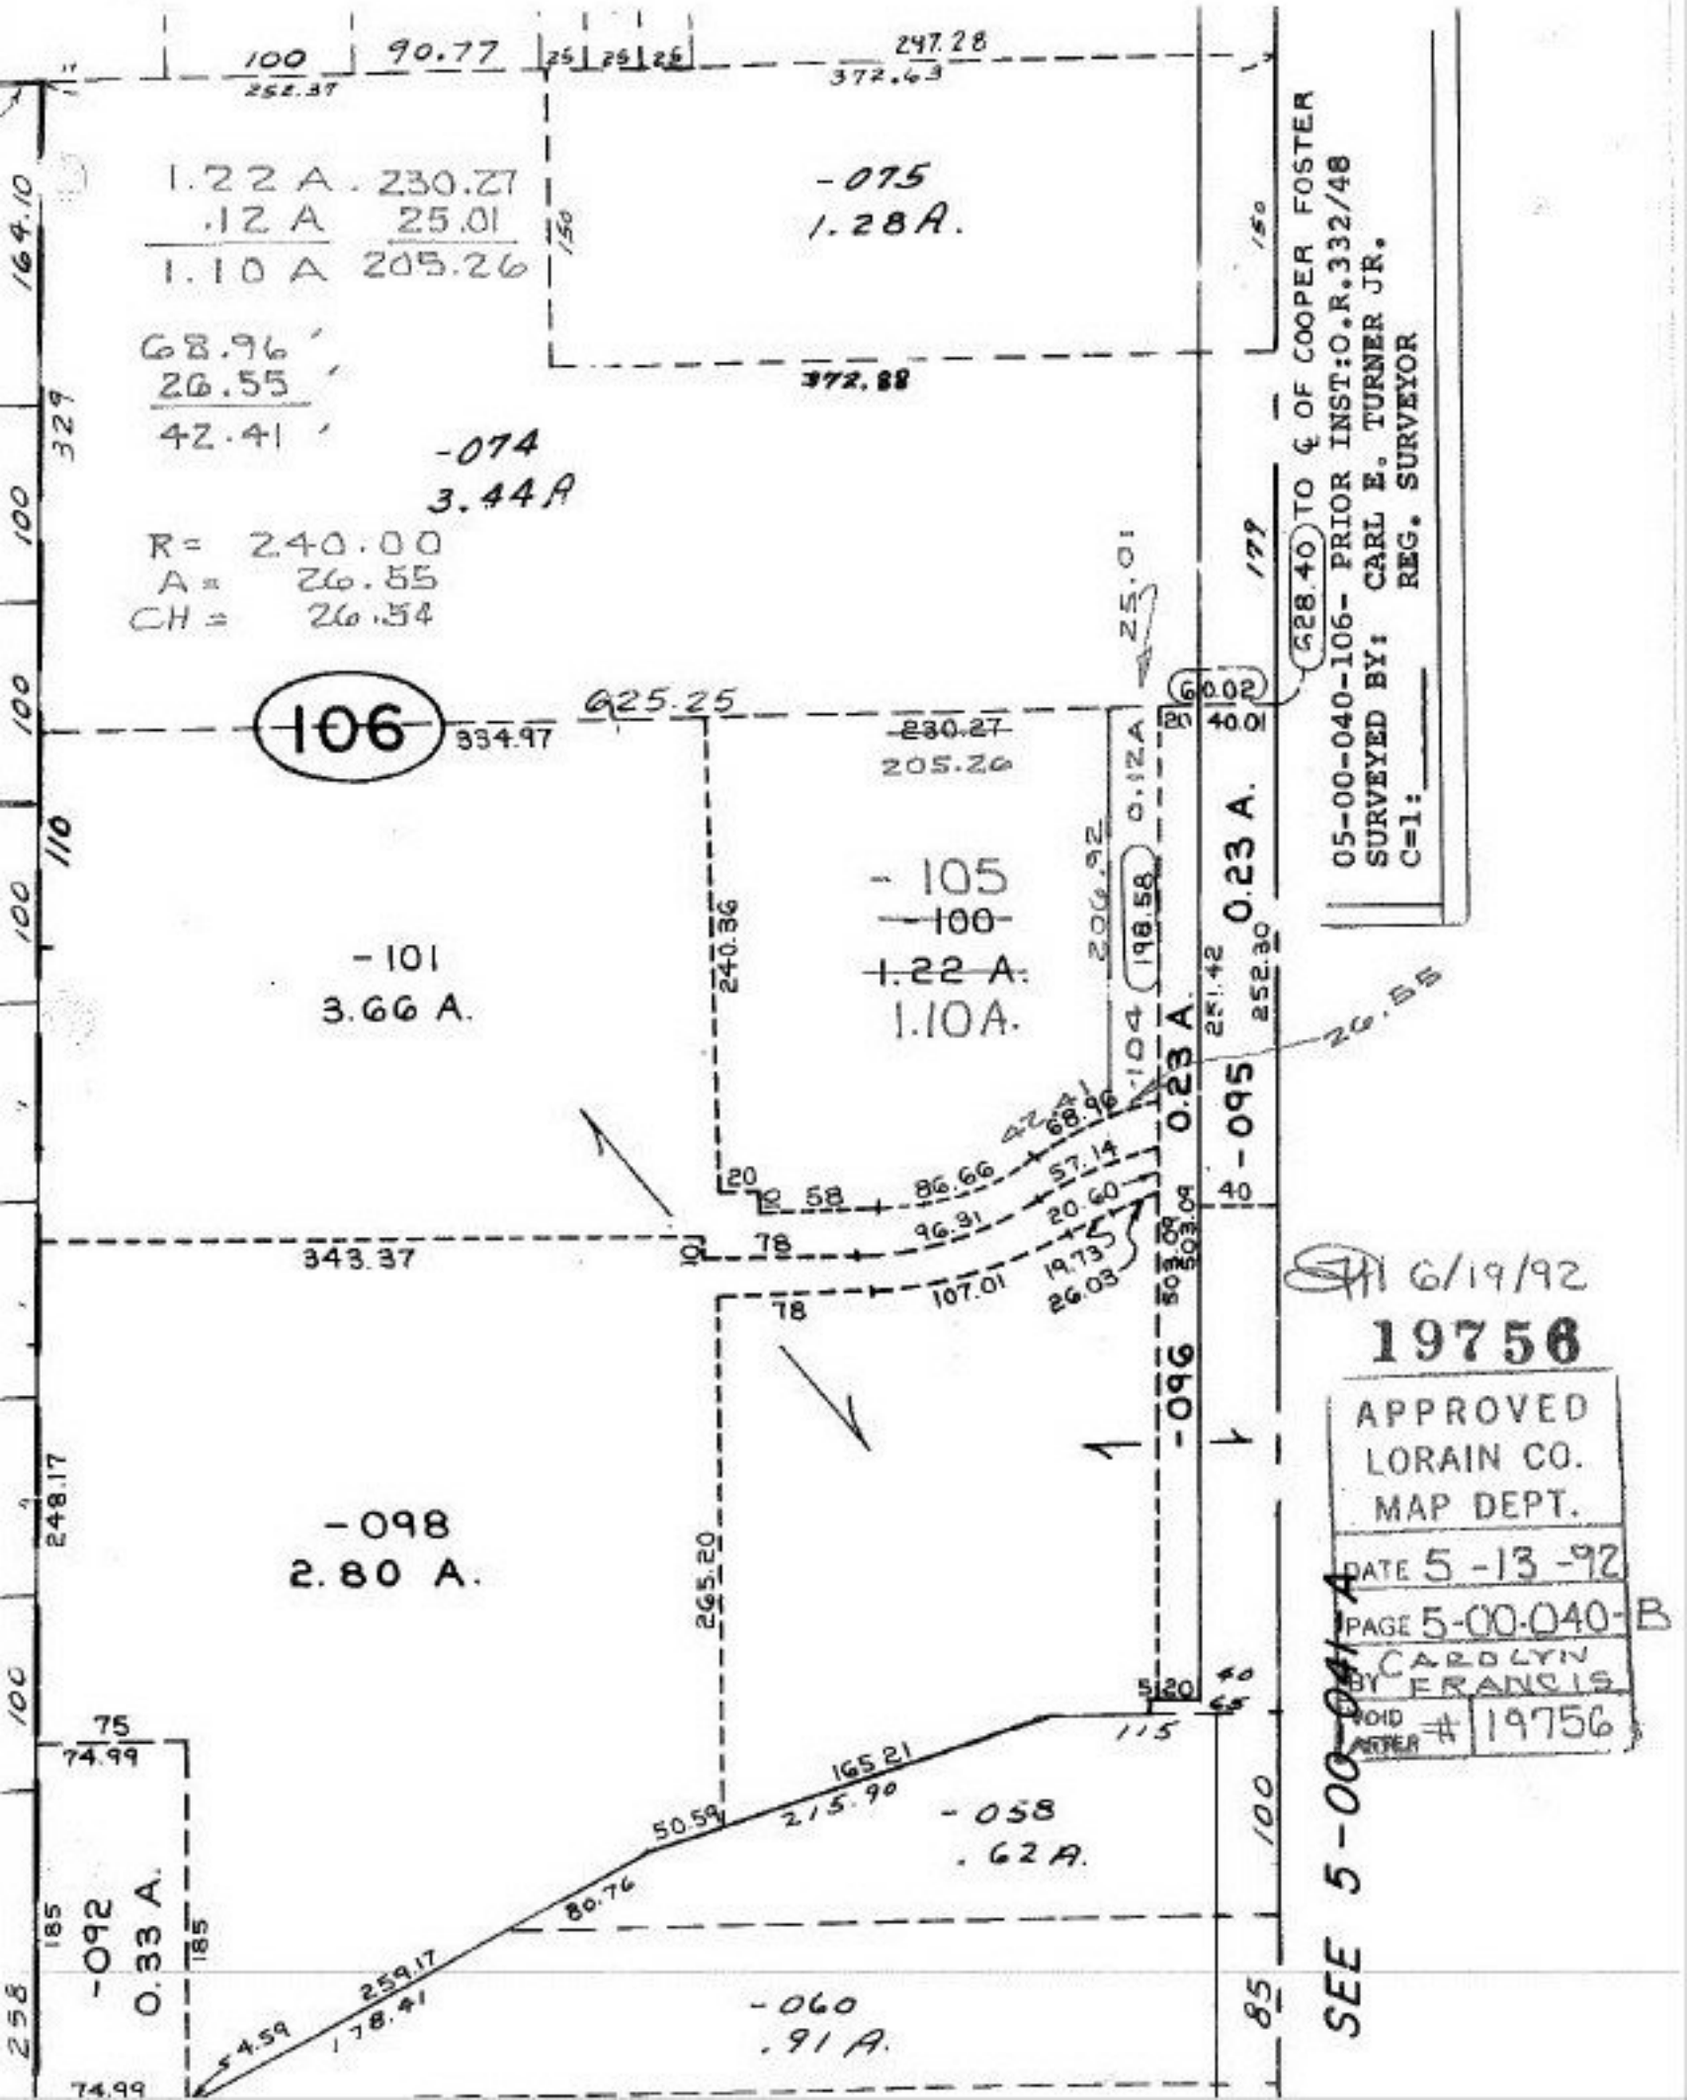

1.22 A. 230.27
.12 A 25.01
1.10 A 205.26
68.96
26.55
42.41
-075
1.28 A.
-074
3.44 A
R= 240.00
A= 26.55
CH= 26.54
106
-101
3.66 A.
-105
-100
1.22 A.
1.10 A.
-098
2.80 A.
-092
0.33 A.
-058
.62 A.
-060
.91 A.
-095
0.23 A.
-096
0.23 A.
628.40 TO ℄ OF COOPER FOSTER
05-00-040-106- PRIOR INST:O.R.332/48
SURVEYED BY: CARL E. TURNER JR.
C=1: REG. SURVEYOR
6/19/92
19756
APPROVED
LORAIN CO.
MAP DEPT.
DATE 5-13-92
PAGE 5-00-040-B
BY CAROLYN FRANCIS
VOID AFTER # 19756
SEE 5-00-041-A