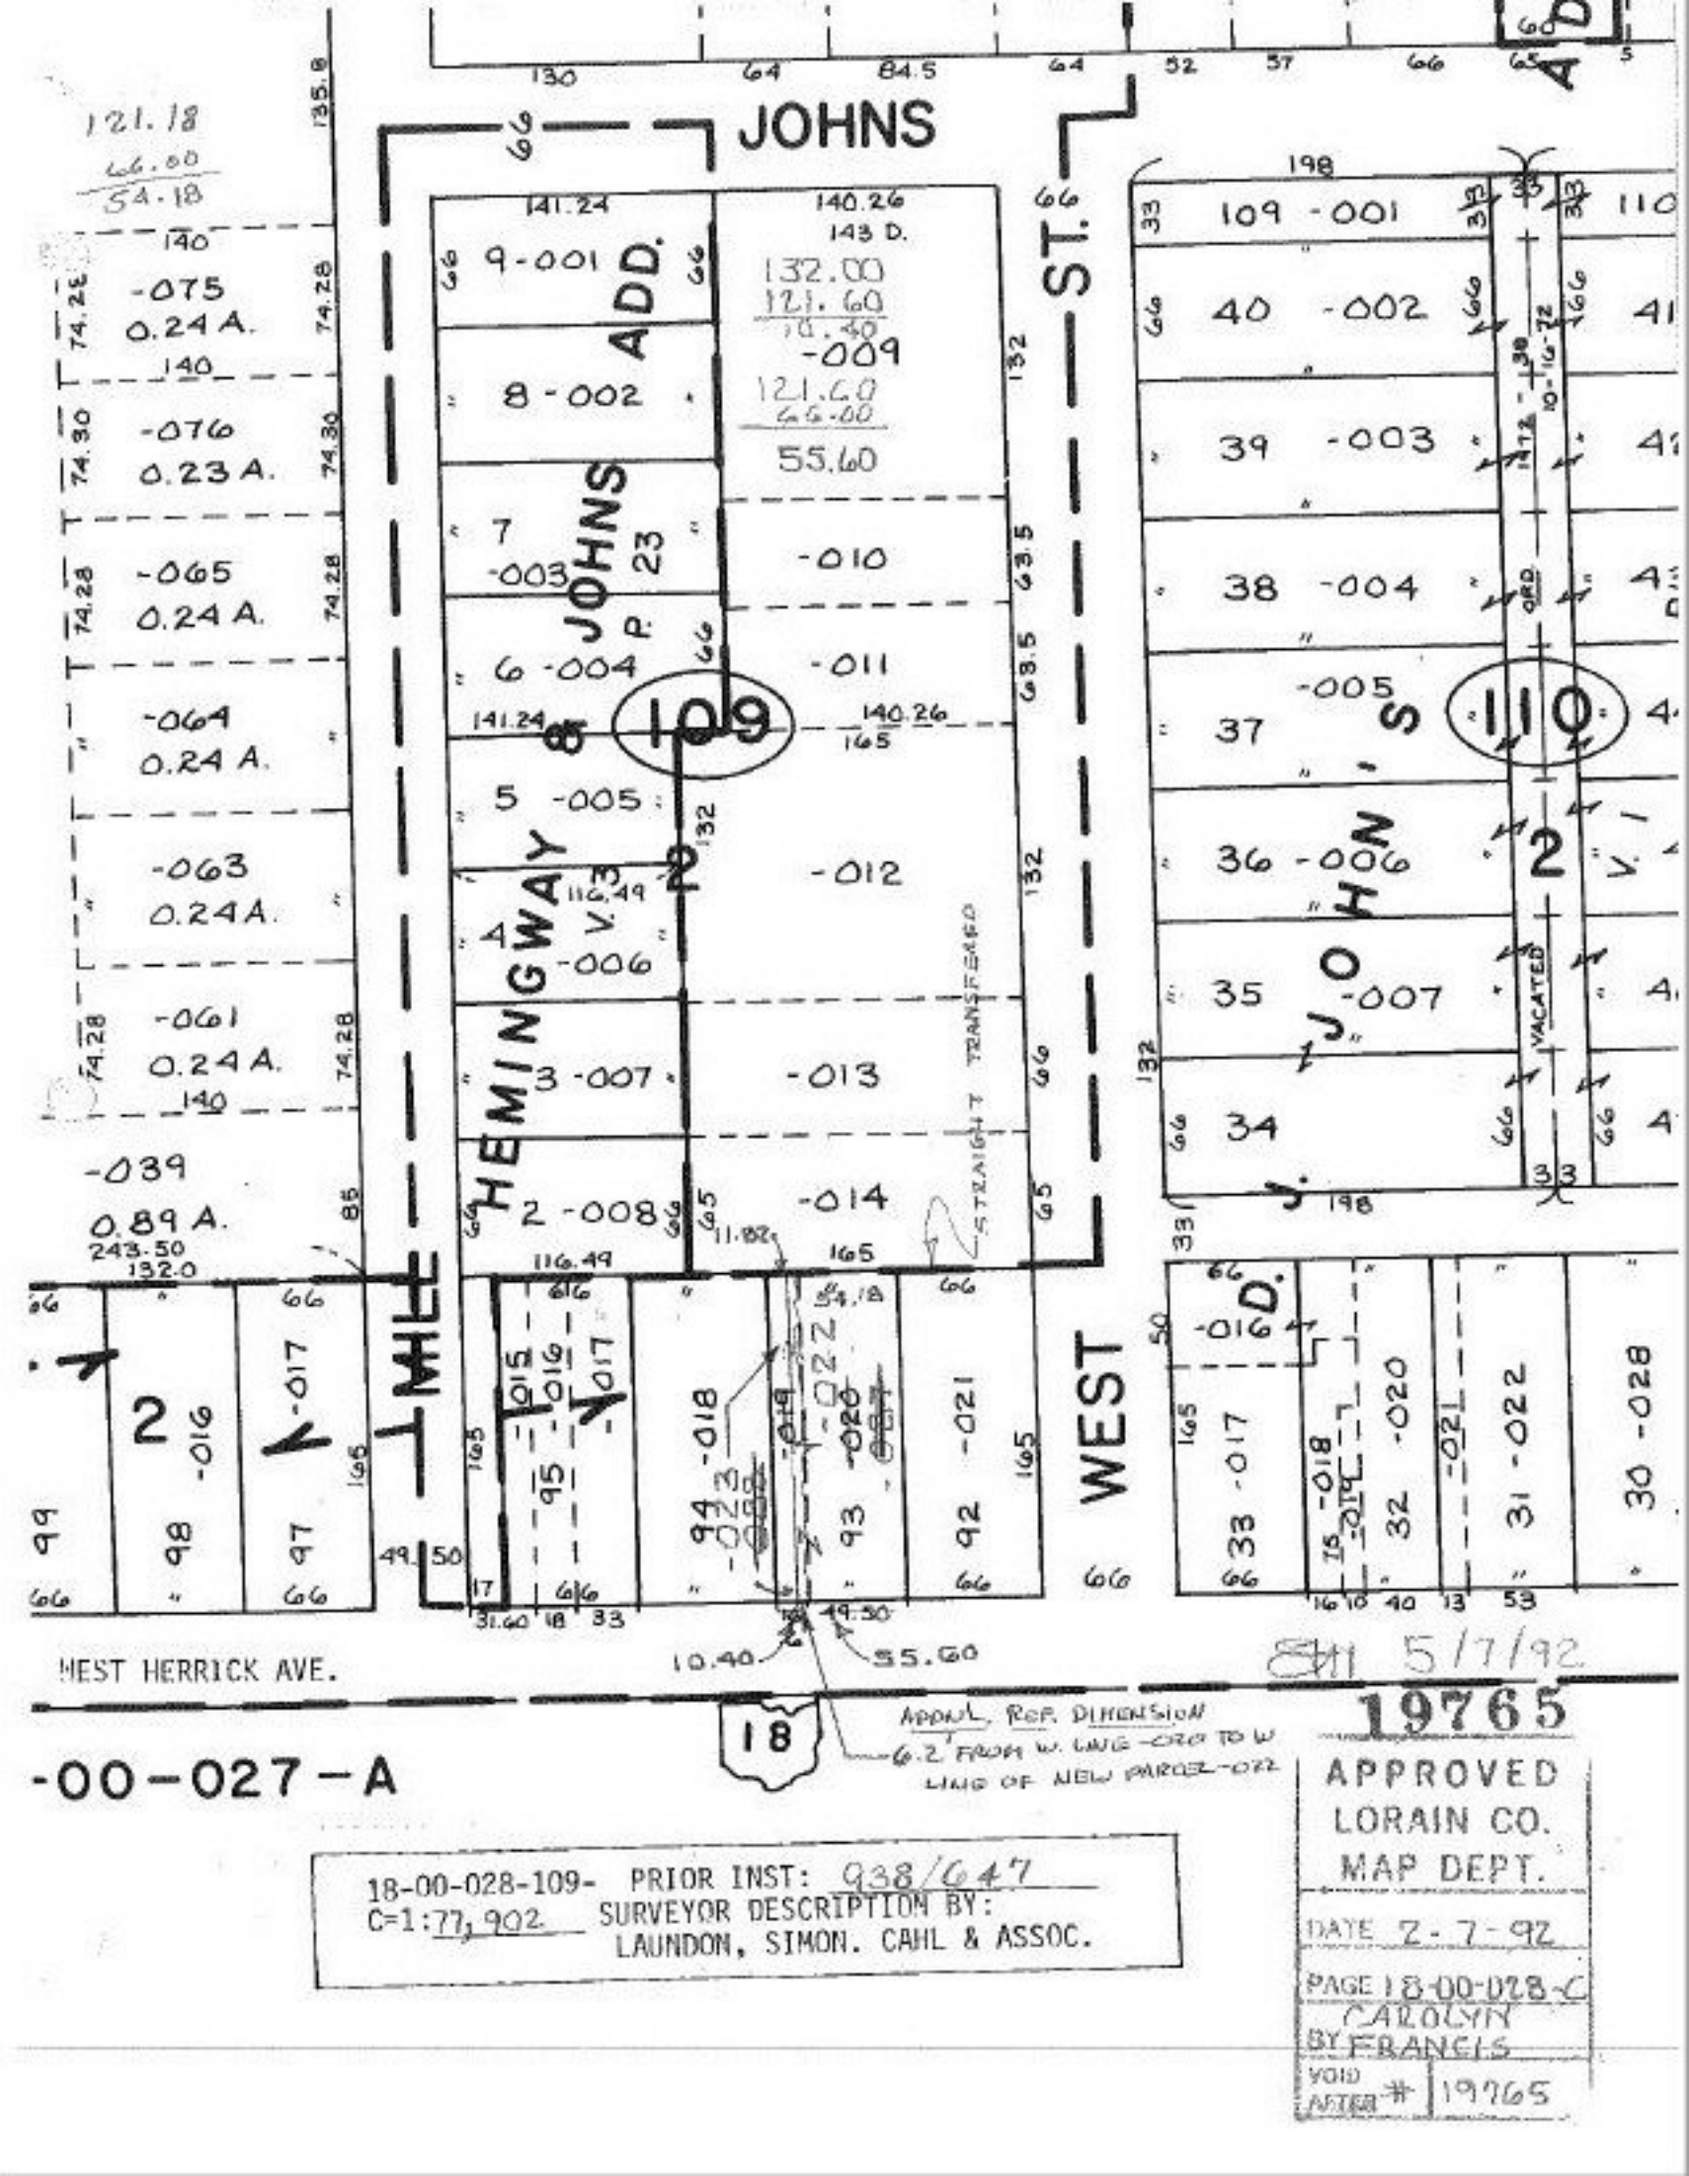
JOHNS
HEMINGWAY
WEST
ST.
ADD.
JOHNS
P.
23
V.
2
109
-001
40 -002
39 -003
38 -004
37 -005
36 -006
35 -007
34
9-001
8-002
7 -003
6 -004
5 -005
4 -006
3 -007
2 -008
-075 0.24 A.
-076 0.23 A.
-065 0.24 A.
-064 0.24 A.
-063 0.24 A.
-061 0.24 A.
-039 0.89 A.
-009
-010
-011
-012
-013
-014
-016
-017
-018
-020
-021
-022
VACATED
STRAIGHT TRANSFER
WEST HERRICK AVE.
18
APPROL. REF. DIMENSION
6.2' FROM W. LINE -020 TO W LINE OF NEW PARCEL -022
5/7/92
19765
-00-027-A
18-00-028-109- PRIOR INST: 938/647
C=1:77,902 SURVEYOR DESCRIPTION BY:
LAUNDON, SIMON. CAHL & ASSOC.
APPROVED
LORAIN CO.
MAP DEPT.
DATE 2-7-92
PAGE 18-00-028-C
CAROLYN
BY FRANCIS
VOID
AFTER # 19765