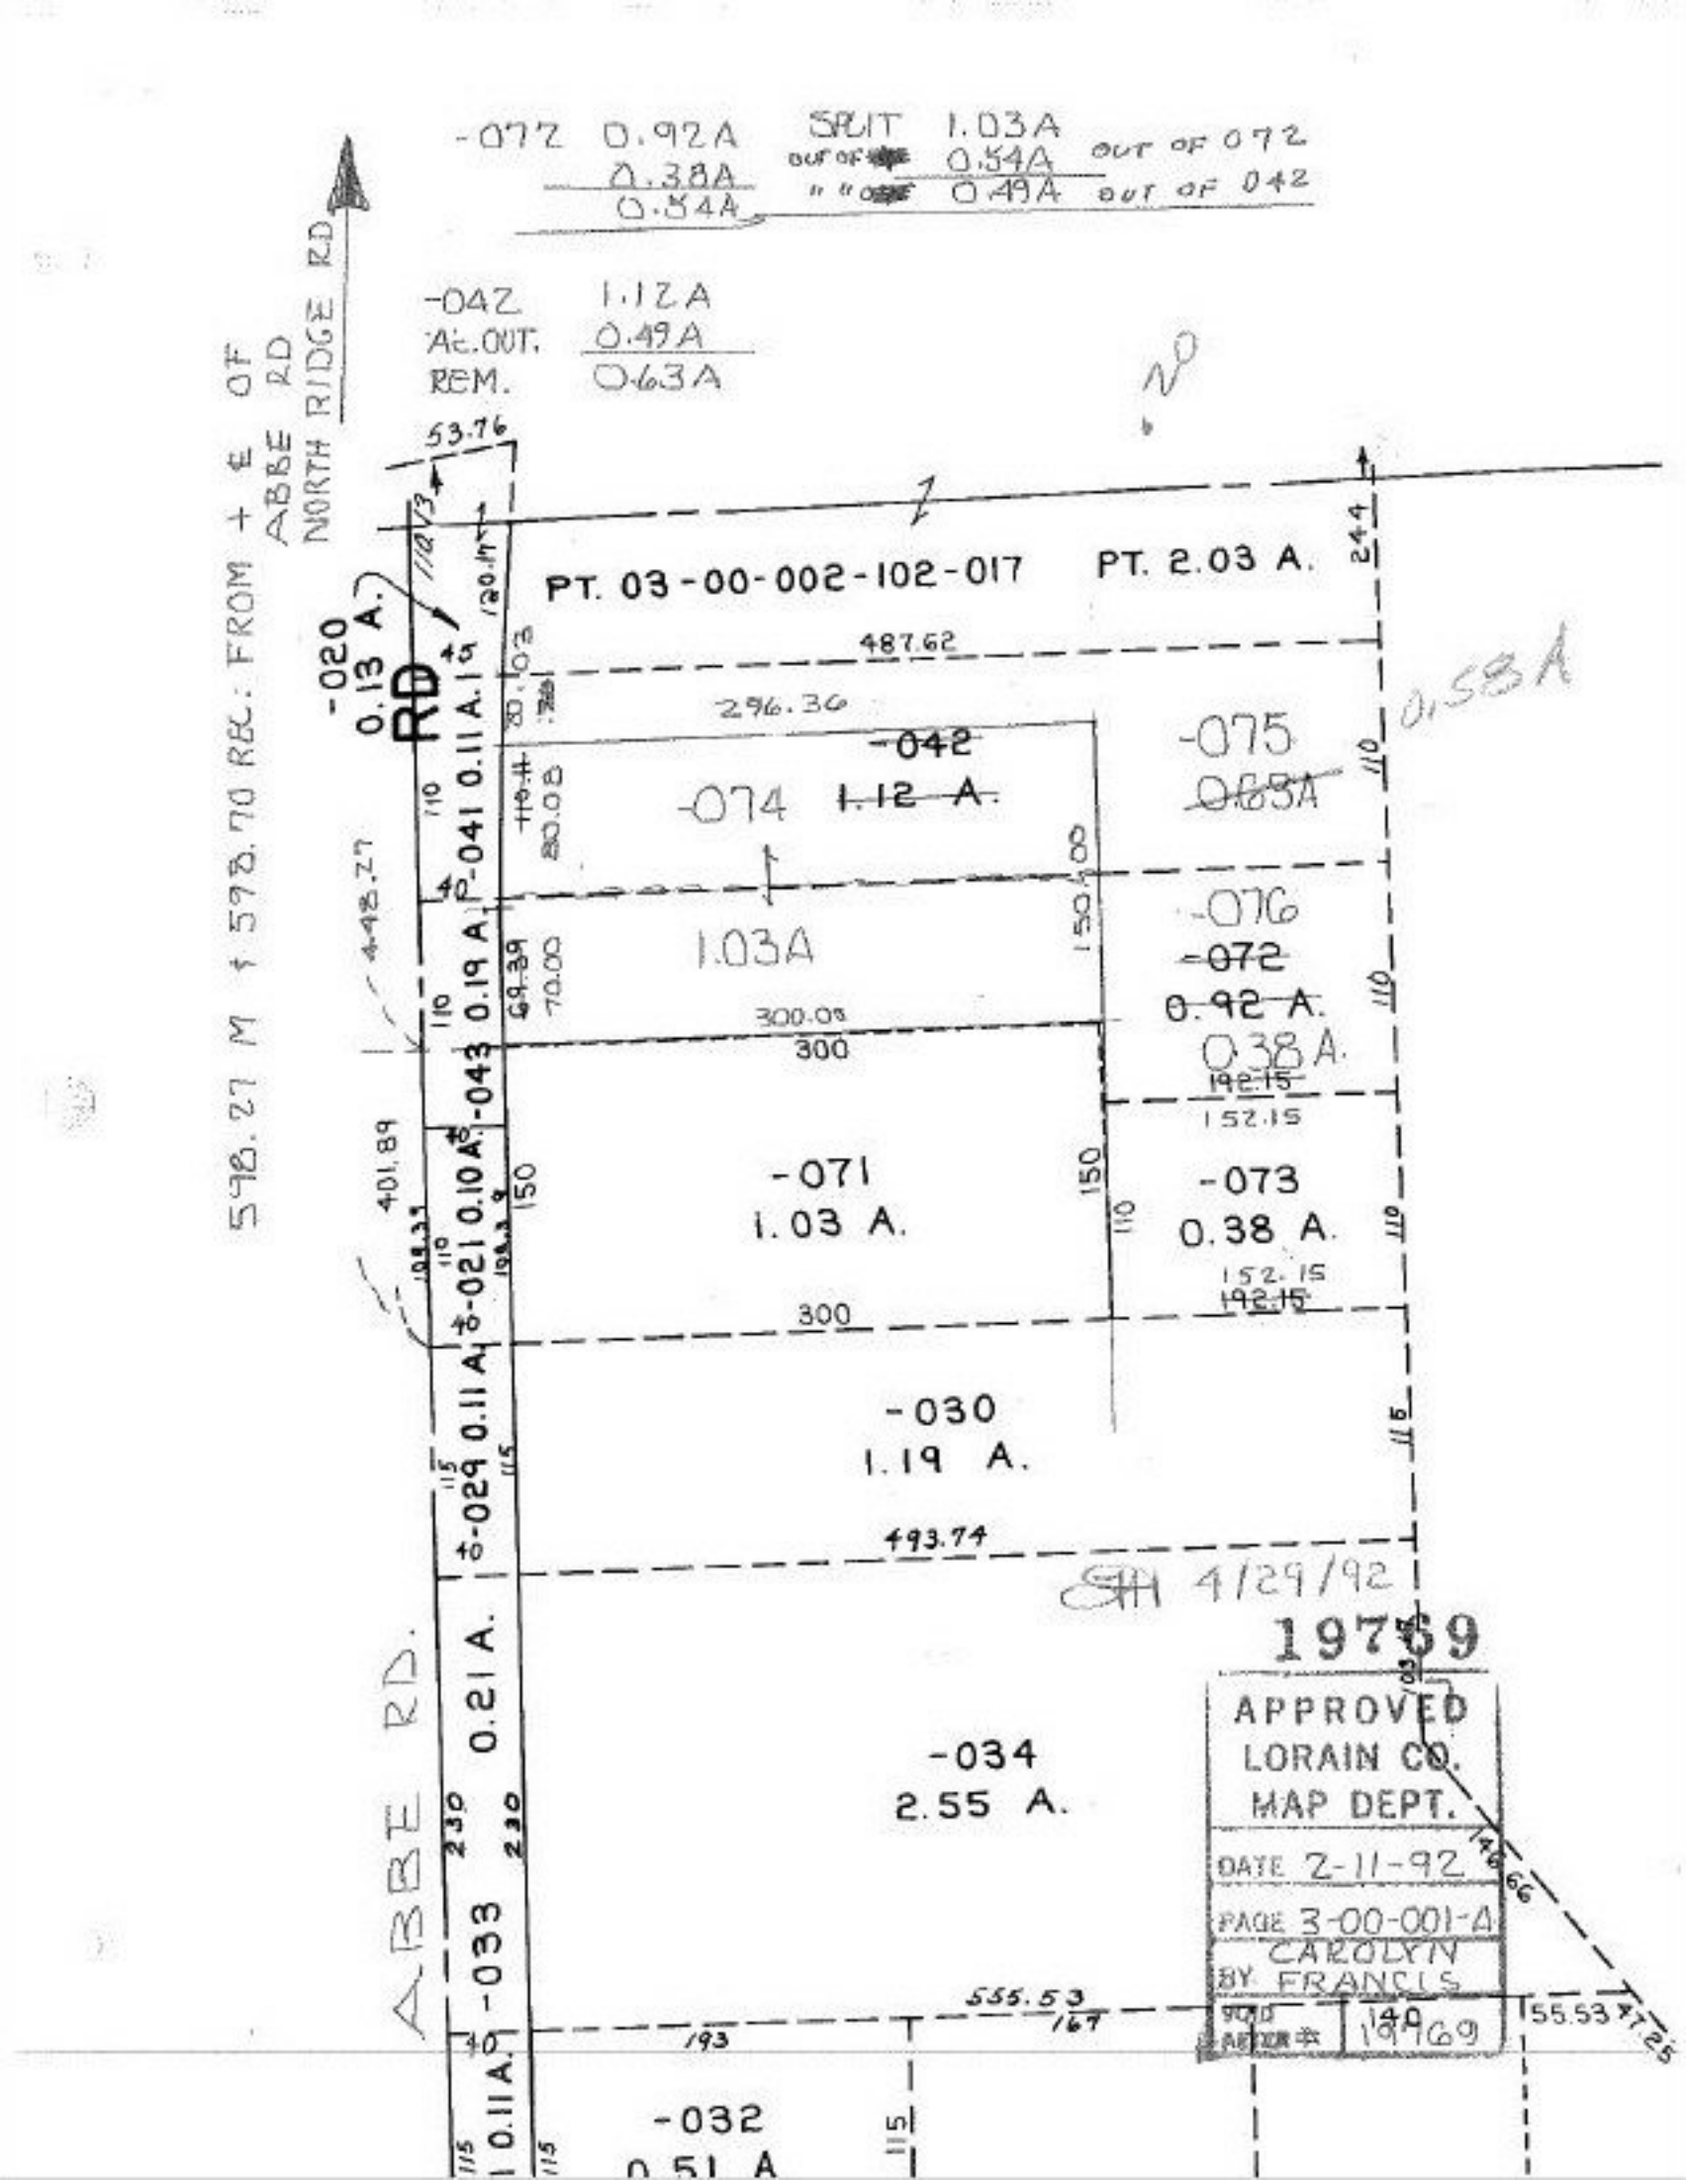
-077 0.92A
0.38A
0.54A
SPLIT 1.03A
OUT OF 0.54A OUT OF 072
" " 0.49A OUT OF 042
-042 1.12A
Ac. OUT. 0.49A
REM. 0.63A
598.27 M ± 598.70 REC. FROM ℄ OF ABBE RD
NORTH RIDGE RD
ABBE RD.
PT. 03-00-002-102-017 PT. 2.03 A.
-020 0.13 A.
RD
-041 0.11 A.
-042 1.12 A.
-074
-075 0.58A
-076
-072 0.92 A.
0.38 A.
1.03A
-043 0.19 A.
-021 0.10 A.
-071 1.03 A.
-073 0.38 A.
-030 1.19 A.
-029 0.11 A.
-034 2.55 A.
-033 0.21 A.
-032 0.51 A
0.11 A.
487.62
296.36
493.74
555.53
4/29/92
19769
APPROVED
LORAIN CO.
MAP DEPT.
DATE 2-11-92
PAGE 3-00-001-A
CAROLYN
BY FRANCIS
VOID AFTER #
19769