
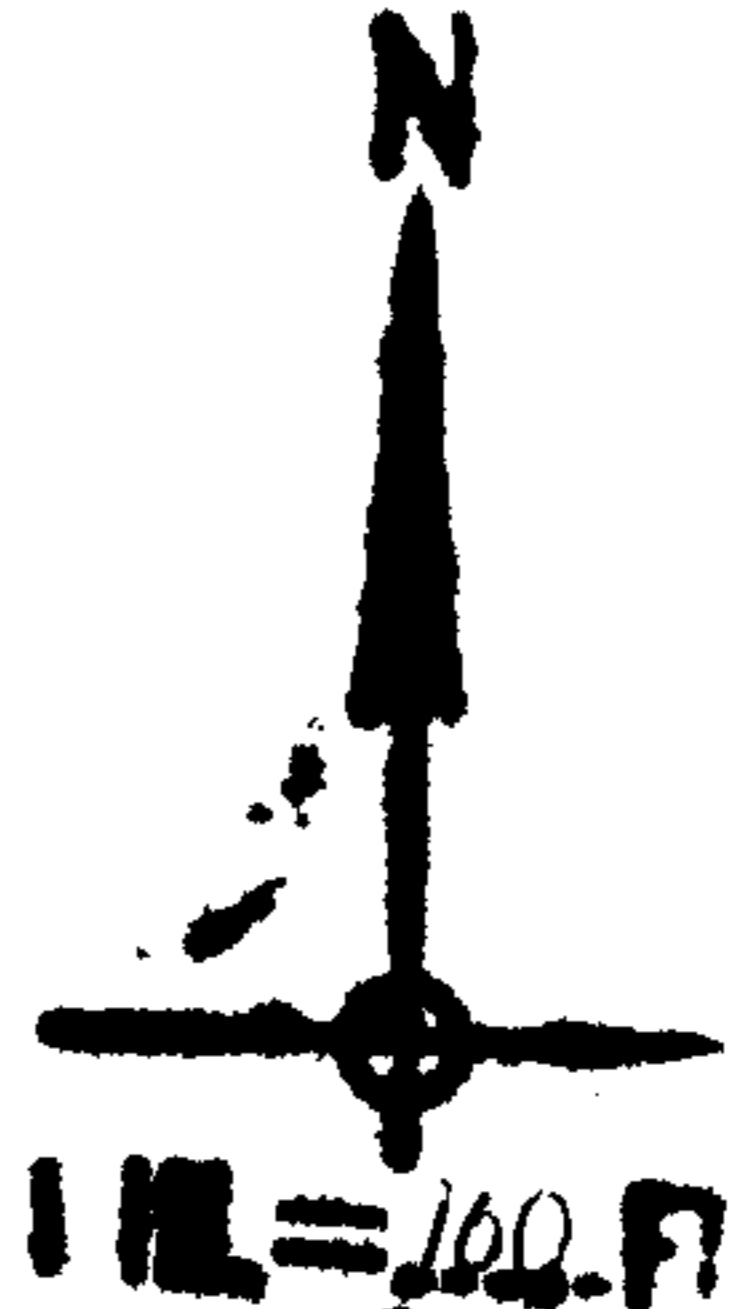


SEE 4-G

59'

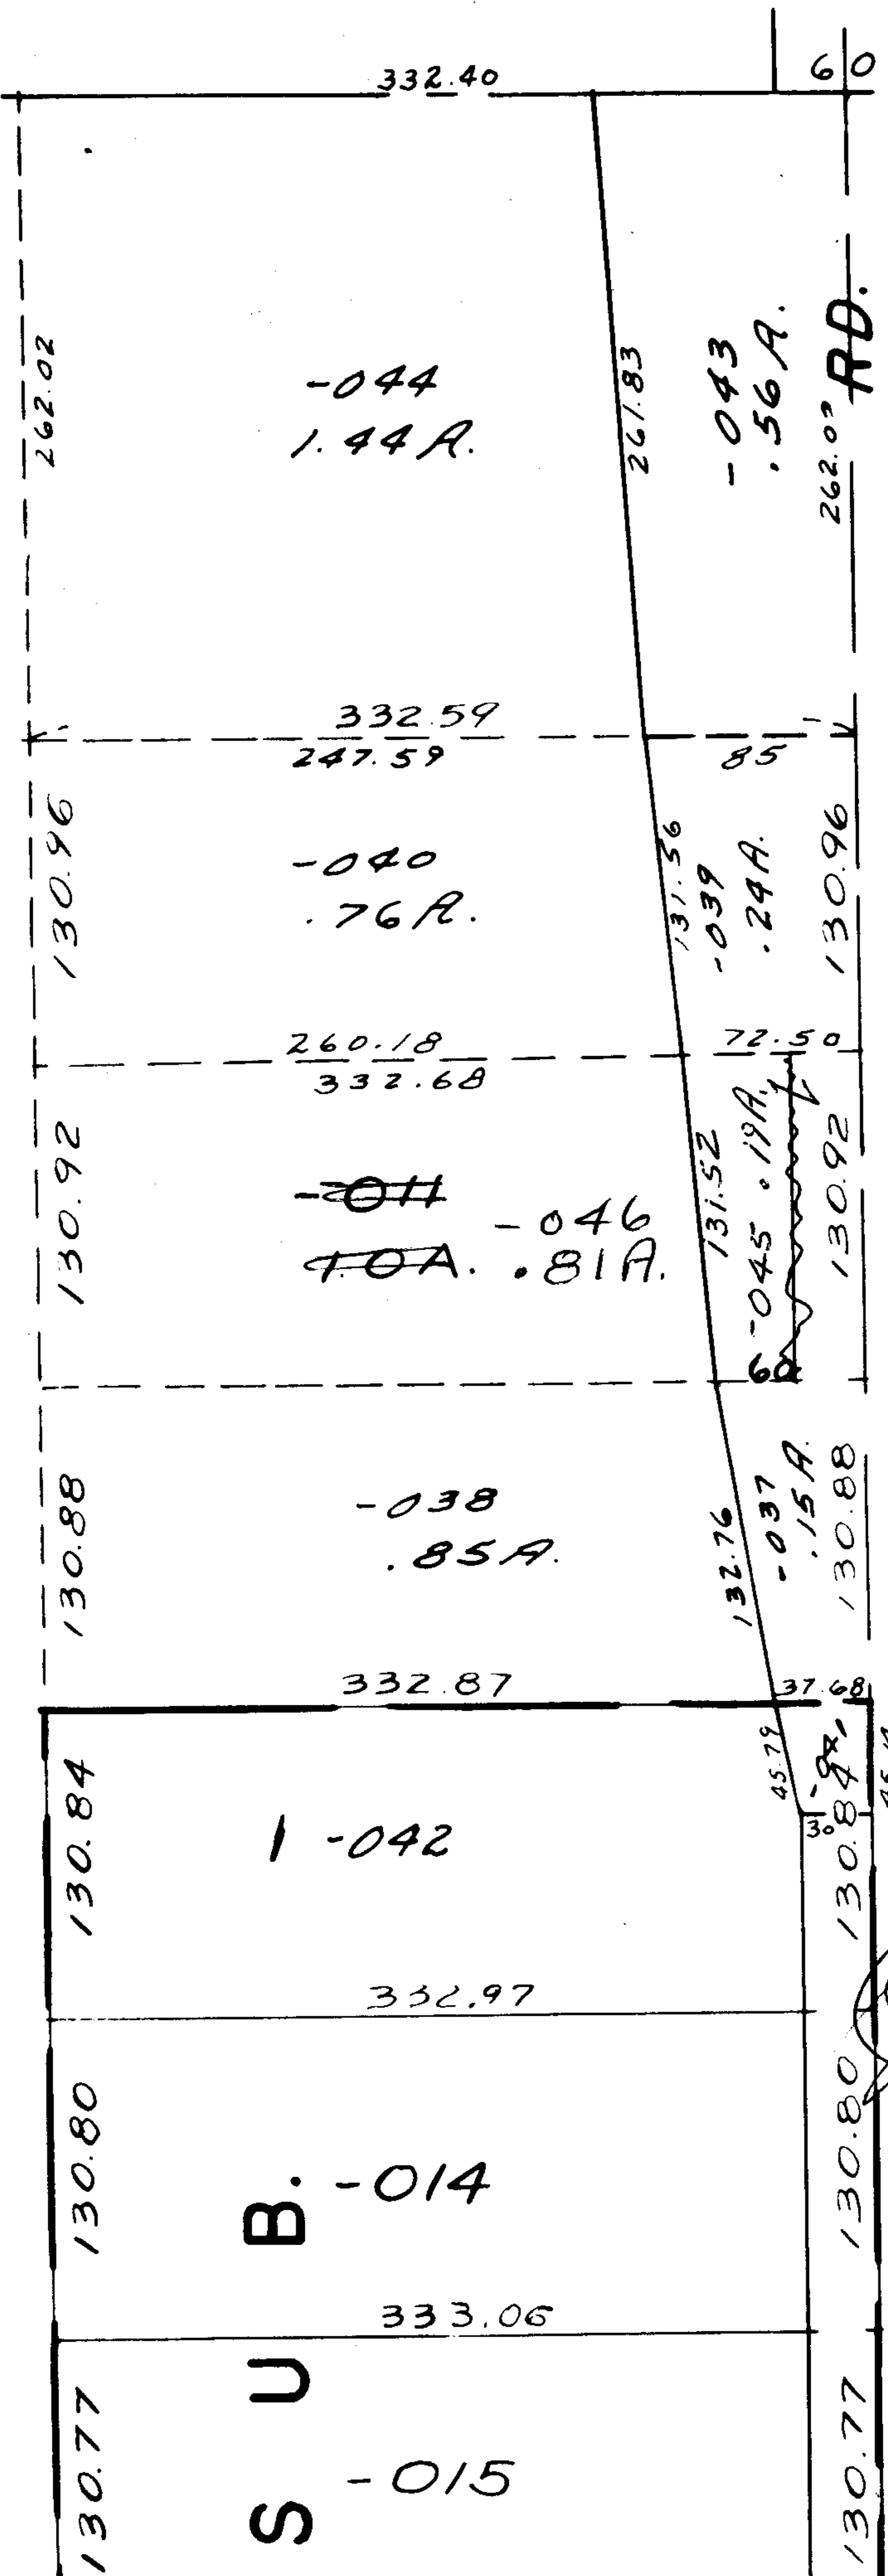

1977

APPROVED
LORAIN CO.
MAP DEPT.
 DATE 7-26-68
 4-00-022-B
 BY *K. Albert*
 9/29/68 P.K.

7-14-86 L.L.

(Handwritten initials)