3 - 00 - 008 - B

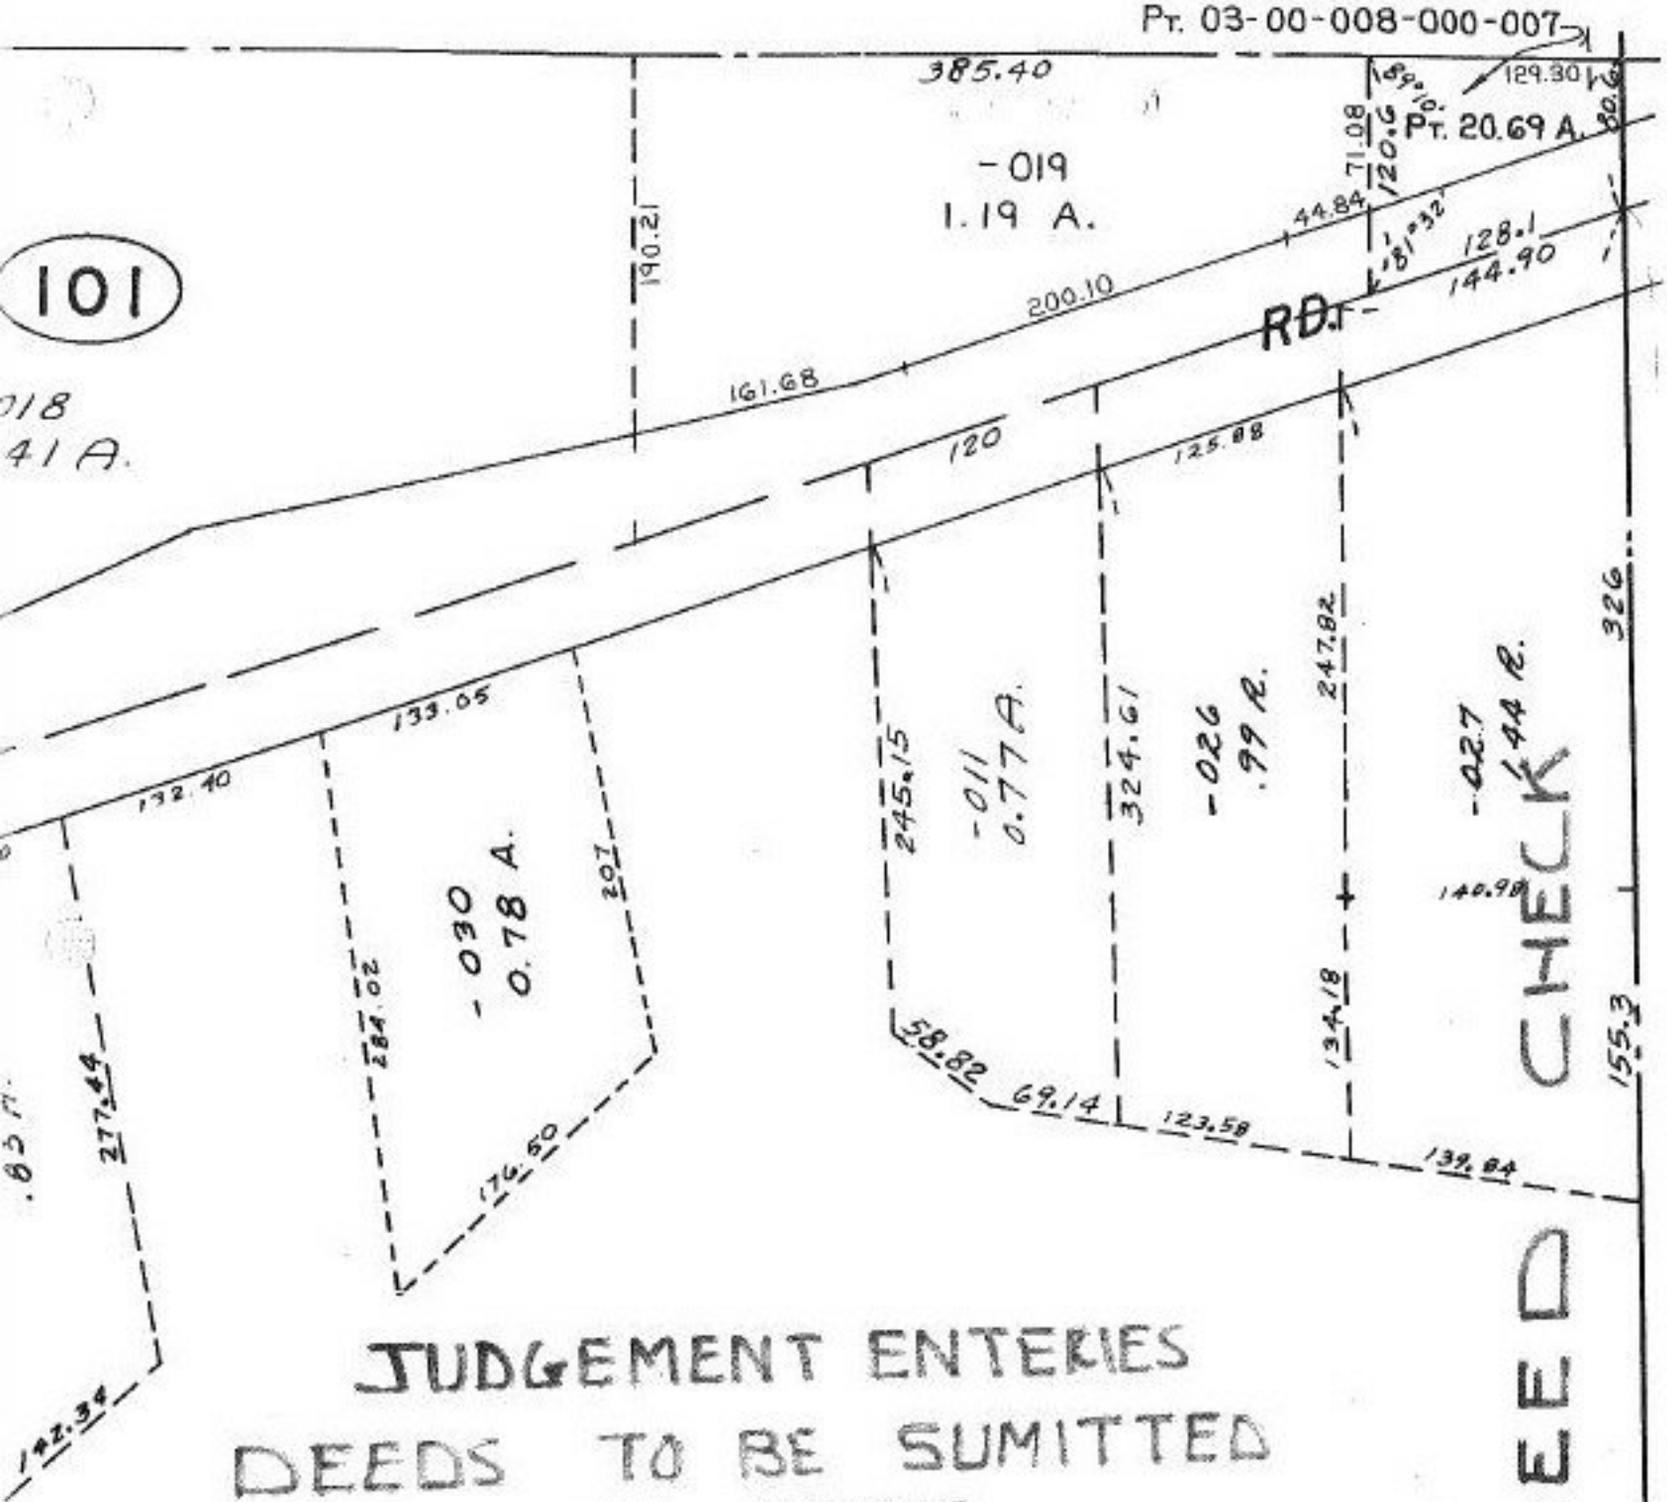

JUDGEMENT ENTERIES
DEEDS TO BE SUMITTED
AS SPLITS

4/29/92

DEED CHECK

1977 2A

DATE 3-4-92
PAGE 3-00-007-B
CAROLYN
BY FRANCIS

1977 2-A