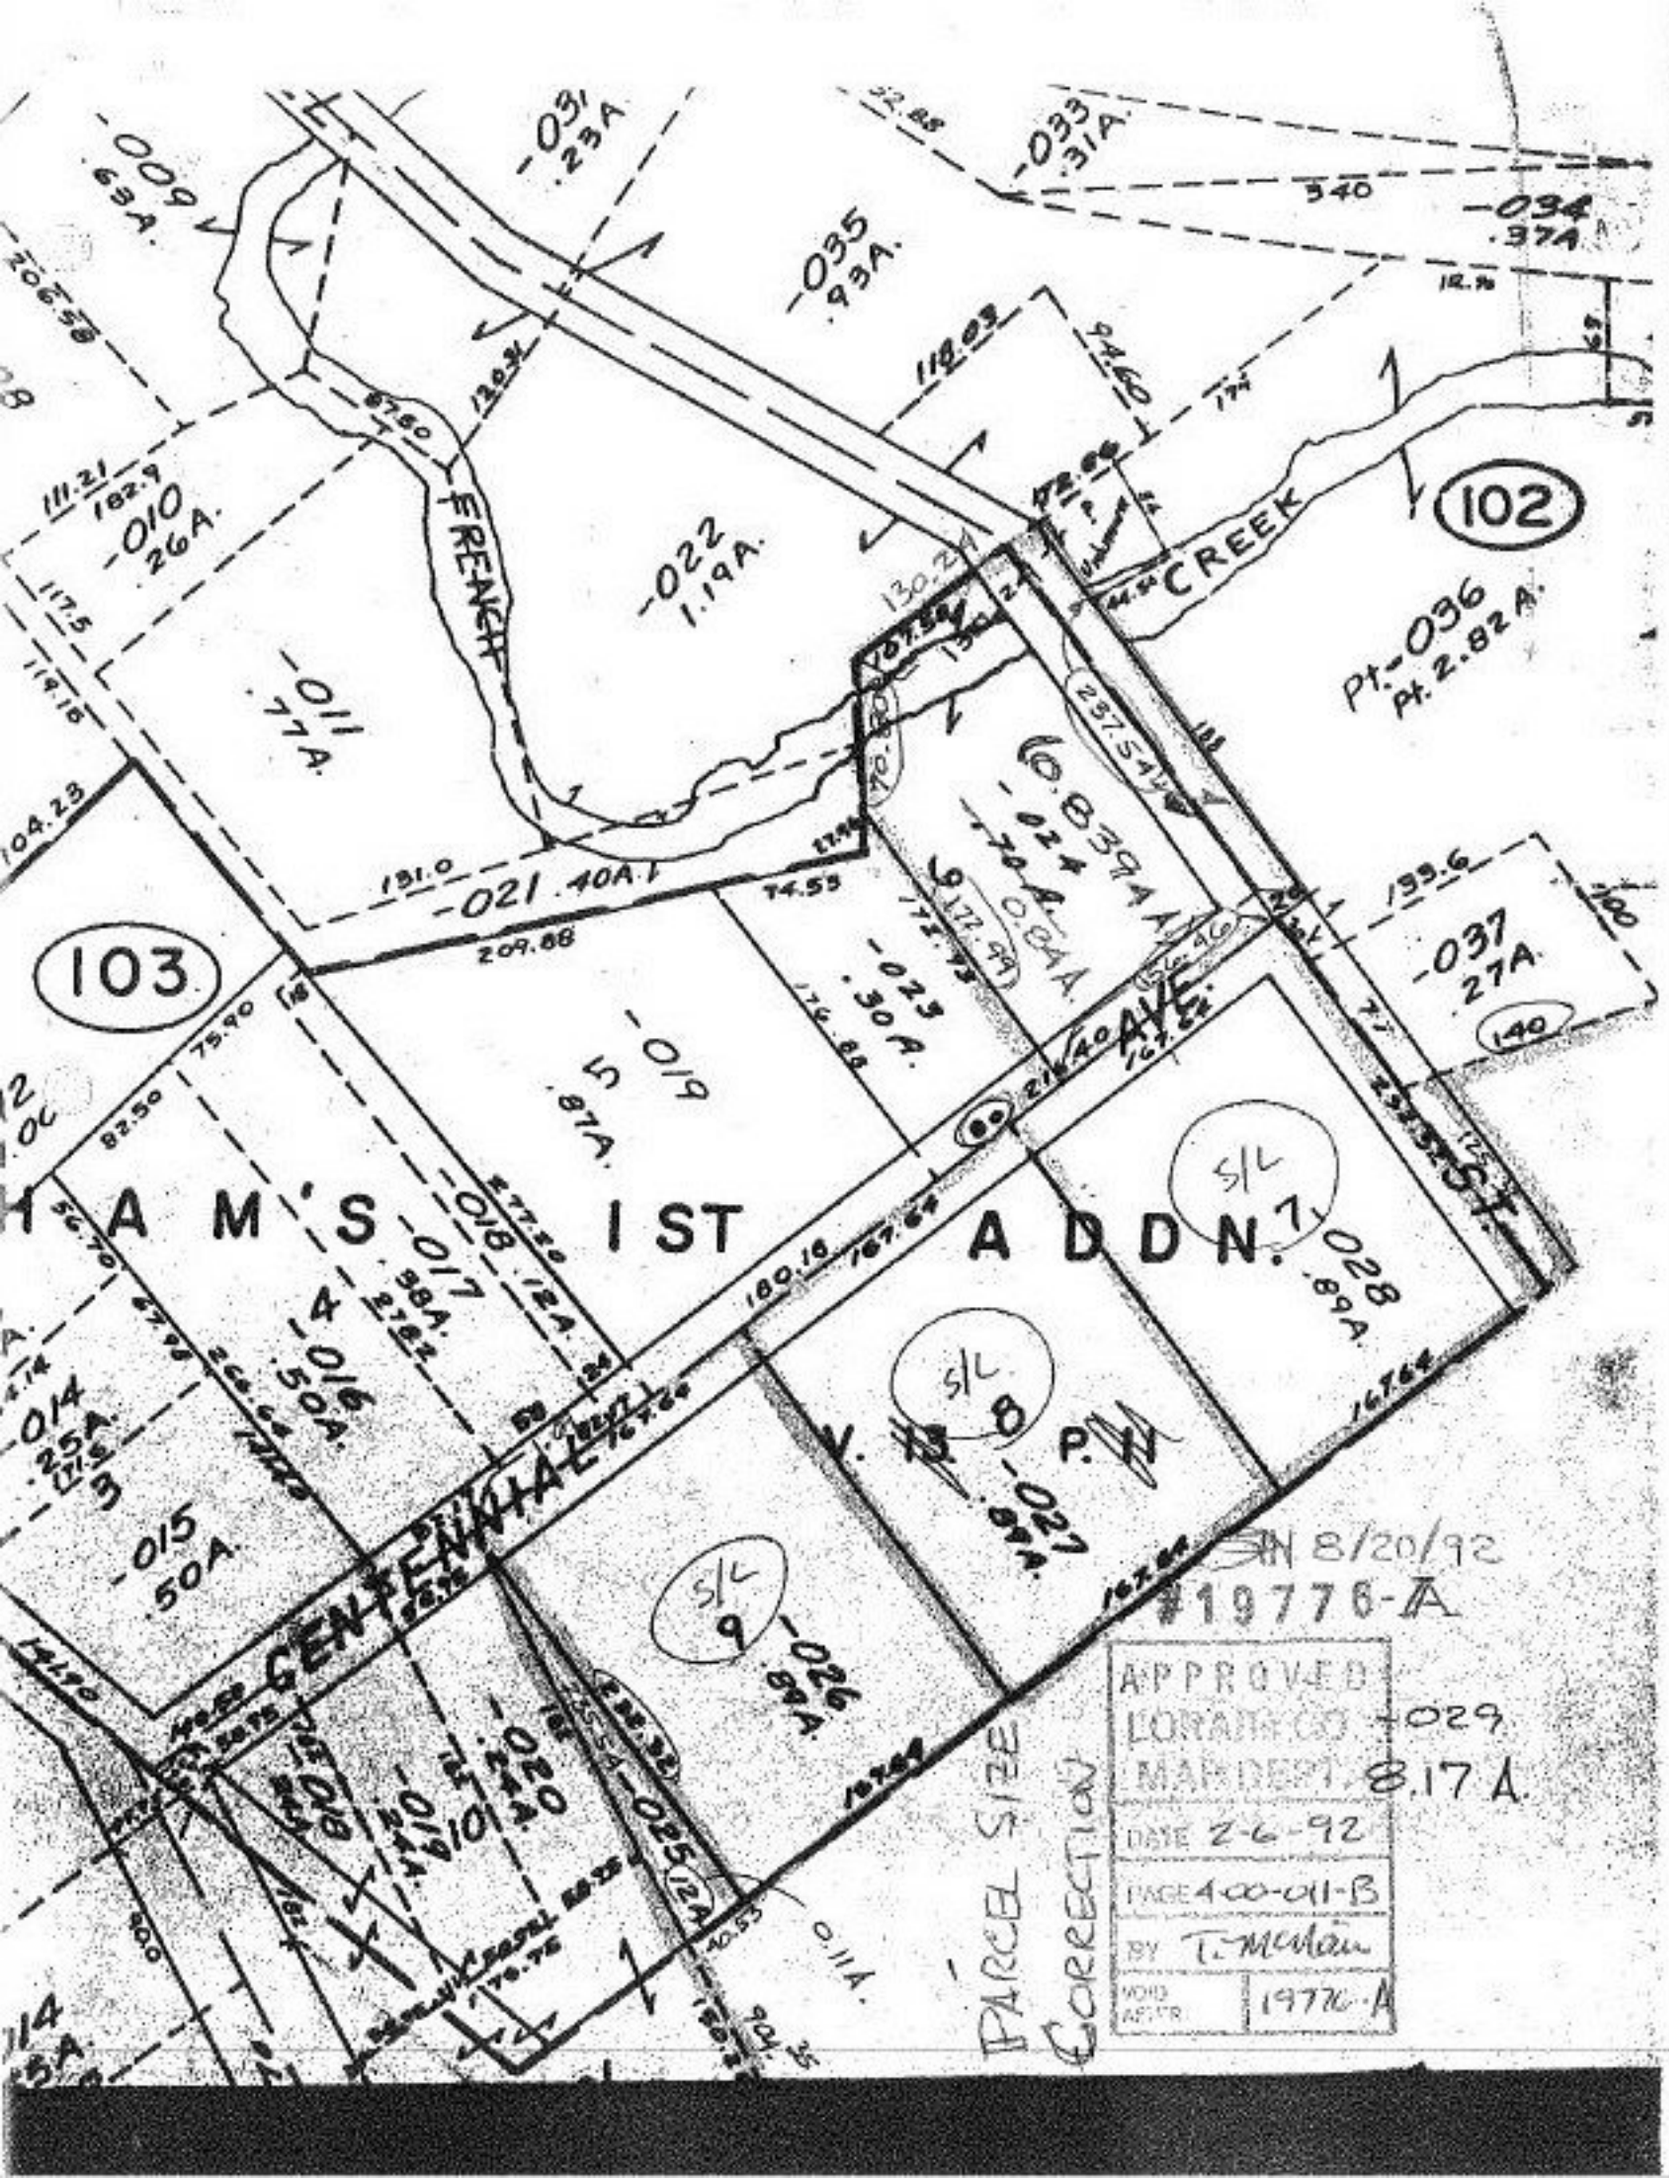
-009 63A.
-031 .23A.
-033 1.31A.
-034 .37A.
-035 .93A.
-010 26A.
-022 1.19A.
-011 77A.
FRENCH
CREEK
102
Pt.-036 Pt. 2.82A.
-021 .40A.
103
-039 .70A.
-023 .30A.
-037 27A.
140
-019 .87A.
-018 .12A.
-017 .98A. 2.82
-016 .50A.
-014 .25A.
-015 .50A.
HAM'S 1ST ADDN.
-028 .89A.
-027 .89A.
-026 .89A.
-020 .44A.
-025 .12A.
GENTE-NAHALE
AVE
S/L 8
S/L 9
S/L 7
V. P.
0.11A.
IN 8/20/92
#19776-A
APPROVED
MAP DEPT. 8.17 A
DATE 2-6-92
PAGE 4-00-011-B
BY T. McClain
VOID AFTER 19776-A
PARCEL SIZE CORRECTION