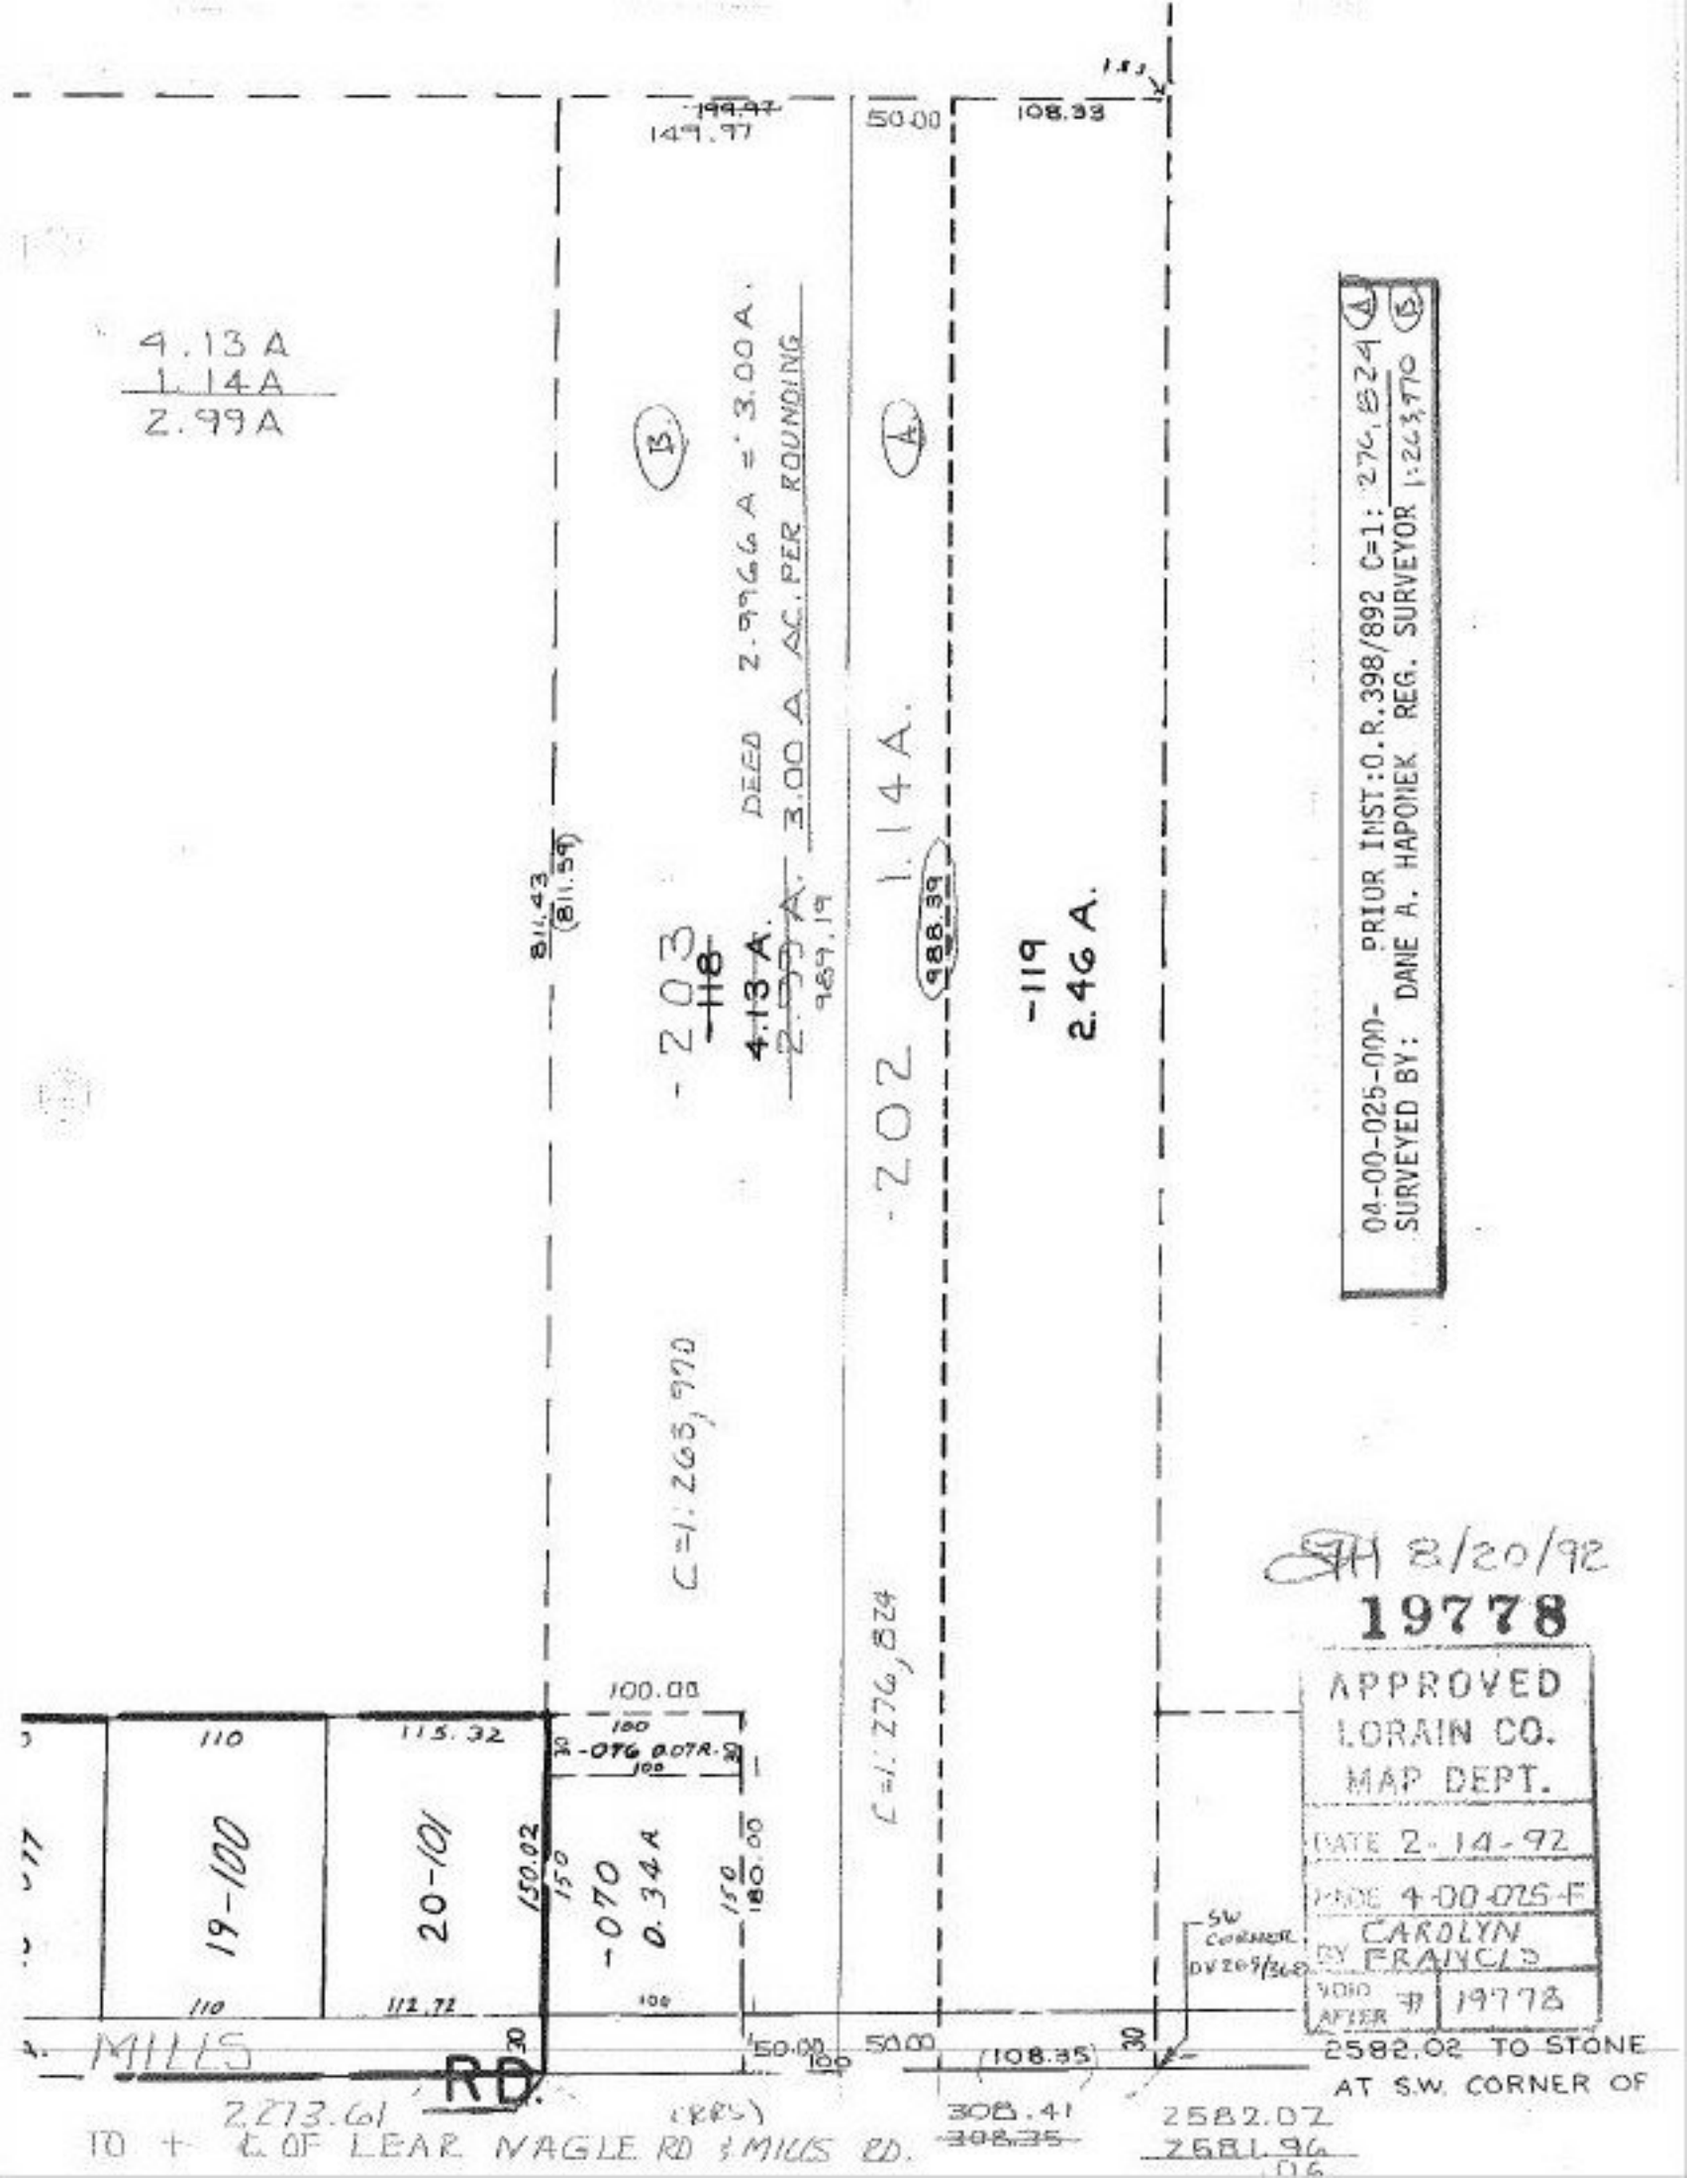

SH 8/20/92

19778

APPROVED
LORAIN CO.
MAP DEPT.

DATE 2-14-92

MADE 4-00-025-F

BY CAROLYN FRANCIS

VOID AFTER # 19778