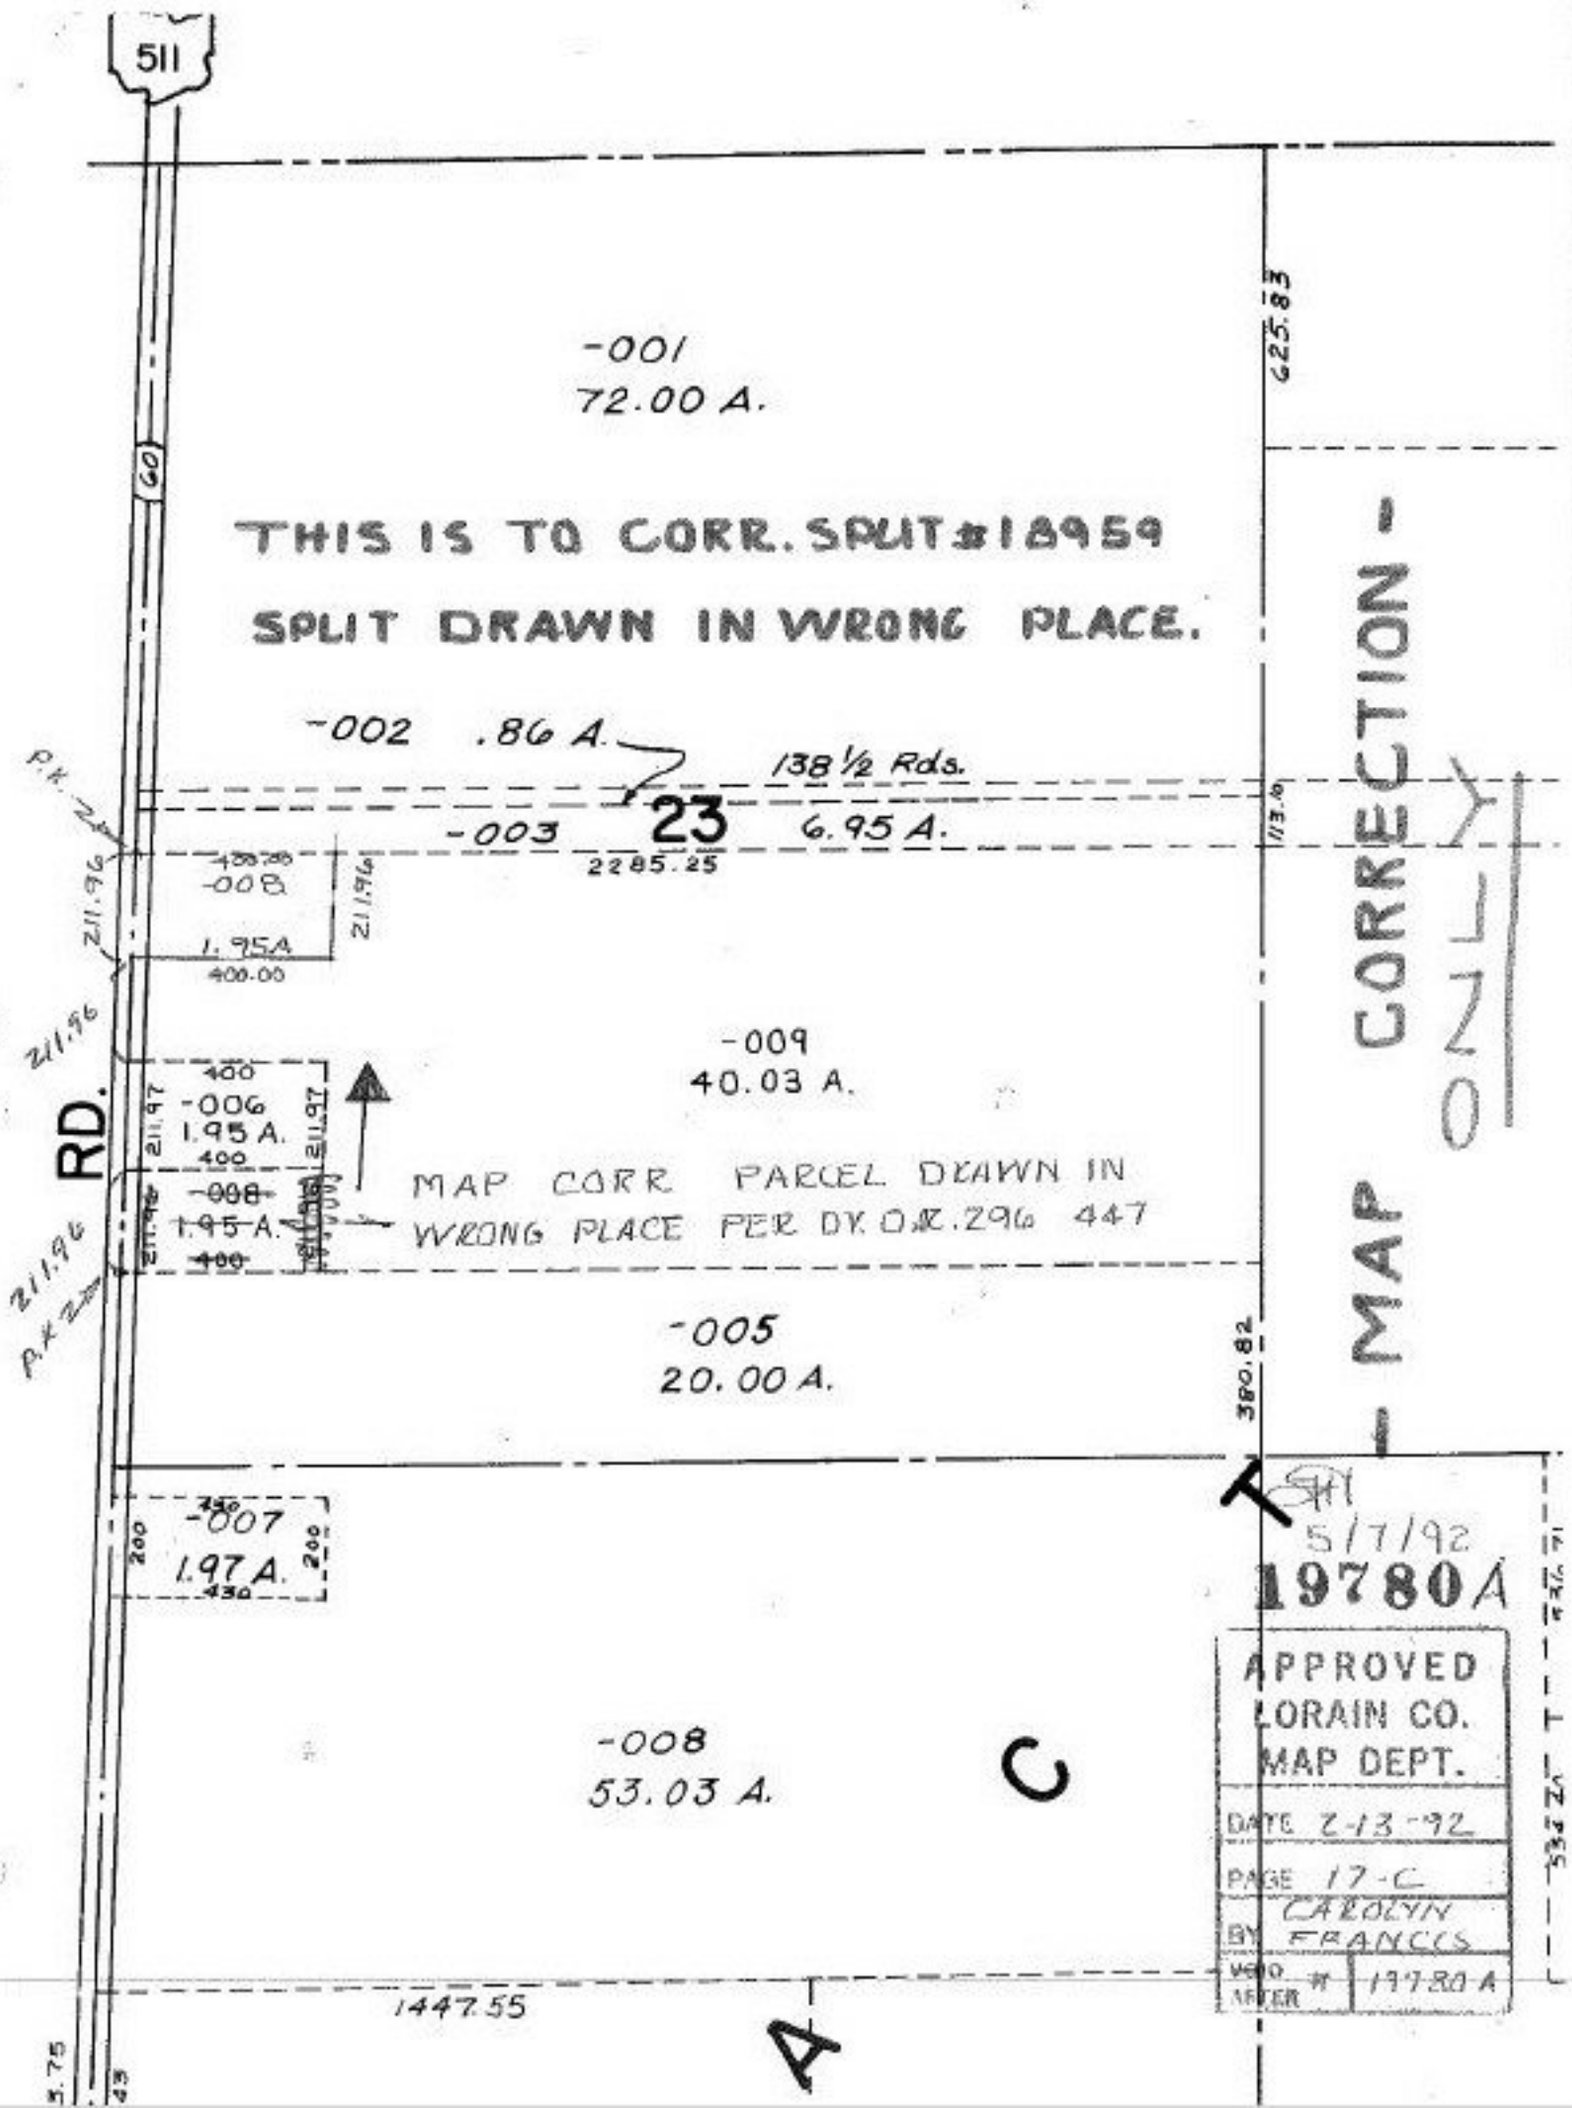

511
60
-001
72.00 A.
THIS IS TO CORR. SPLIT #18959
SPLIT DRAWN IN WRONG PLACE.
-002 .86 A.
138 1/2 Rds.
23
-003 6.95 A.
2285.25
-008
1.95A
400.00
211.96
-009
40.03 A.
-006
1.95 A.
400
211.97
RD.
MAP CORR PARCEL DRAWN IN
WRONG PLACE PER DY. O.R. 296 447
-005
20.00 A.
380.82
625.83
-007
1.97 A.
200
430
-008
53.03 A.
C
1447.55
A
MAP CORRECTION - ONLY
5/7/92
19780A
APPROVED
LORAIN CO.
MAP DEPT.
DATE 2-13-92
PAGE 17-C
BY CAROLYN FRANCIS
VOID AFTER # 19780 A