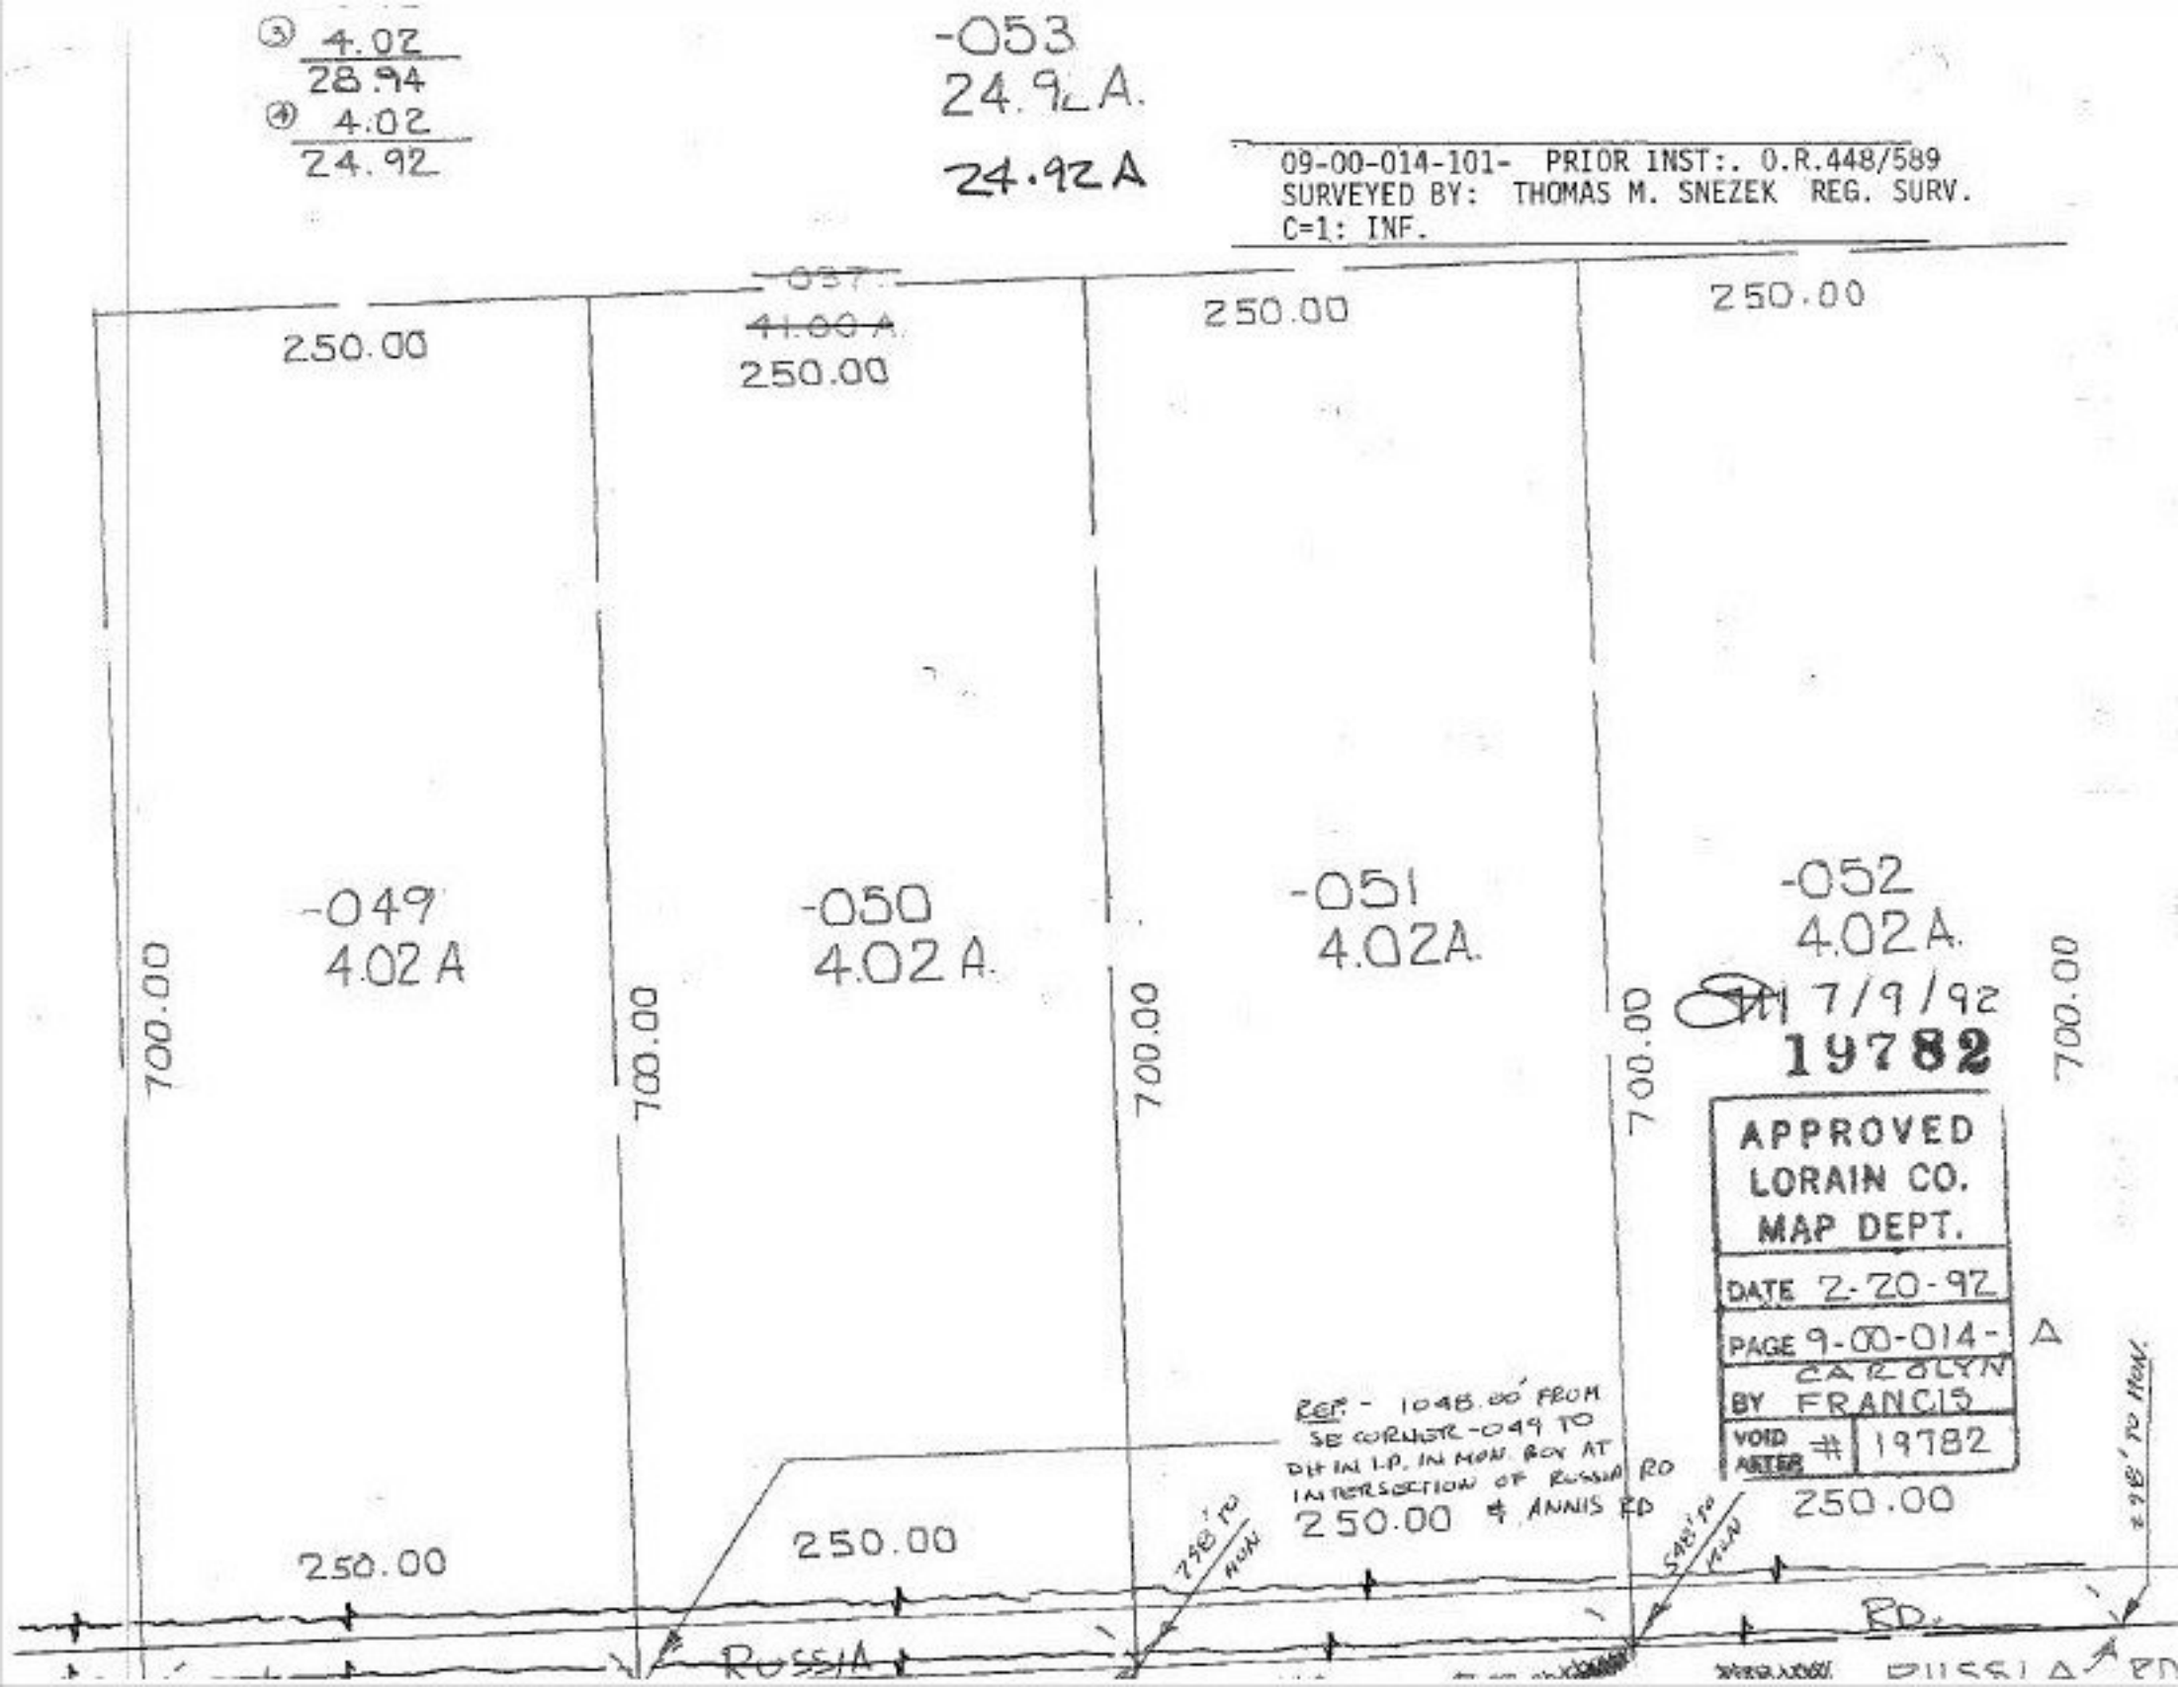
③ 4.02
28.94
④ 4.02
24.92
-053
24.92 A.
24.92 A
09-00-014-101- PRIOR INST:. O.R.448/589
SURVEYED BY: THOMAS M. SNEZEK REG. SURV.
C=1: INF.
250.00
-037
41.00 A
250.00
250.00
250.00
-049
4.02 A
-050
4.02 A.
-051
4.02A.
-052
4.02A.
700.00
700.00
700.00
700.00
700.00
7/9/92
19782
APPROVED
LORAIN CO.
MAP DEPT.
DATE 2-20-92
PAGE 9-00-014- A
BY CAROLYN FRANCIS
VOID AFTER # 19782
REF. - 1048.00' FROM SE CORNER -049 TO DH IN I.P. IN MON. BOX AT INTERSECTION OF RUSSIA RD & ANNIS RD
250.00
250.00
250.00
250.00
RUSSIA
RD.
RUSSIA RD