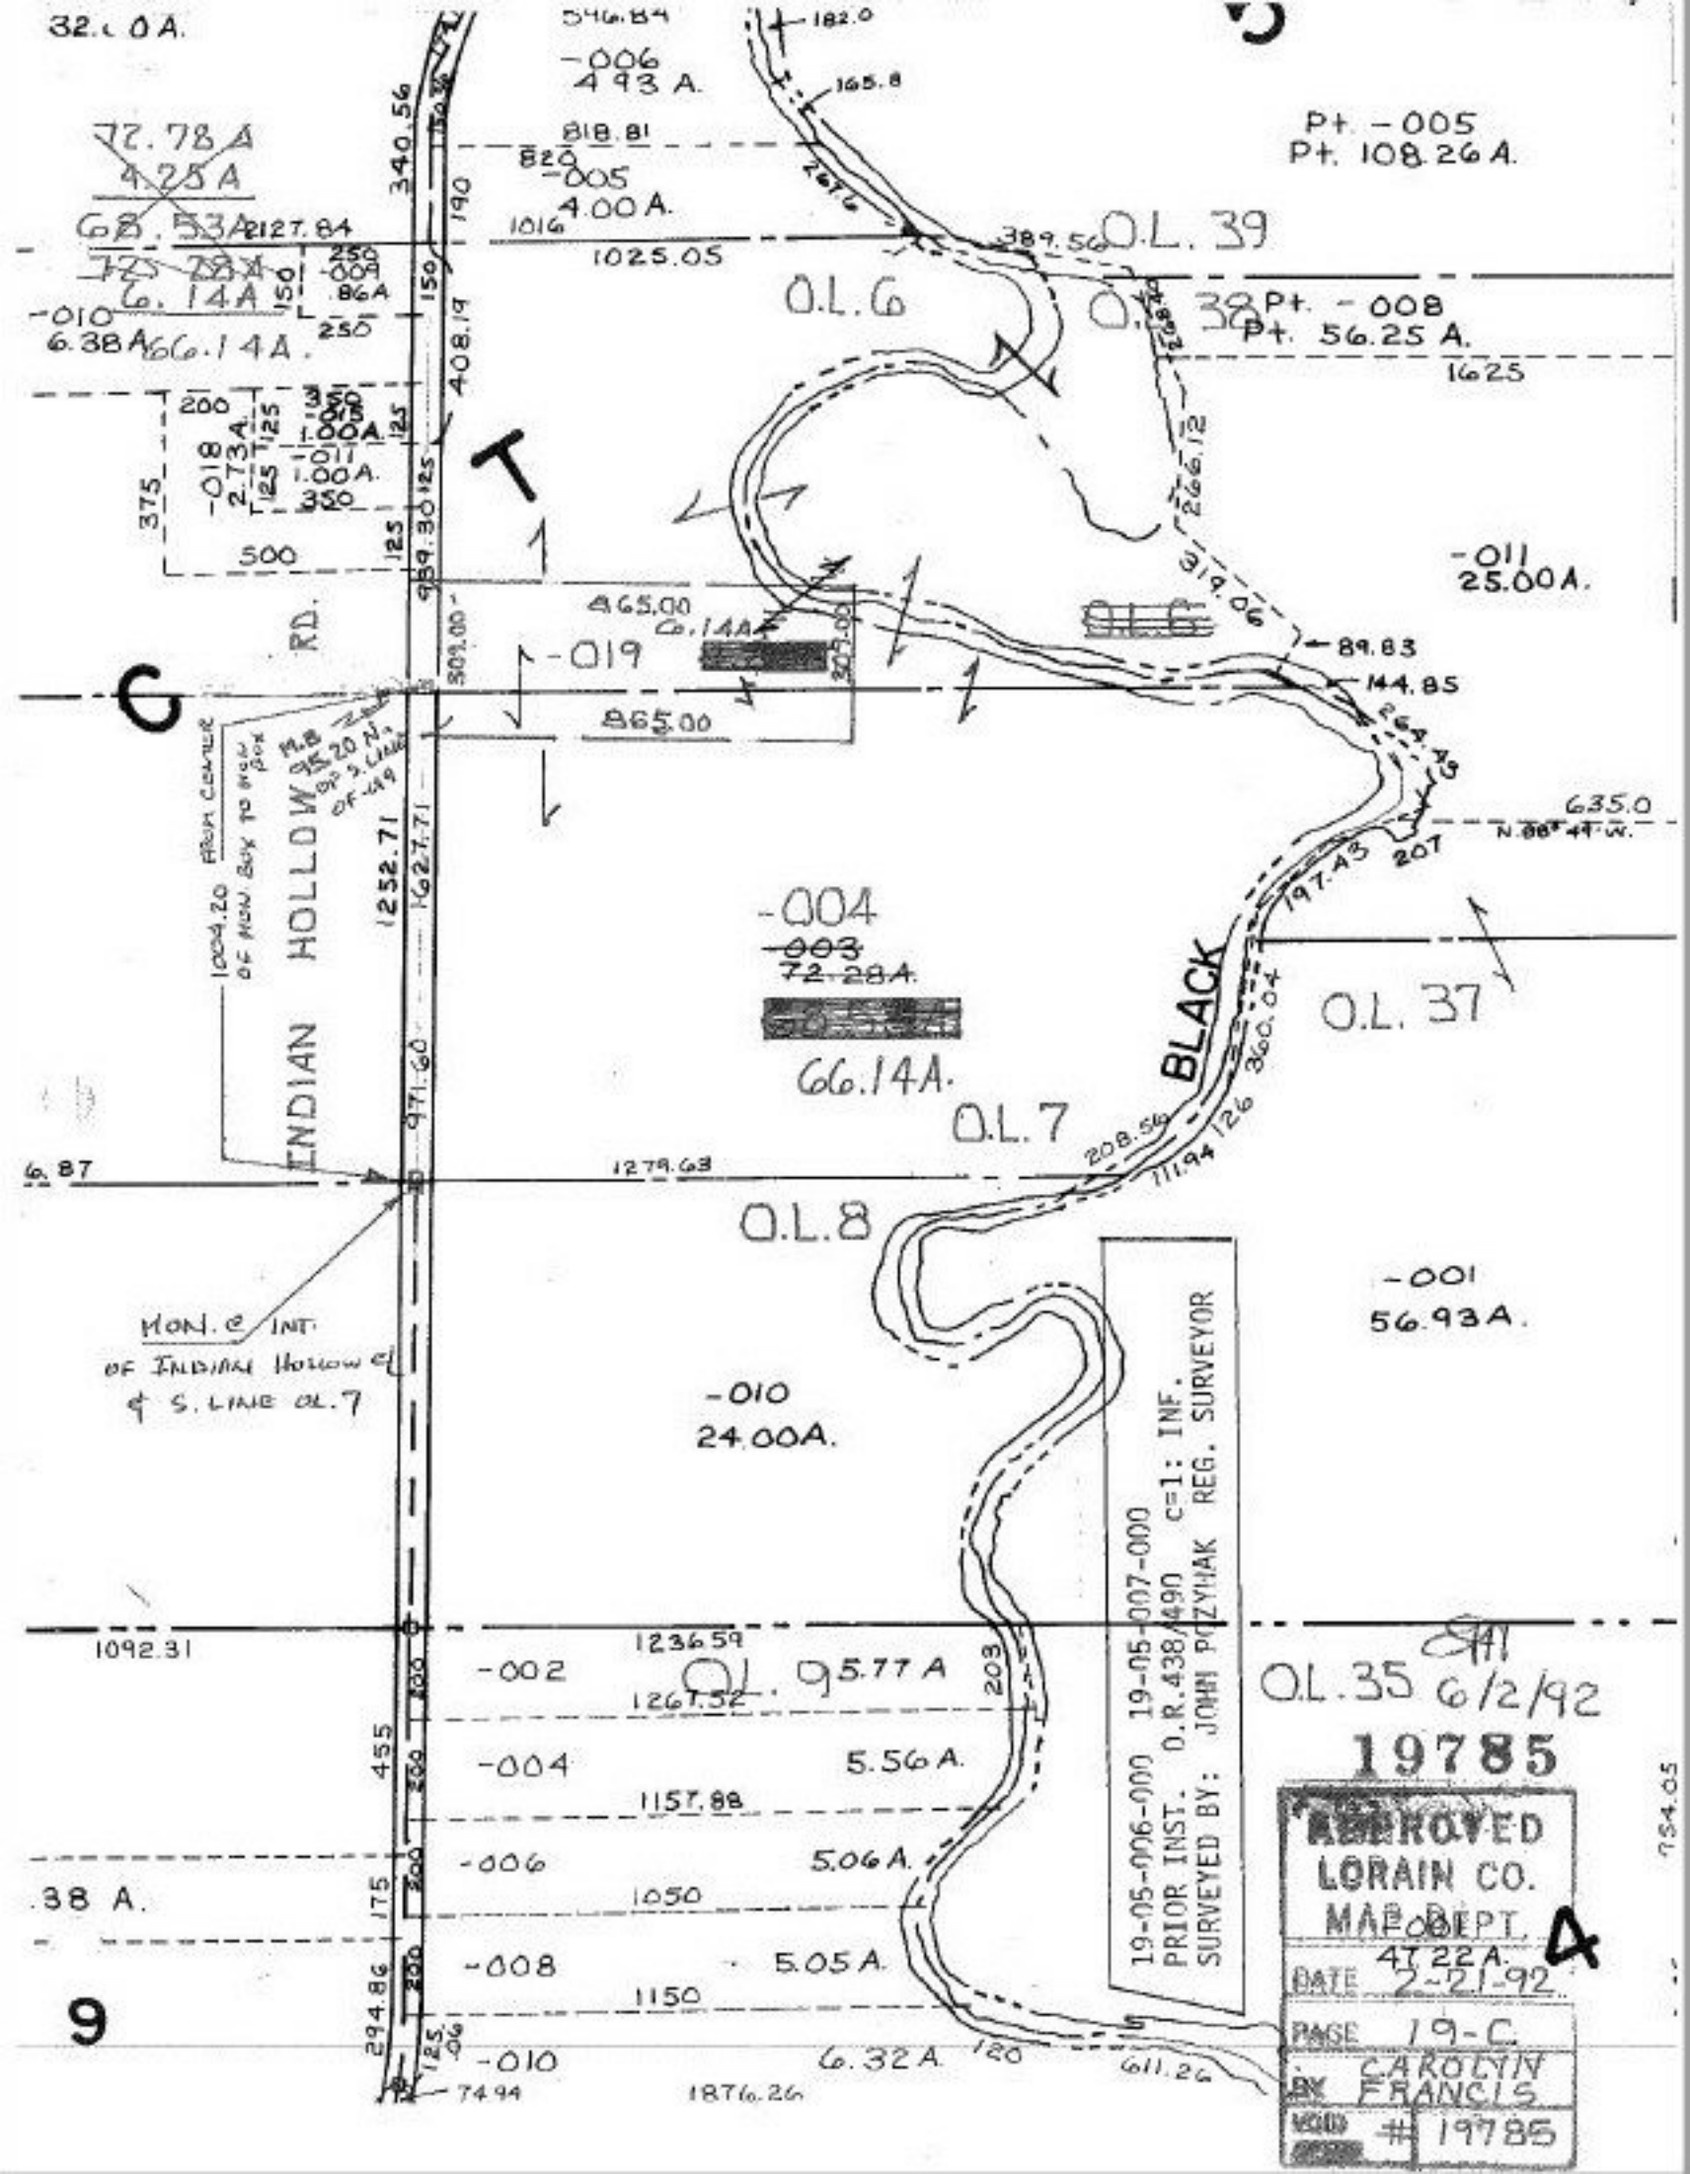

32.00 A.
546.84
-006
4.93 A.
182.0
165.8
Pt. -005
Pt. 108.26 A.
72.78 A
4.25 A
68.53 A
72.78 A
6.14 A
-010
6.38 A
66.14 A.
818.81
820
-005
4.00 A.
1016
1025.05
389.56
O.L. 39
O.L. 6
O.L. 38
Pt. -008
Pt. 56.25 A.
1625
340.56
190
150
408.19
200
350
-015
1.00 A.
-011
1.00 A.
-018
2.73 A.
375
500
125
939.30
266.12
319.06
-011
25.00 A.
465.00
6.14 A.
-019
309.00
865.00
89.83
144.85
264.43
635.0
N. 88° 49' W.
207
197.43
-004
-003
72.28 A.
66.14 A.
O.L. 37
BLACK
360.04
126
O.L. 7
208.56
111.94
1279.63
O.L. 8
-001
56.93 A.
-010
24.00 A.
MON. @ INT. OF INDIAN HOLLOW ℄ & S. LINE OL. 7
INDIAN HOLLOW RD.
1004.20 FROM CENTER OF MON. BOX TO MON. BOX
M.B. 95.20 N. OF S. LINE OF 49
1252.71
1627.71
971.60
6.87
1092.31
1236.59
-002
O.L. 9
5.77 A
1267.52
203
O.L. 35
6/2/92
455
-004
5.56 A.
1157.88
-006
5.06 A.
.38 A.
175
1050
-008
5.05 A.
1150
294.86
-010
6.32 A.
120
611.26
74.94
1876.26
19-05-006-000 19-05-007-000
PRIOR INST. O.R. 438/490 c=1: INF.
SURVEYED BY: JOHN POZYHAK REG. SURVEYOR
19785
APPROVED
LORAIN CO.
MAP DEPT.
DATE 2-21-92
PAGE 19-C
BY CAROLYN FRANCIS
VOID # 19785
9
4