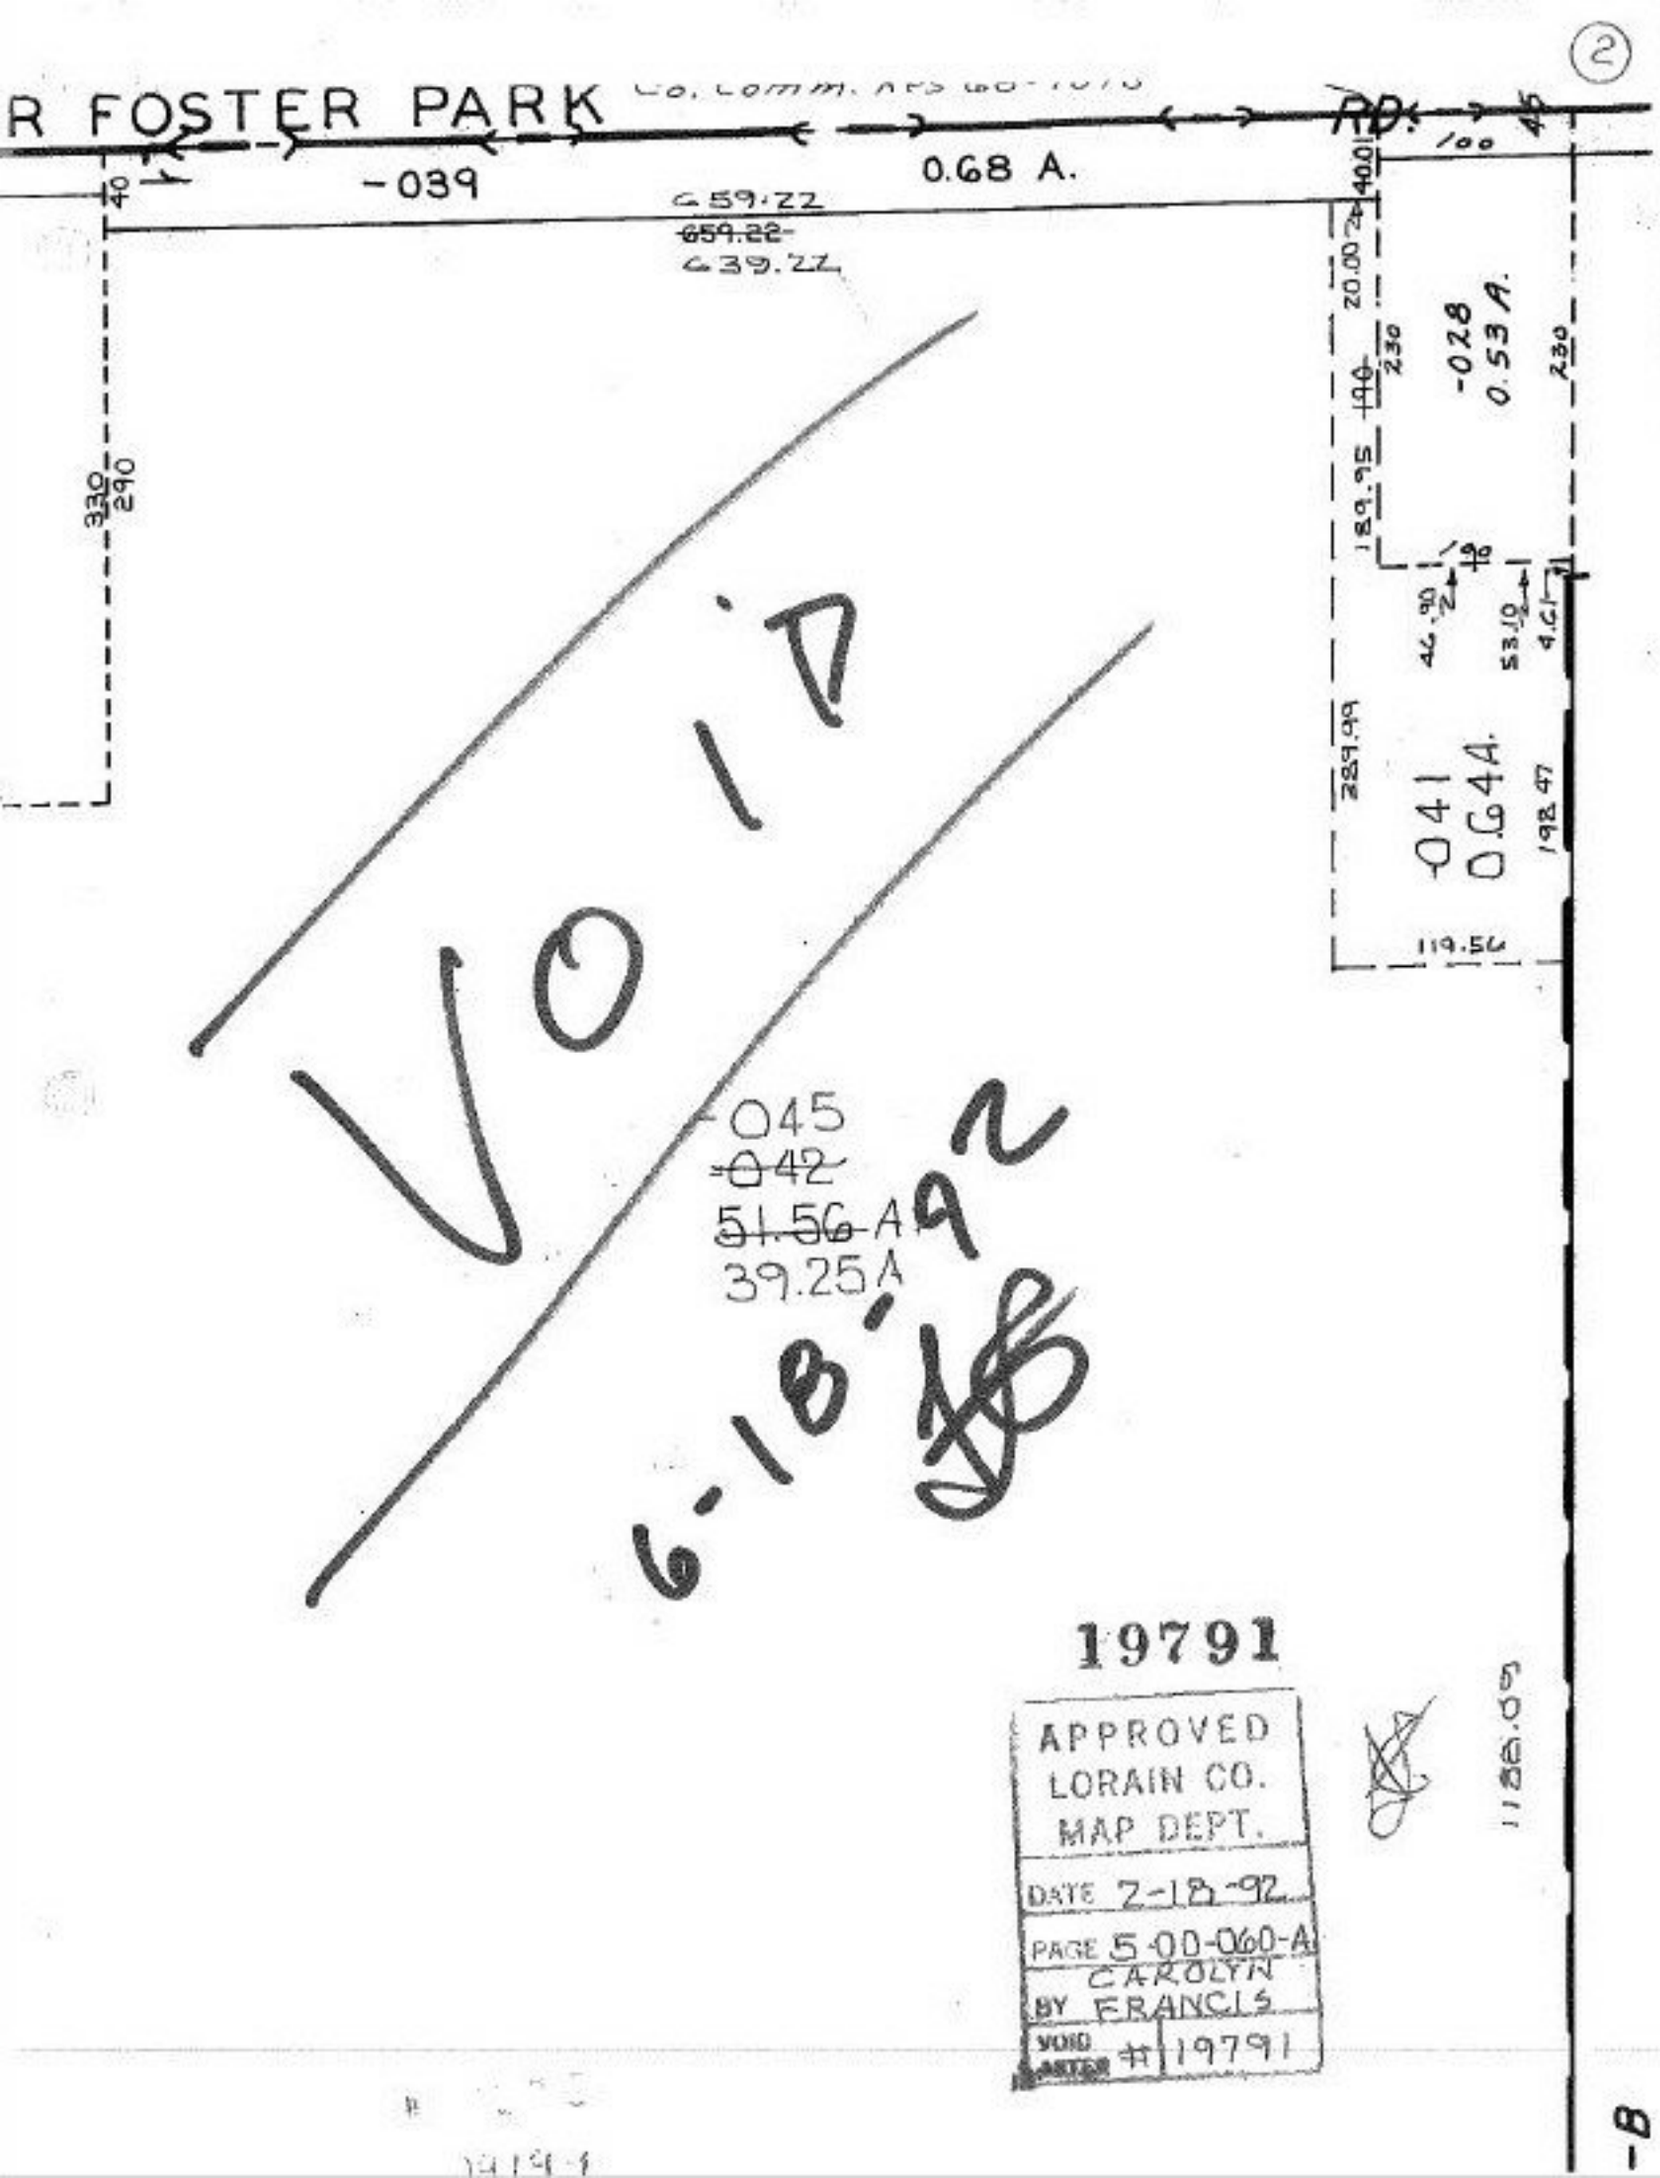
R FOSTER PARK
Co. Comm. Apr 60-1070
RD.
100
45
-039
0.68 A.
40
659.22
639.22
20.00
400
230
-028
0.53A.
330
290
189.95
10
46.90
53.10
4.61
289.99
041
0.644.
198.47
119.56
VOID
045
042
51.56 A
39.25A
6-10-92
19791
APPROVED
LORAIN CO.
MAP DEPT.
DATE 2-18-92
PAGE 5-00-060-A
BY CAROLYN FRANCIS
VOID AFTER # 19791
1188.05
-8