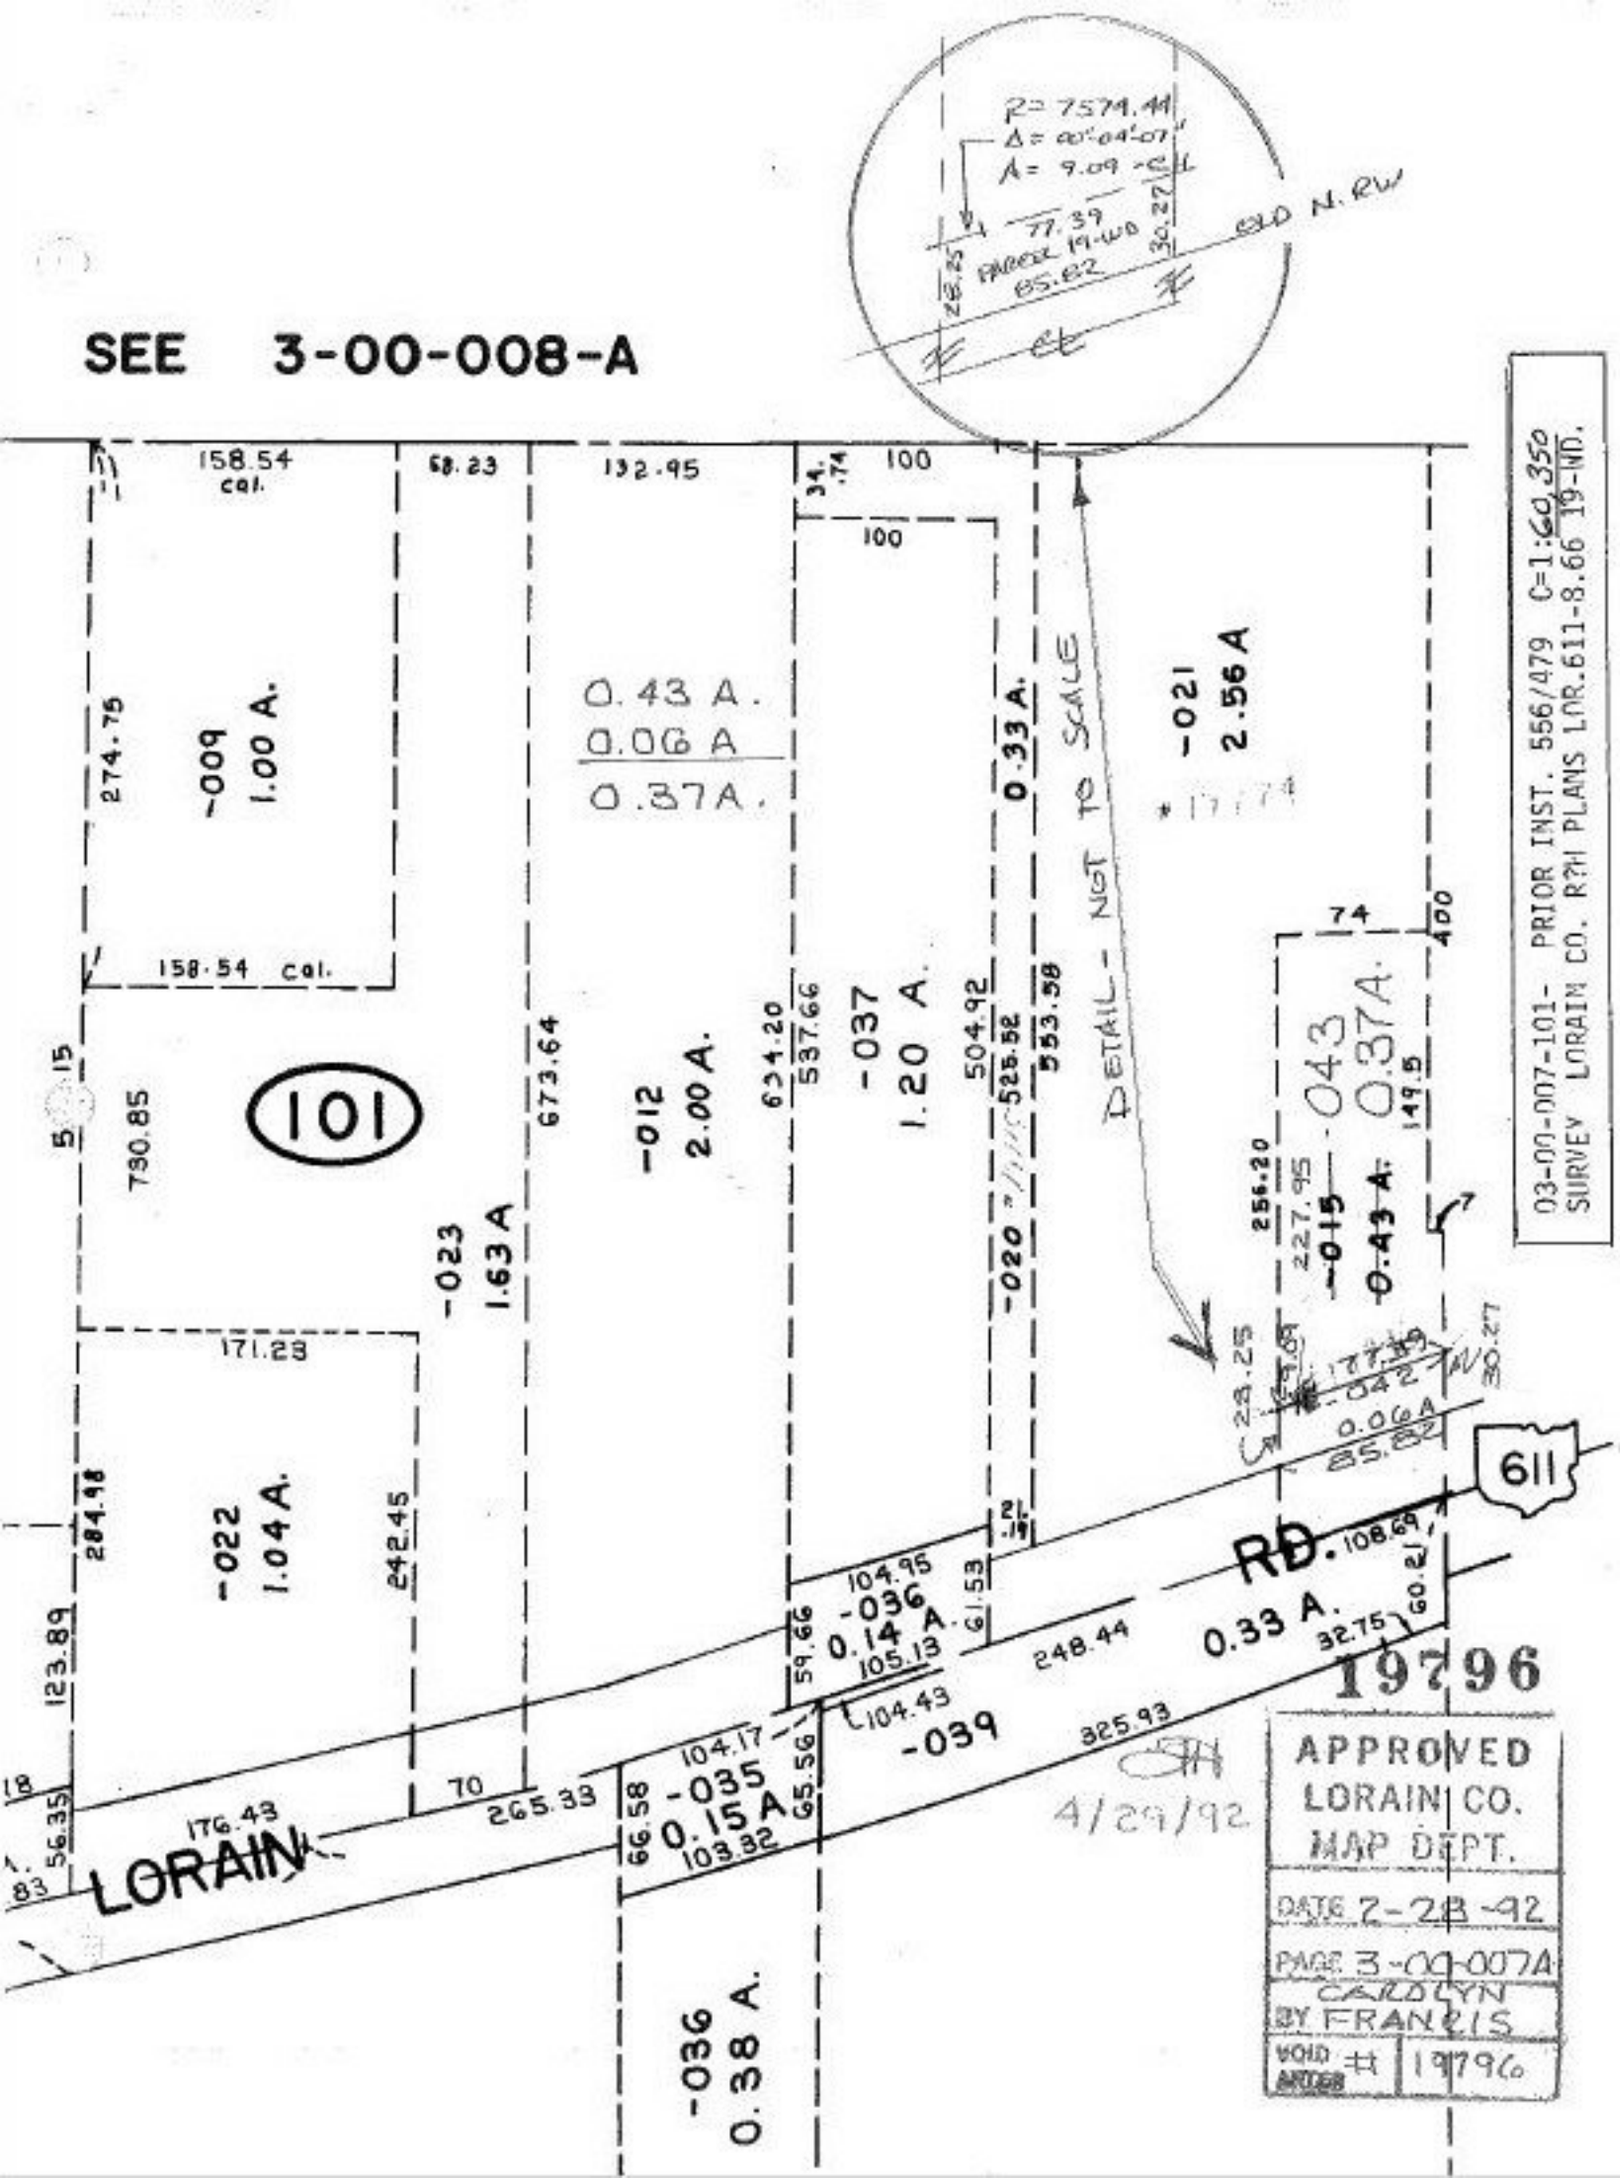
SEE 3-00-008-A
R= 7574.44
Δ= 00°04'07"
A= 9.09 -CL
77.39
PARCEL 19-WD
85.82
28.25
30.27
OLD N. RW
CL
158.54 cal.
68.23
132.95
34.74
100
100
274.75
-009
1.00 A.
0.43 A.
0.06 A
0.37A.
0.33 A.
DETAIL - NOT TO SCALE
-021
2.56 A
158.54 cal.
74
400
101
730.85
673.64
-012
2.00 A.
634.20
537.66
-037
1.20 A.
504.92
525.52
553.58
-020
-043
0.37A.
149.5
256.20
227.95
-015
0.43 A.
-023
1.63 A
171.23
28.25
177.39
-042
0.06A
85.82
30.27
611
284.98
-022
1.04 A.
242.45
104.95
-036
0.14 A.
105.13
61.53
RD.
108.69
60.21
0.33 A.
32.75
248.44
59.66
104.43
-039
325.93
123.89
104.17
-035
0.15 A
103.32
65.56
66.58
70
265.33
176.43
56.35
LORAIN
-036
0.38 A.
19796
4/29/92
APPROVED
LORAIN CO.
MAP DEPT.
DATE 2-28-92
PAGE 3-00-007A
CAROLYN
BY FRANCIS
VOID ARTCOR # 19796
03-00-007-101- PRIOR INST. 556/479 C=1:60,350
SURVEY LORAIN CO. R7H PLANS LOR.611-8.66 19-WD.