SEE 3-00-(

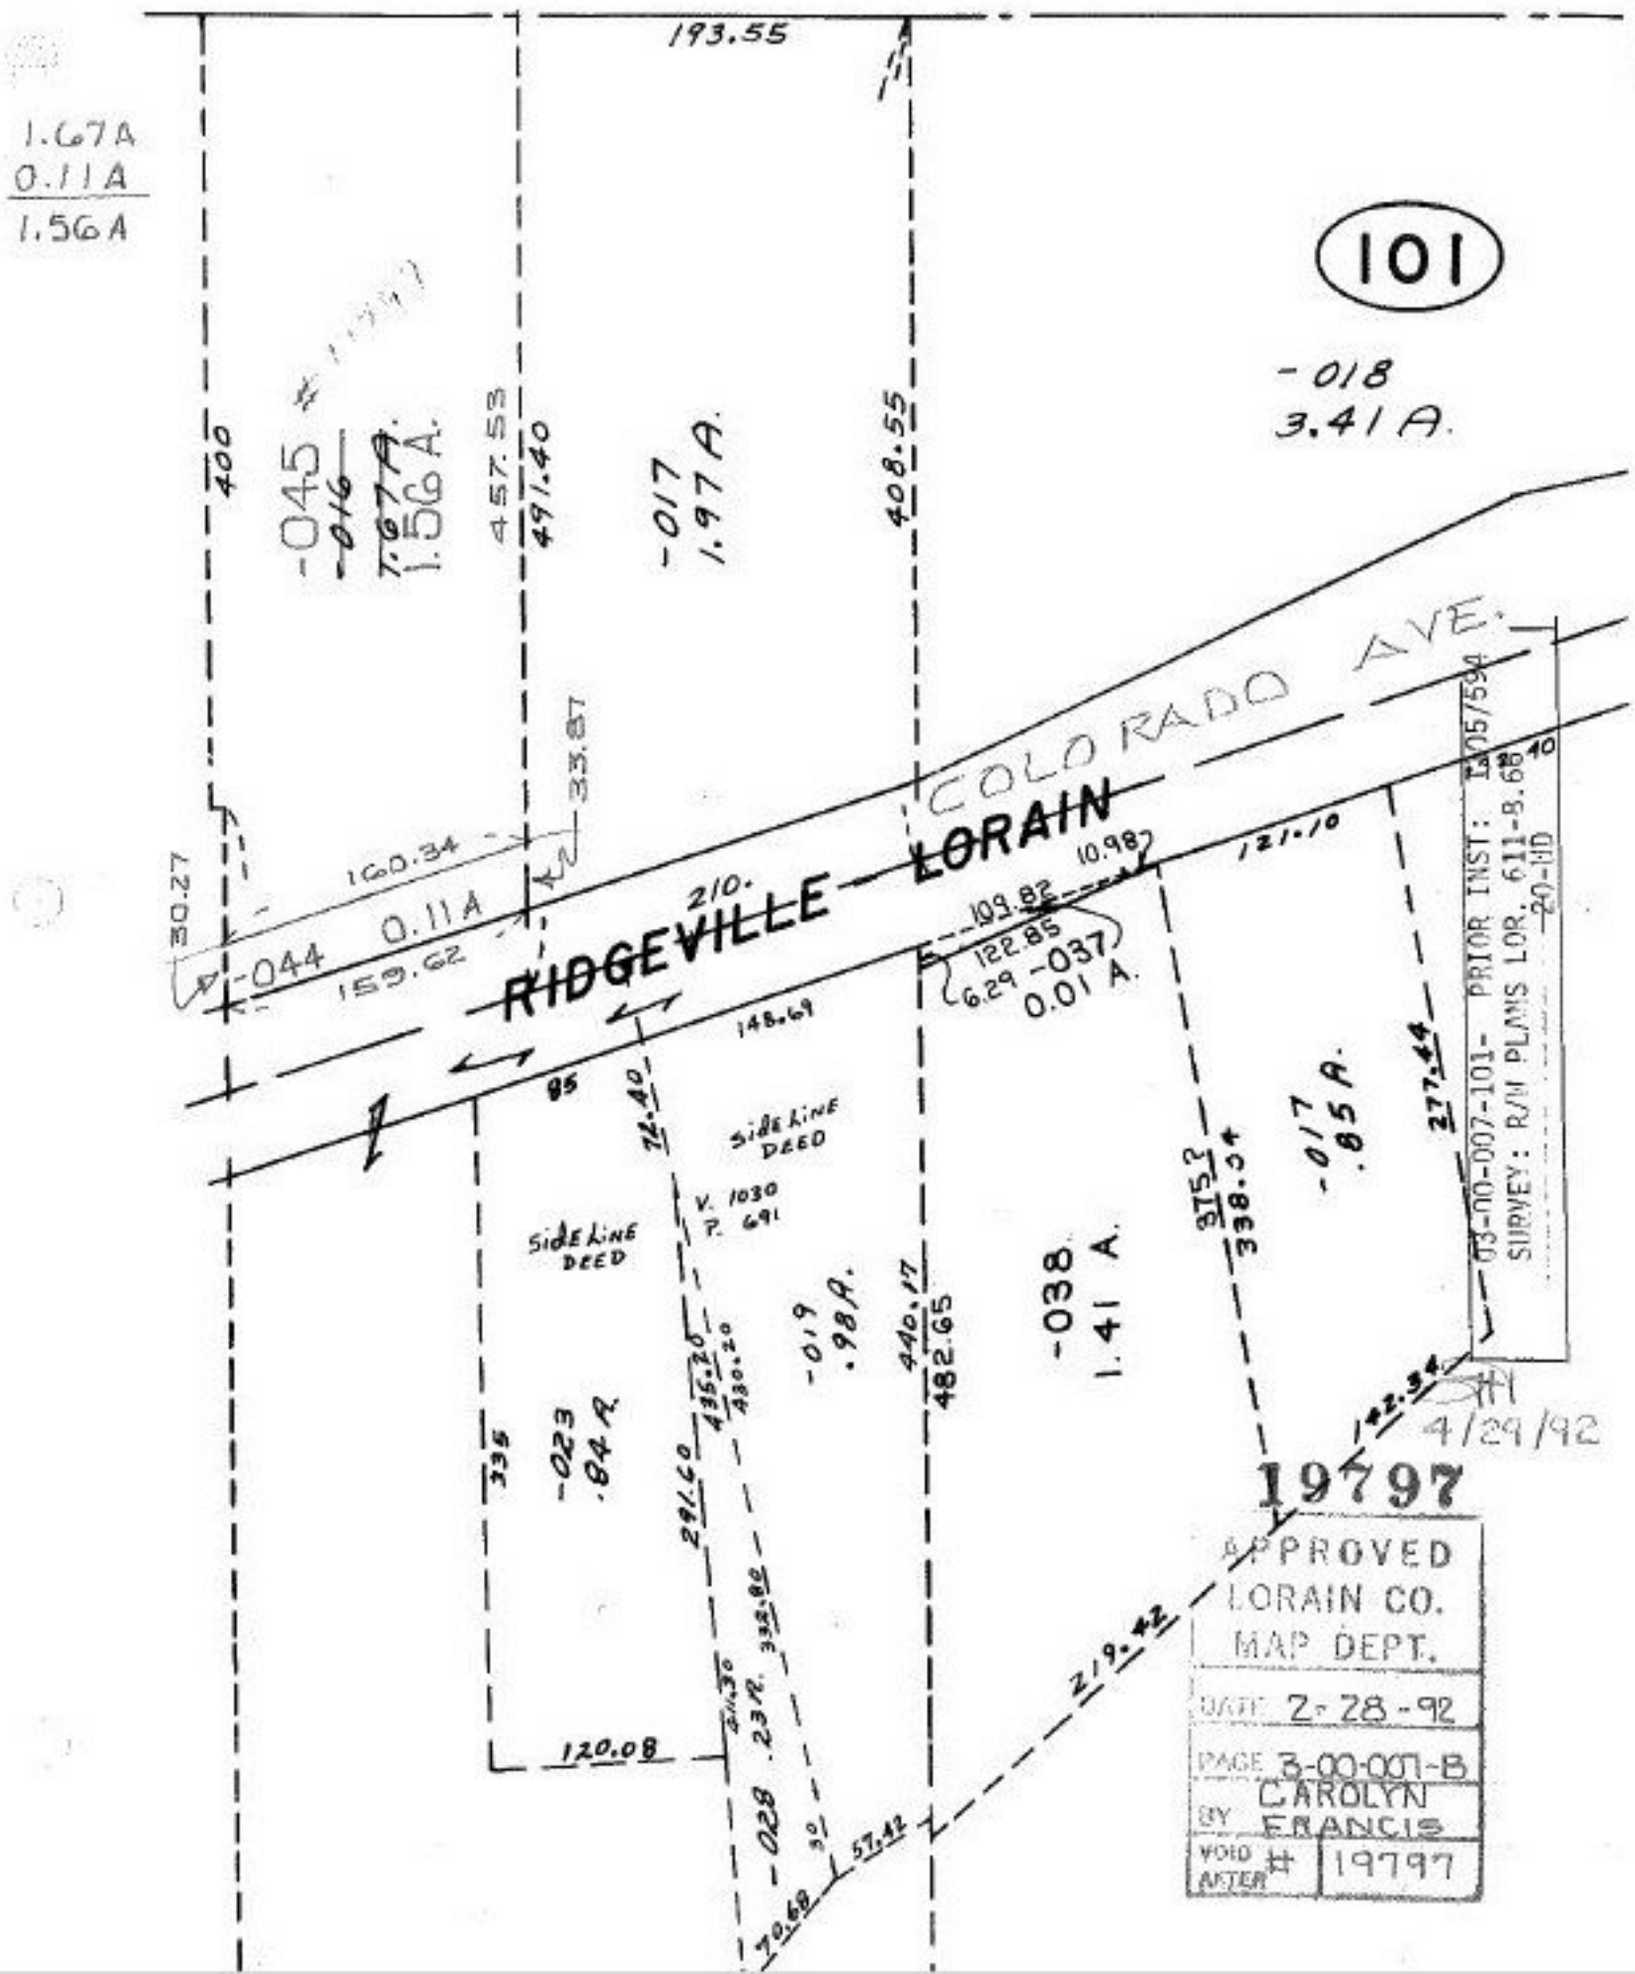

1.67A
0.11A
1.56A
193.55
101
-018
3.41 A.
400
-045
-016
1.67A.
1.56 A.
457.53
491.40
-017
1.97 A.
408.55
COLORADO AVE.
33.87
160.34
30.27
-044
0.11A
159.62
210.
RIDGEVILLE - LORAIN
10.98
121.10
109.82
122.85
6.29
-037
0.01 A.
148.69
85
72.40
SIDE LINE DEED
V. 1030
P. 691
SIDE LINE DEED
-019
.98A.
440.17
482.65
-038
1.41 A.
375?
338.34
-017
.85 A.
277.44
03-00-007-101- PRIOR INST: 1305/594
SURVEY: R/W PLANS LOR. 611-8.68
20-HD
335
-023
.84 A.
291.60
435.20
430.20
142.34
4/29/92
19797
APPROVED
LORAIN CO.
MAP DEPT.
DATE 2-28-92
PAGE 3-00-007-B
BY CAROLYN FRANCIS
VOID AFTER # 19797
219.42
120.08
-028
.23 A.
57.42
70.68