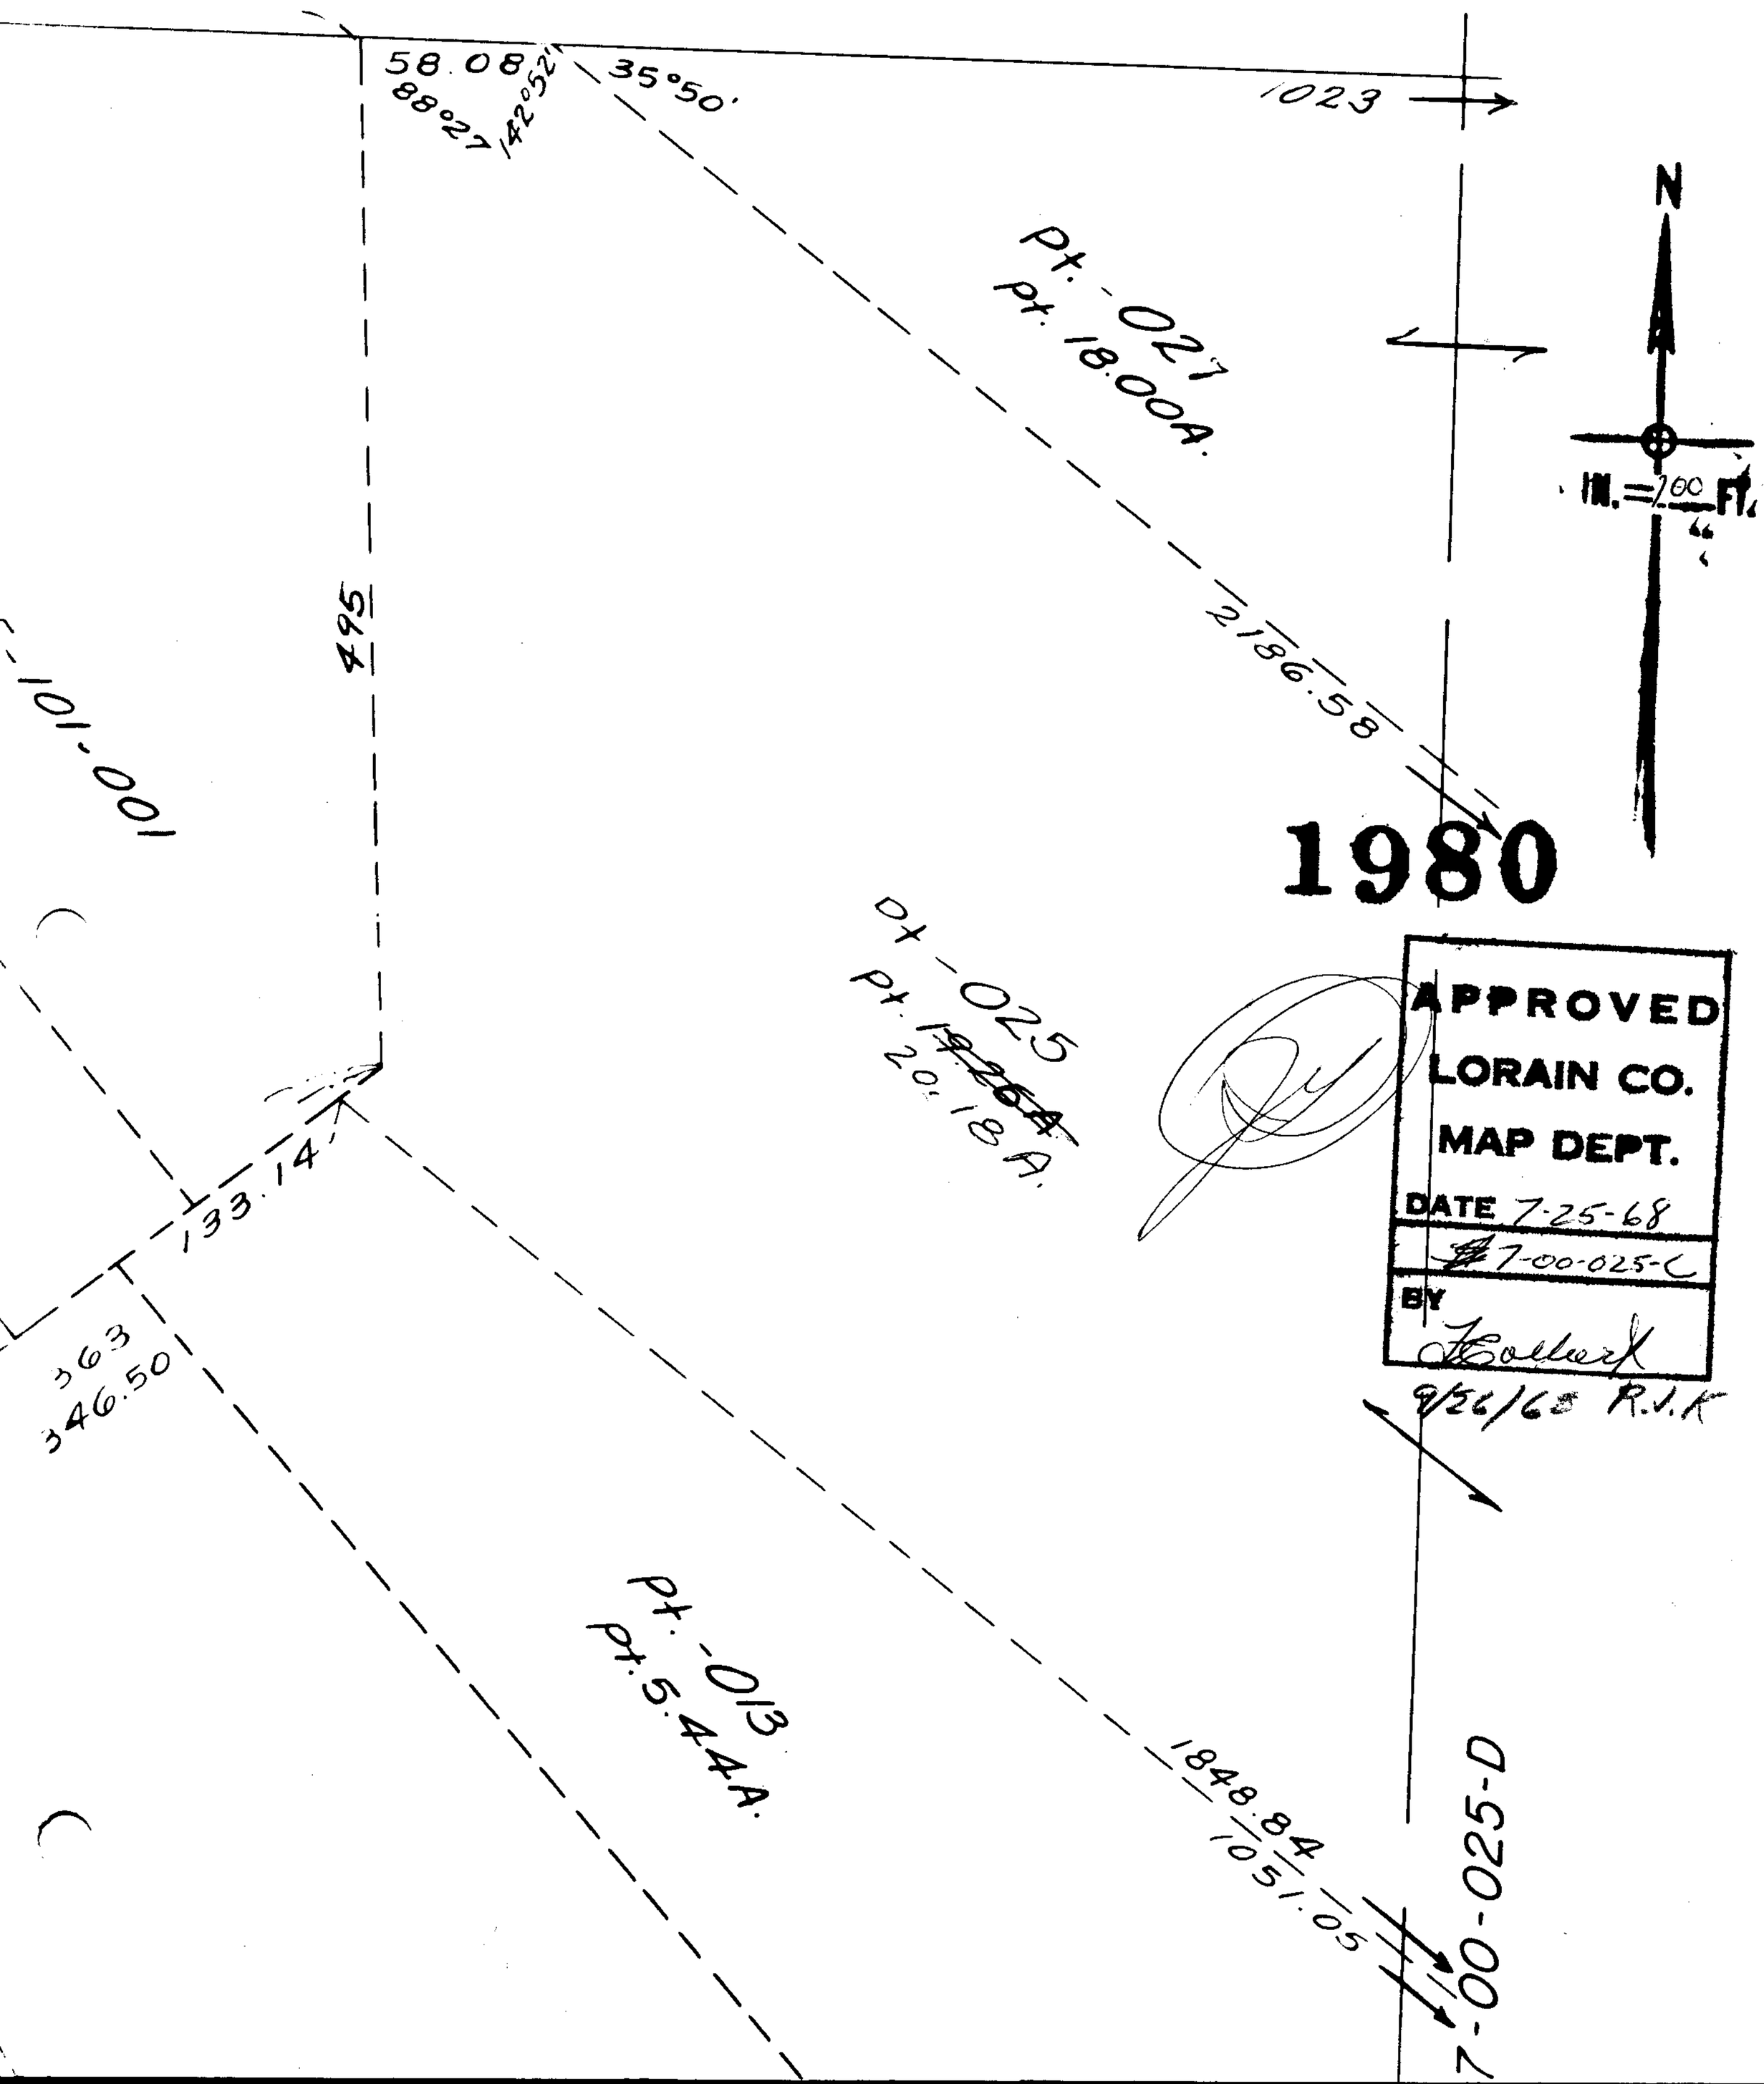
58.08
88°27
142°52'
35°50'
1023
Pt. -027
Pt. 18.00A.
N
IN. = 100 FT.
495
2186.58
1980
Pt -025
Pt. 19.26A
20.18A.
APPROVED
LORAIN CO.
MAP DEPT.
DATE 7-25-68
7-00-025-C
BY
9/26/68 R.J.K
133.14
363
346.50
Pt. -013
Pt. 5.44A.
1848.84
1051.05
7-00-025-D