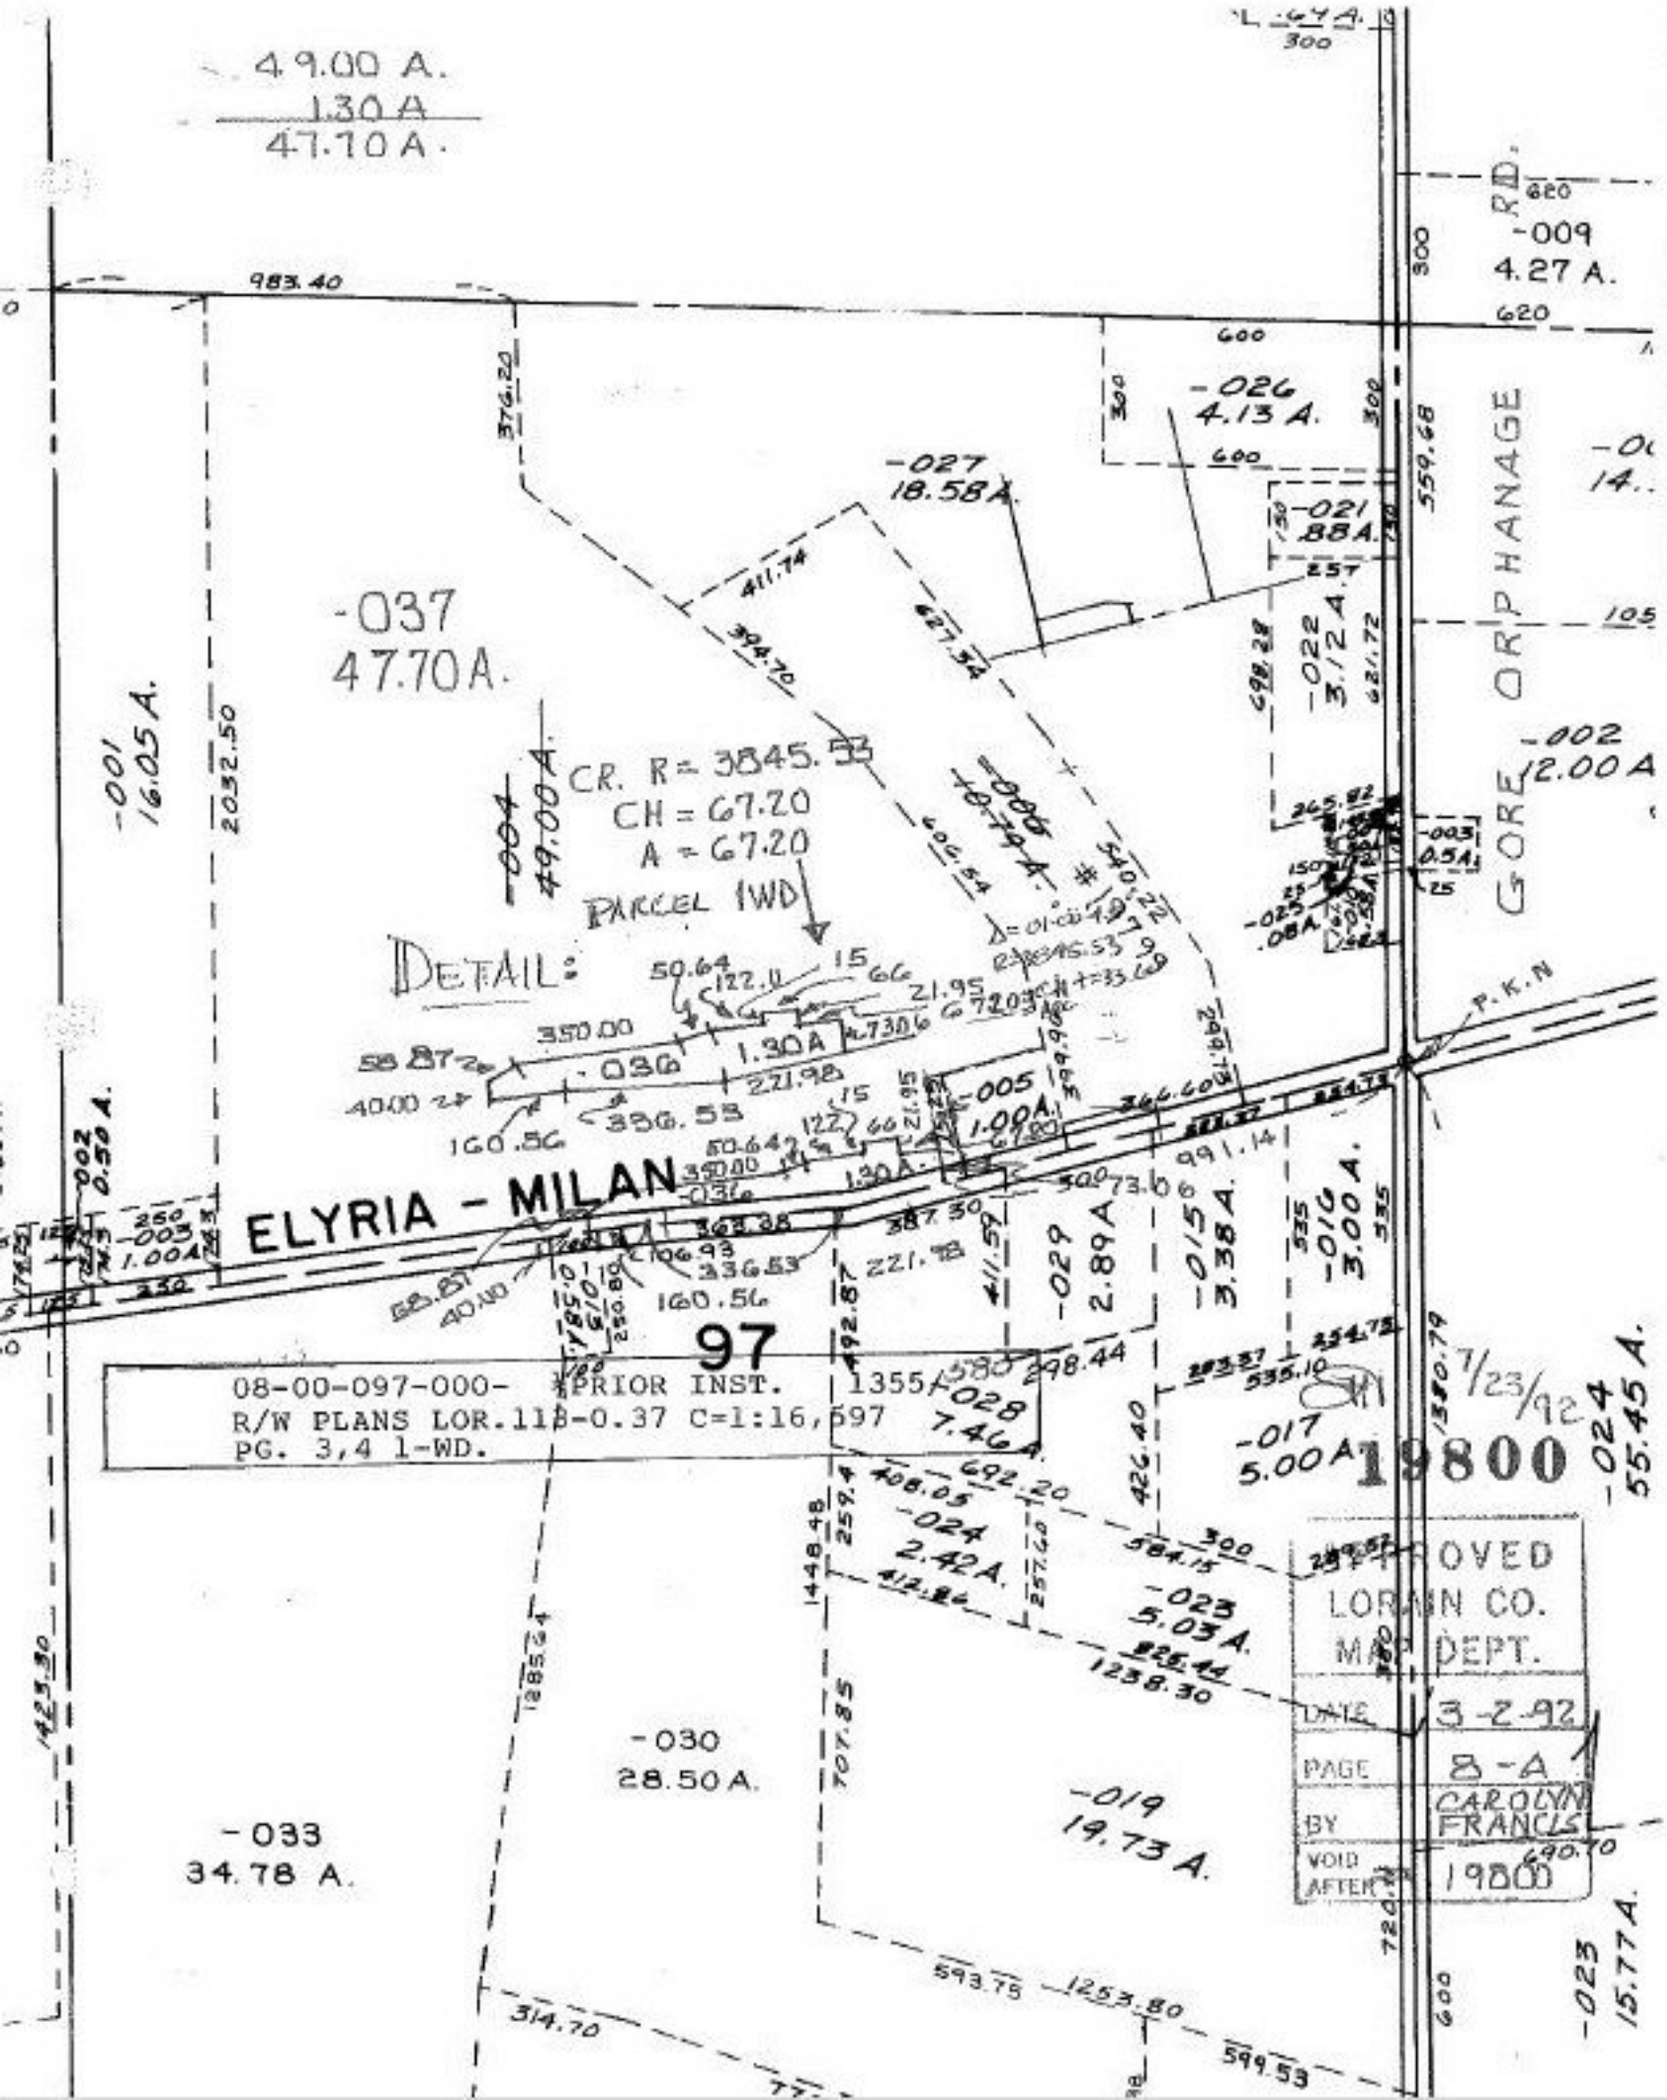

49.00 A.
1.30 A
47.70 A.
-037
47.70 A.
-001
16.05 A.
-004
49.00 A.
CR. R = 3845.53
CH = 67.20
A = 67.20
PARCEL 1WD
DETAIL:
-036
1.30 A
-005
1.00 A.
ELYRIA - MILAN
97
08-00-097-000- PRIOR INST. 1355/
R/W PLANS LOR.113-0.37 C=1:16,597
PG. 3,4 1-WD.
-027
18.58 A.
-026
4.13 A.
-021
.88 A.
-022
3.12 A.
-009
4.27 A.
-002
12.00 A
GORE ORPHANAGE RD.
P.K.N
-029
2.89 A
-015
3.38 A.
-016
3.00 A.
-017
5.00 A
-028
7.46 A.
-024
2.42 A.
-023
5.03 A.
-030
28.50 A.
-019
19.73 A.
-033
34.78 A.
-024
55.45 A.
-023
15.77 A.
7/23/92
19800
APPROVED
LORAIN CO.
MAP DEPT.
DATE 3-2-92
PAGE 8-A
BY CAROLYN FRANCIS
VOID AFTER 19800