610.66

Pt. -024
Pt. 73.36 A.

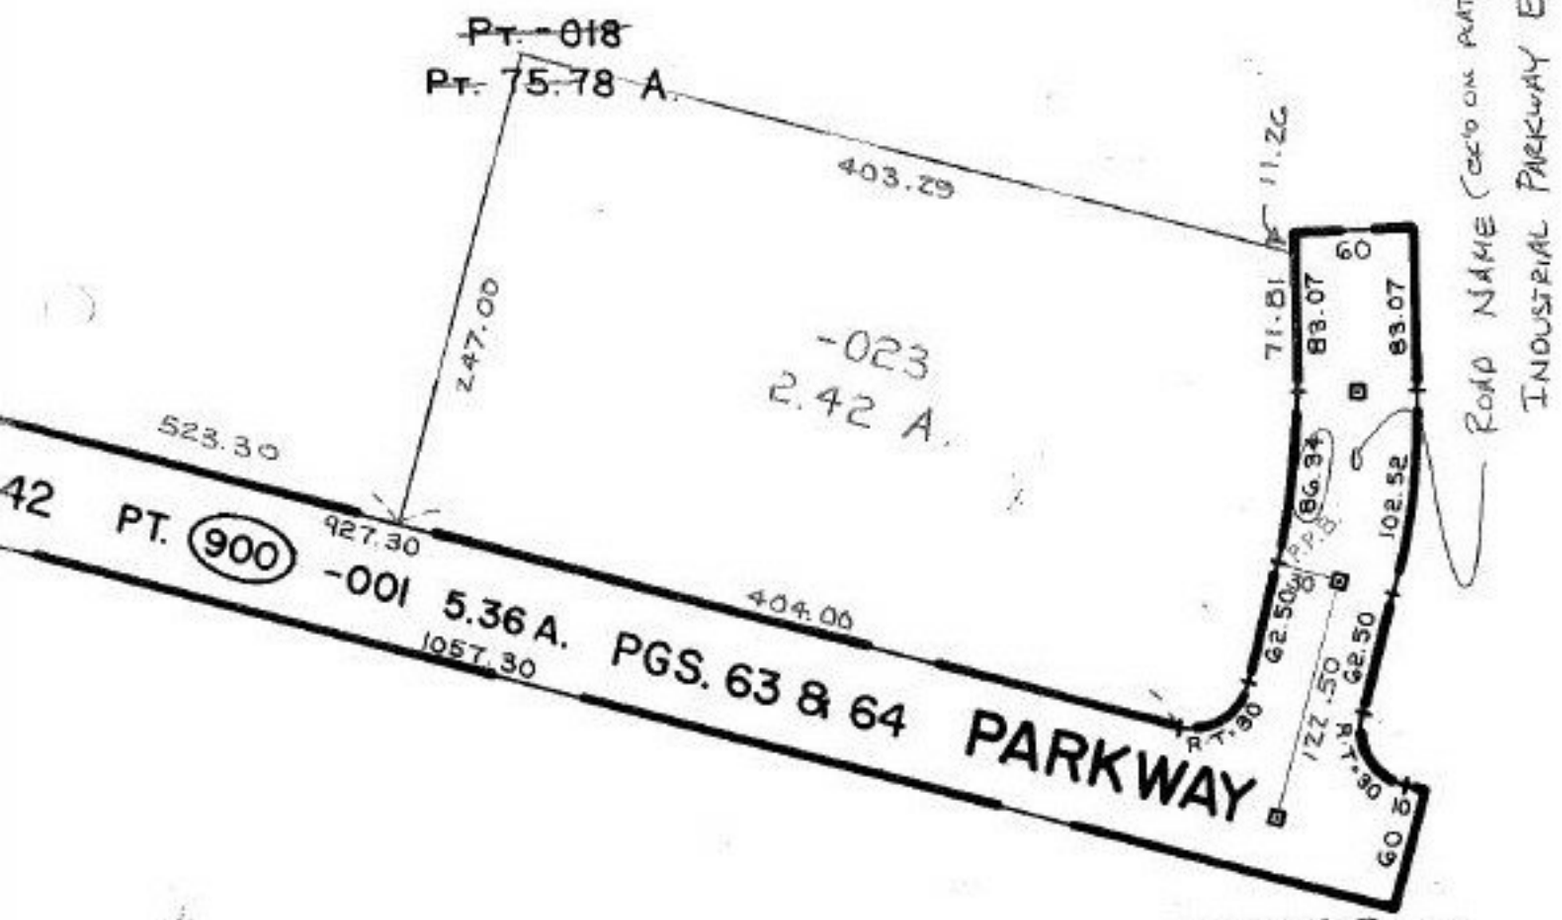

19802

01-00-023-000- PRIOR INST: 1404/519
SURVEYED BY KS ASSOC. C=1: 10,302

APPROVED
LORAIN CO.
MAP DEPT.
DATE 2-26-92
PAGE 1-00-023-B1
BY FRANCIS
VOID # 19802

4/10/92

CAROLYN ST. HOLLIS

1-00-024-A