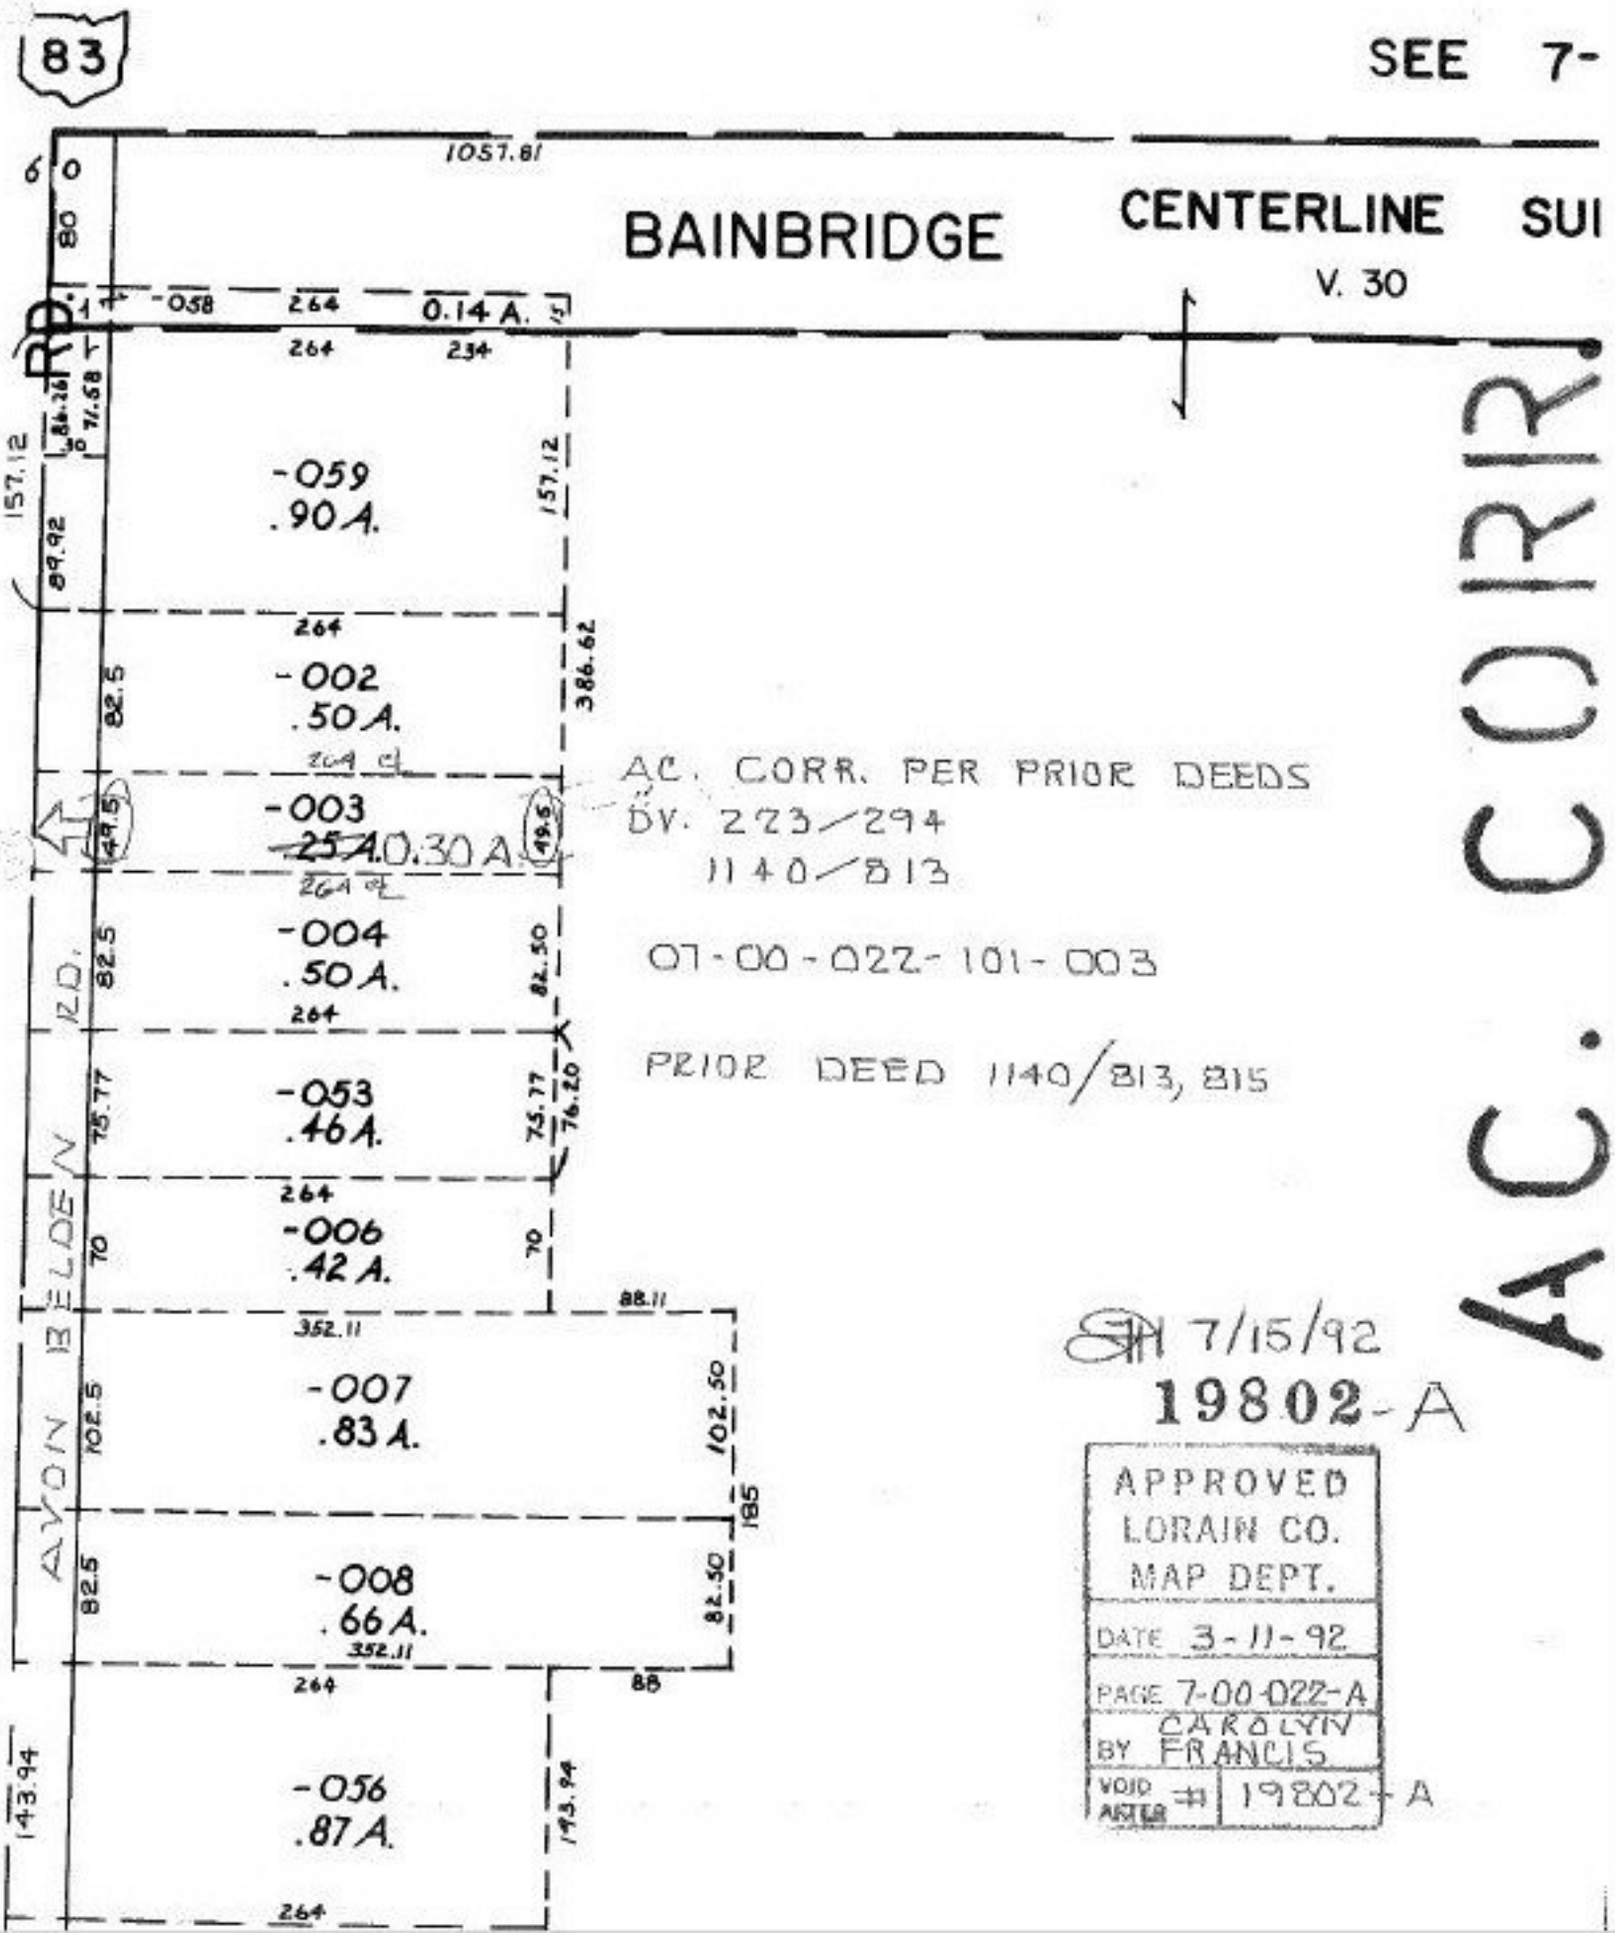
83
SEE 7-
BAINBRIDGE
CENTERLINE SUI
V. 30
1057.81
80
-058
264
0.14 A.
234
RD.
-059
.90 A.
157.12
89.92
-002
.50 A.
386.62
264 ℄
-003
~~.25 A.~~ 0.30 A.
49.5
264 ℄
-004
.50 A.
82.5
82.50
-053
.46 A.
75.77
76.20
-006
.42 A.
70
88.11
352.11
-007
.83 A.
102.5
102.50
185
-008
.66 A.
82.5
82.50
352.11
264
88
-056
.87 A.
143.94
AVON BELDEN RD.
AC. CORR. PER PRIOR DEEDS
DV. 223/294
1140/813
07-00-022-101-003
PRIOR DEED 1140/813, 815
AC. CORR.
7/15/92
19802-A
APPROVED
LORAIN CO.
MAP DEPT.
DATE 3-11-92
PAGE 7-00-022-A
BY CAROLYN FRANCIS
VOID AFTER # 19802-A