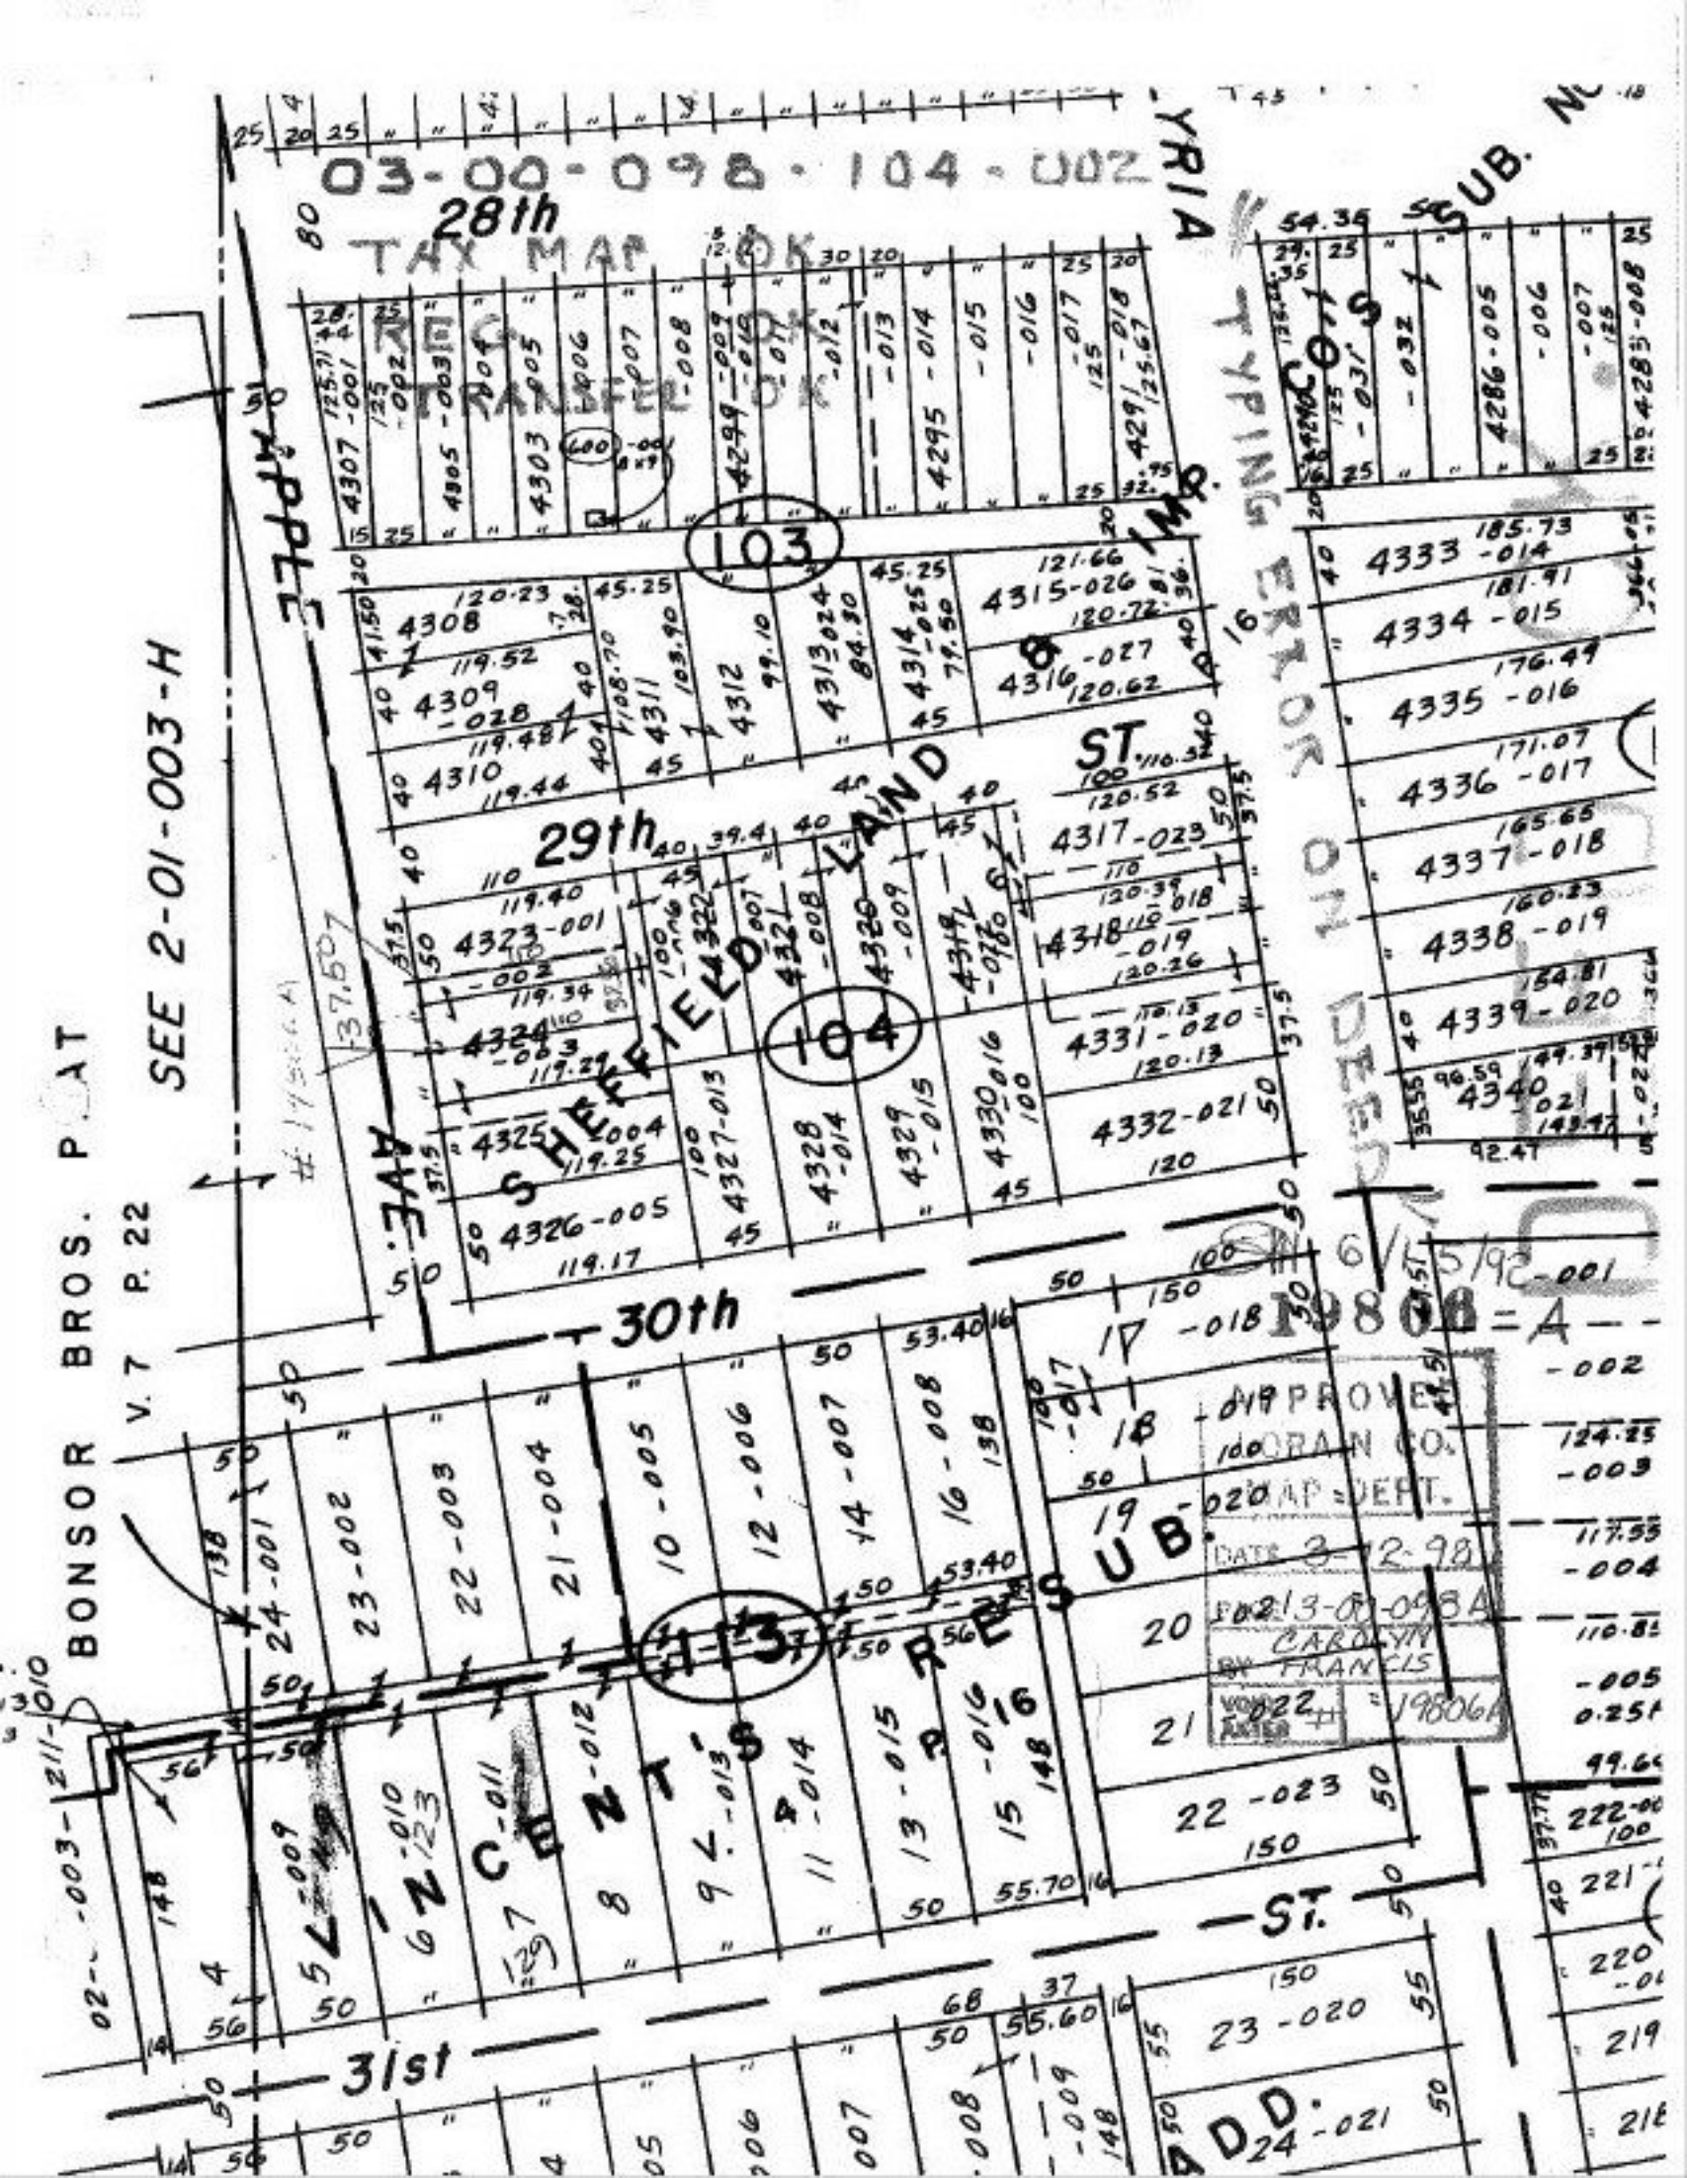
03-00-098-104-002
TAX MAP OK
28th
29th
30th
31st
SEE 2-01-003-H
BONSOR BROS. PLAT
V. 7 P. 22
SHEFFIELD LAND
SUB.
103
104
113
ST.
4307-001
4308
4309-028
4310
4311
4312
4313-024
4314-025
4315-026
4316-027
4317-023
4318-019
4319
4320-009
4321-008
4322-007
4323-001
4324-003
4325-004
4326-005
4327-013
4328-014
4329-015
4330-016
4331-020
4332-021
4333-014
4334-015
4335-016
4336-017
4337-018
4338-019
4339-020
4340-021
4286-005
4285-008
4286-031
4286-032
4286-006
4286-007
4299-009
4299-010
4299-011
4299-012
4299-013
4295-014
4295-015
4295-016
4295-017
4295-018
4303-005
4303-006
4303-007
4303-008
4305-003
4305-004
4307-001
4307-002
