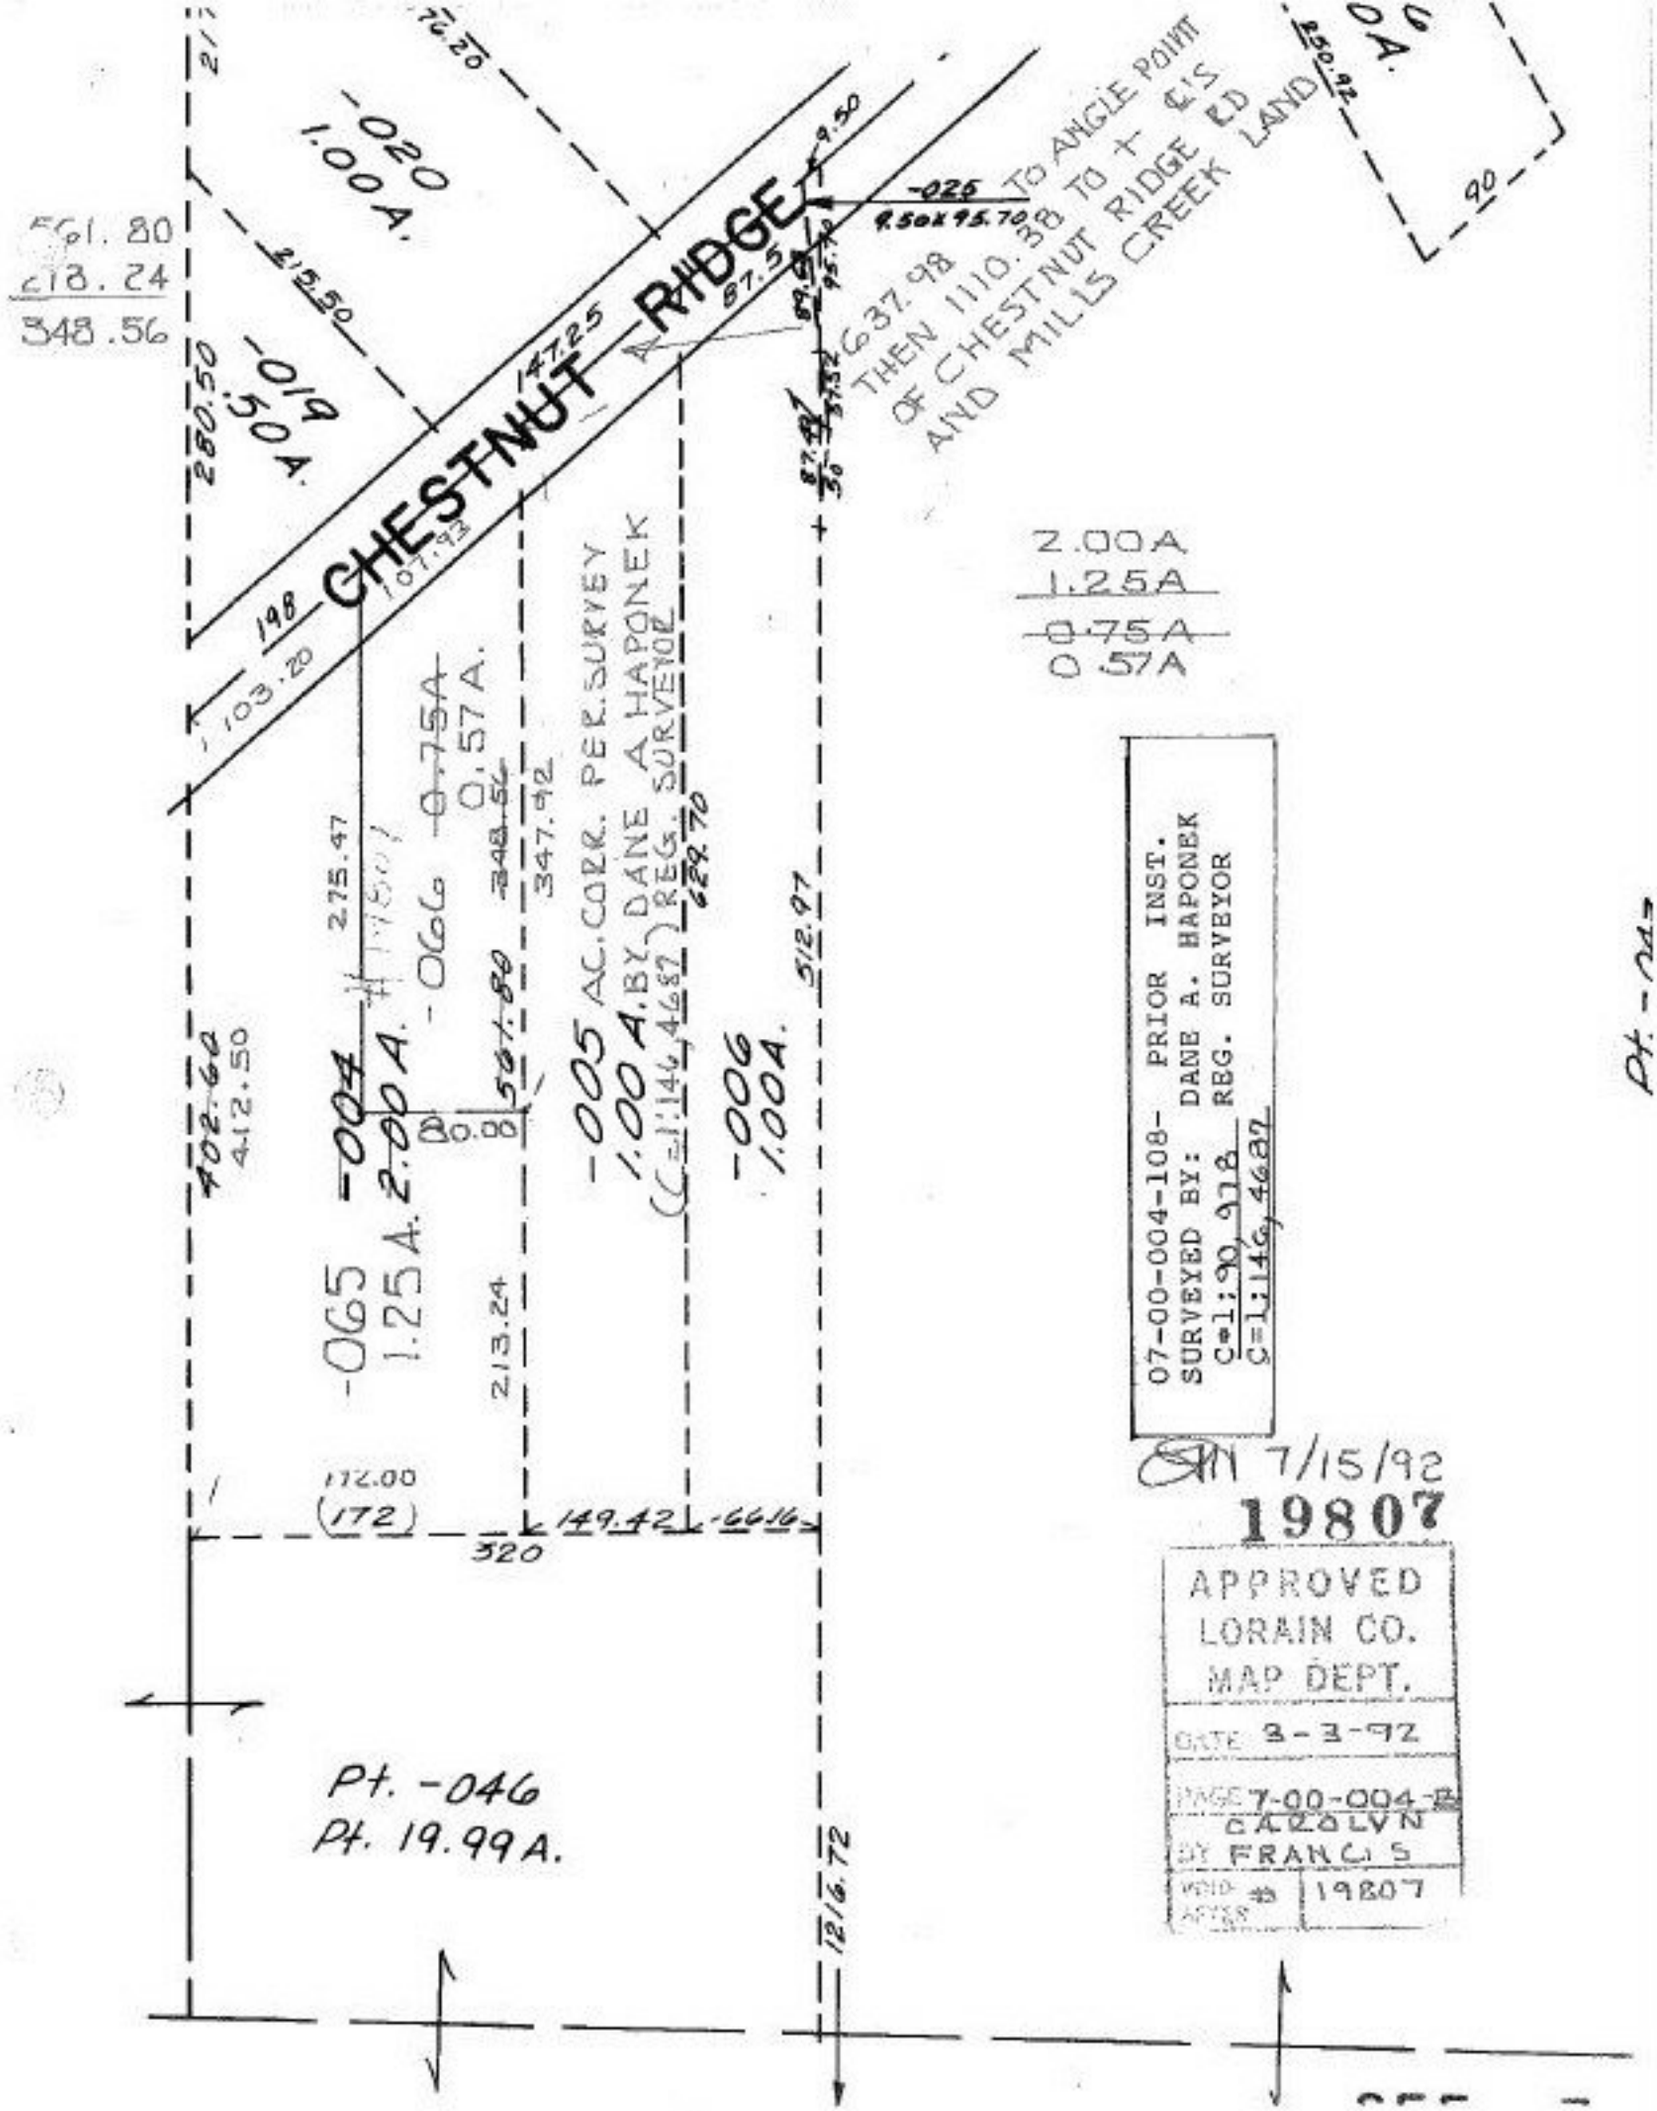

CHESTNUT RIDGE
-020
1.00A.
-019
.50A.
561.80
218.24
348.56
280.50
215.50
147.25
87.5
9.50
-025
9.50x95.70
TO ANGLE POINT
637.98
THEN 1110.38 TO + ℄'S
OF CHESTNUT RIDGE RD
AND MILLS CREEK LAND
250.92
90
198
103.20
107.93
2.00A
1.25A
~~0.75A~~
0.57A
-066 ~~0.75A~~
0.57A.
348.56
347.92
275.47
-005 AC. CORR. PER SURVEY
1.00 A. BY DANE A HAPONEK
(C=1:146,4687) REG. SURVEYOR
629.70
512.97
-006
1.00A.
402.60
412.50
-004
2.00A.
561.80
80.00
-065
1.25A.
213.24
172.00
(172)
149.42
-66.16
320
1216.72
Pt. -046
Pt. 19.99A.
07-00-004-108- PRIOR INST.
SURVEYED BY: DANE A. HAPONEK
C=1:90,978 REG. SURVEYOR
C=1:146,4687
7/15/92
19807
APPROVED
LORAIN CO.
MAP DEPT.
DATE 3-3-92
PAGE 7-00-004-B
CAROLYN
BY FRANCIS
VOID AFTER # 19807