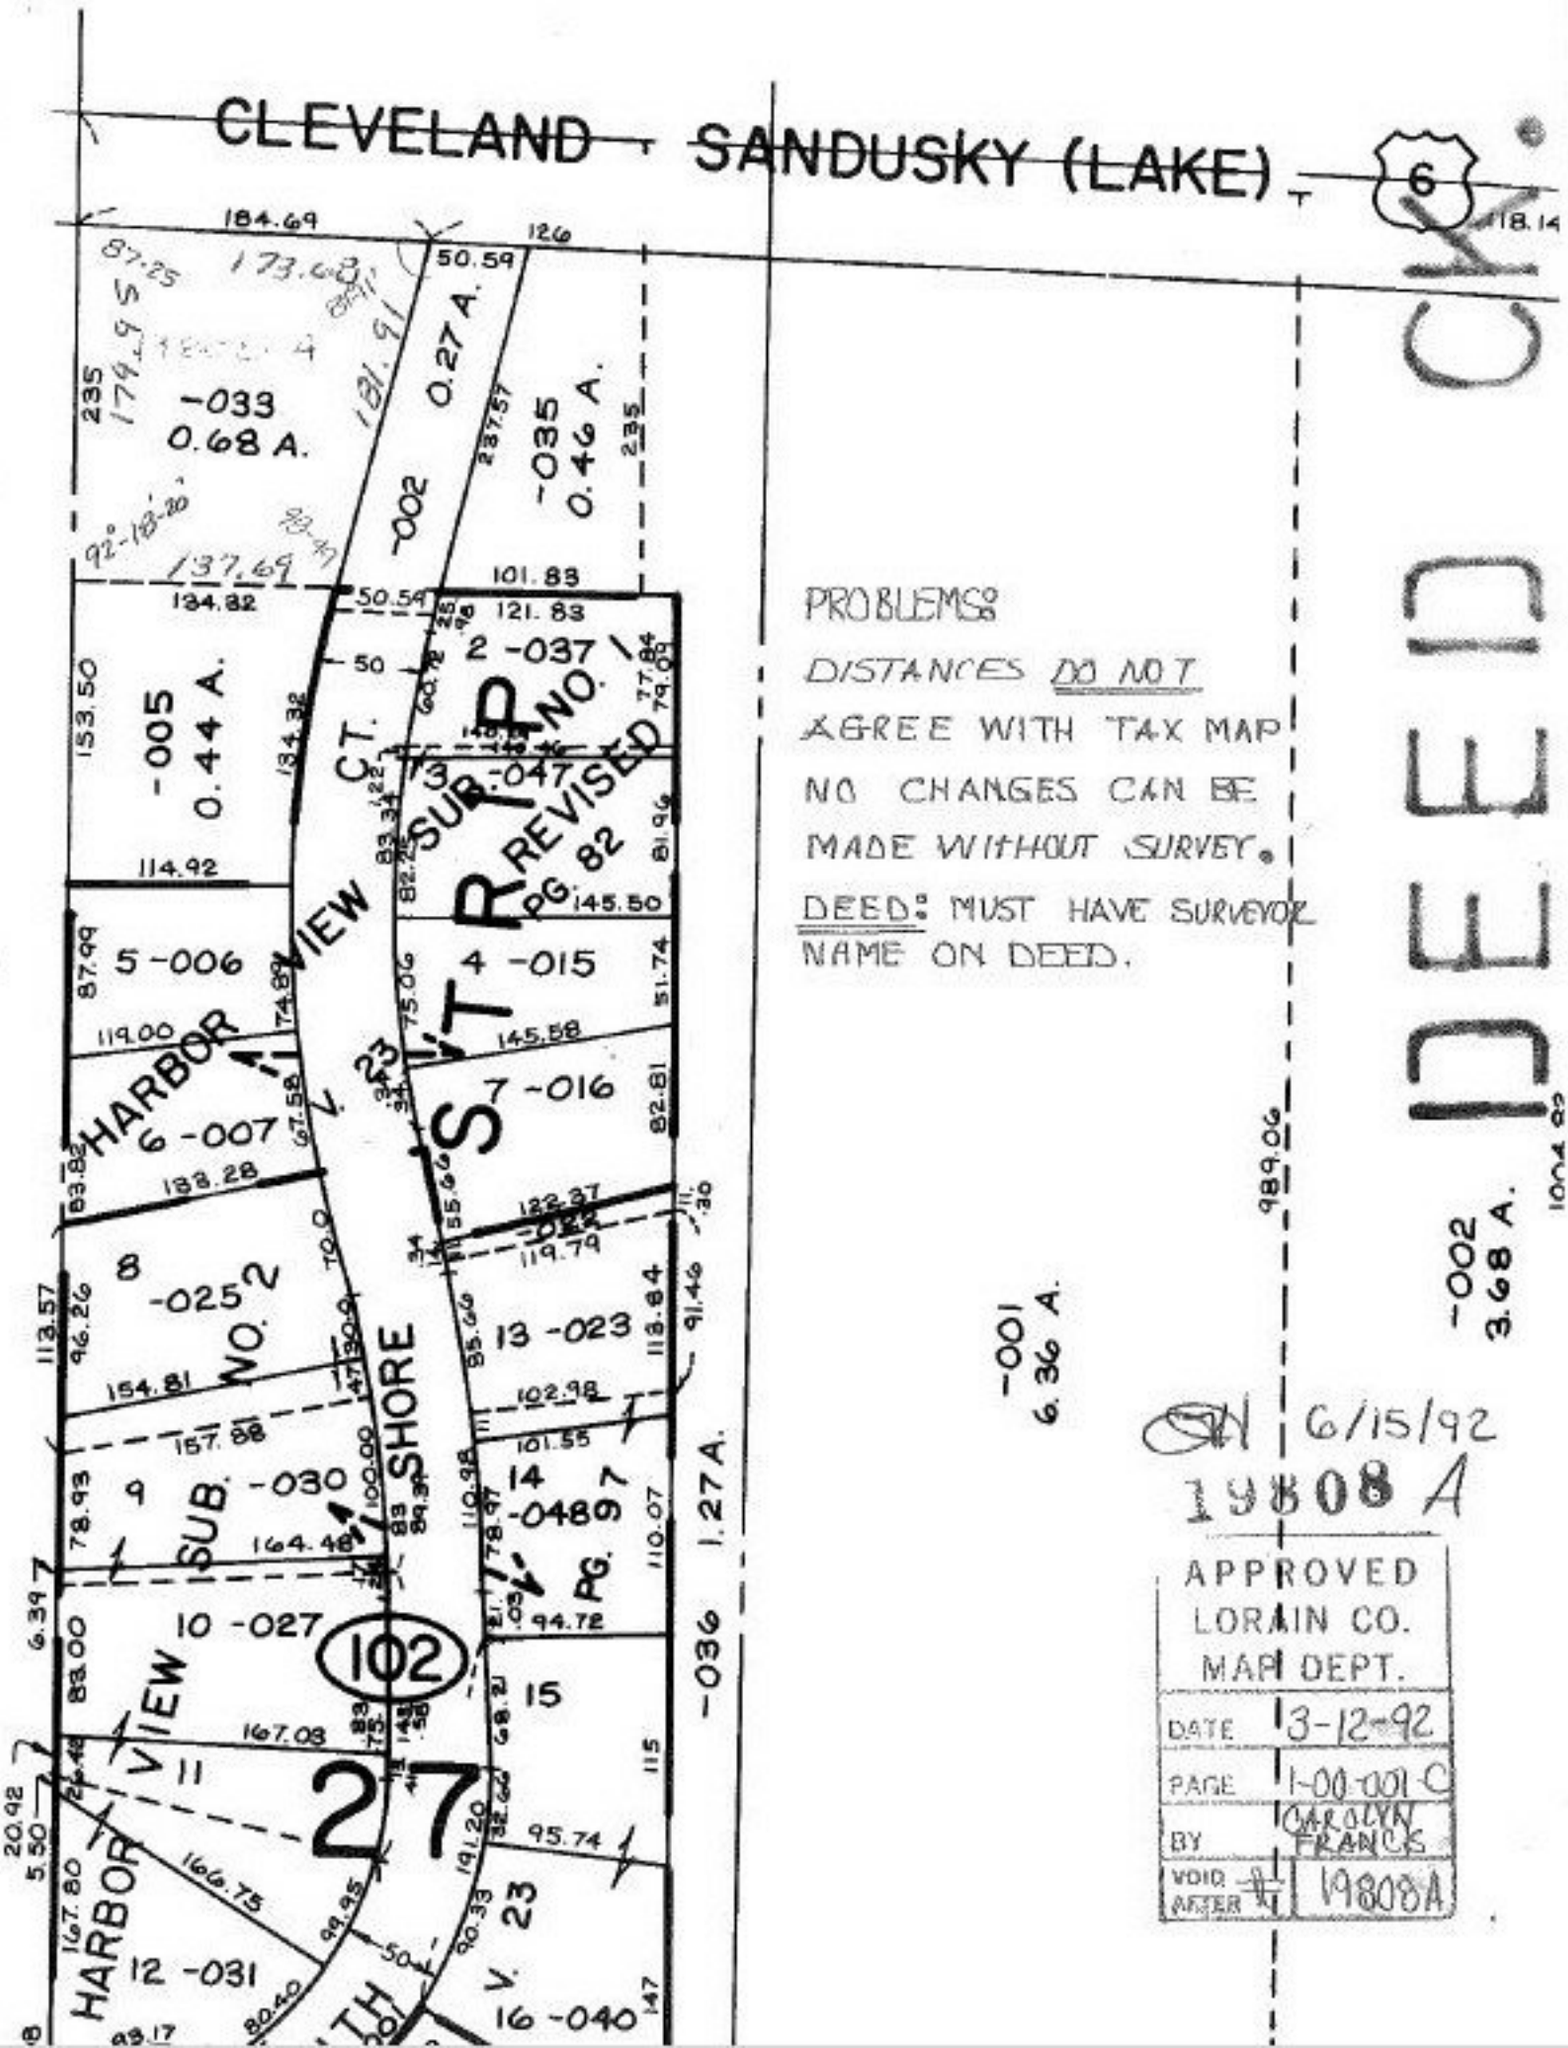
CLEVELAND - SANDUSKY (LAKE)
6
DEED CK.
-033
0.68 A.
-002
0.27 A.
-035
0.46 A.
-005
0.44 A.
2 -037
3 -047
4 -015
5 -006
6 -007
7 -016
8 -025
9 -030
10 -027
11
12 -031
13 -023
14 -048
15
16 -040
HARBOR VIEW SUB. NO. 1
HARBOR VIEW SUB. NO. 2
SHORE CT.
STRIP
REVISED PG. 82
V. 23
PG. 97
102
27
-001
6.36 A.
-002
3.68 A.
-036
1.27 A.
PROBLEMS:
DISTANCES DO NOT AGREE WITH TAX MAP
NO CHANGES CAN BE MADE WITHOUT SURVEY.
DEED: MUST HAVE SURVEYOR NAME ON DEED.
6/15/92
19808 A
APPROVED
LORAIN CO.
MAP DEPT.
DATE 3-12-92
PAGE 1-00-001-C
BY CAROLYN FRANCIS
VOID AFTER 19808A