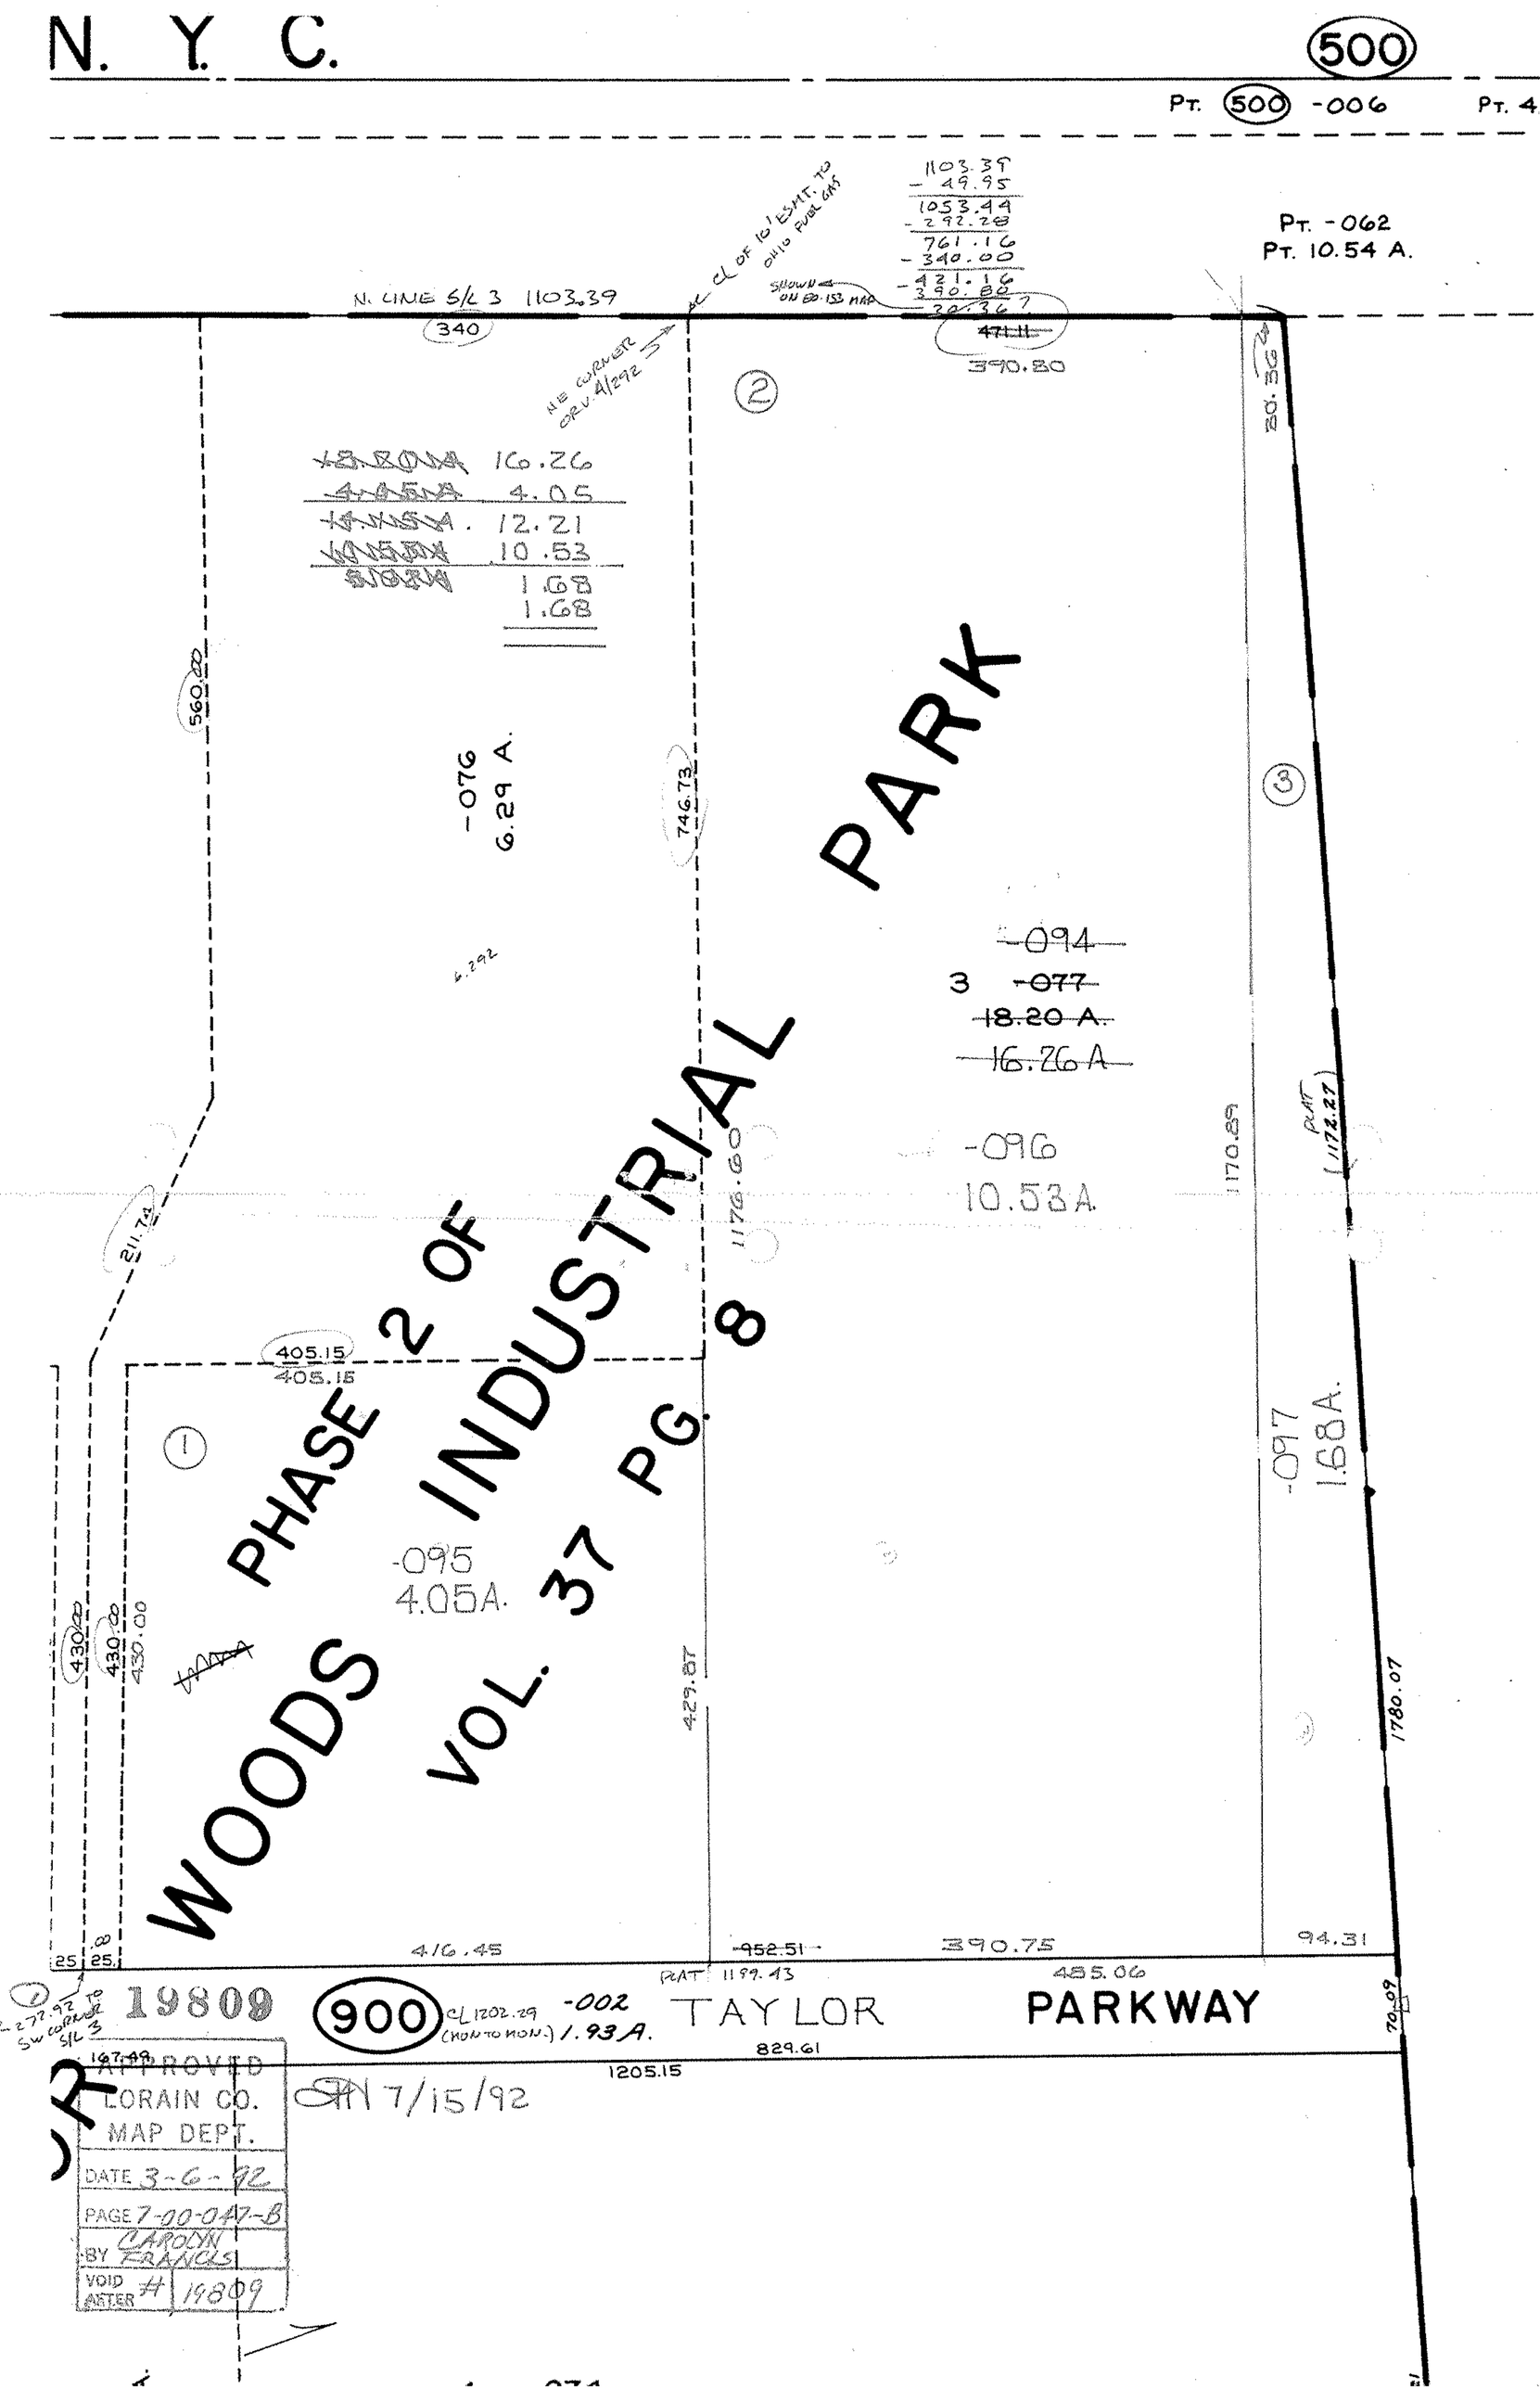
N. Y. C.
500
PT. 500 -006
PT. 4
PT. -062
PT. 10.54 A.
1103.39
- 49.95
1053.44
- 292.28
761.16
- 340.00
421.16
- 390.80
30.36
471.11
390.80
N. LINE S/L 3 1103.39
340
CL OF 10' ESMT. TO OHIO FUEL GAS
SHOWN ON BO-153 MAP
NE CORNER ORV. 4/292
2
16.26
4.05
12.21
10.53
1.68
1.68
560.00
-076
6.29 A.
746.73
3
-094
3 -077
18.20 A.
16.26 A
-096
10.53 A.
1176.60
1170.89
PLAT (1172.27)
211.74
405.15
405.15
1
-095
4.05A.
-097
1.68A.
430.00
430.00
430.00
429.87
1780.07
WOODS PHASE 2 OF INDUSTRIAL PARK
VOL. 37 PG. 8
25
25.
416.45
952.51
390.75
94.31
PLAT 1199.43
485.06
19809
900
CL 1202.29 (MON TO MON.)
-002
1.93 A.
TAYLOR
PARKWAY
70.09
829.61
1205.15
167.49
APPROVED
LORAIN CO.
MAP DEPT.
DATE 3-6-92
PAGE 7-00-047-B
BY CAROLYN FRANCIS
VOID AFTER # 19809
7/15/92