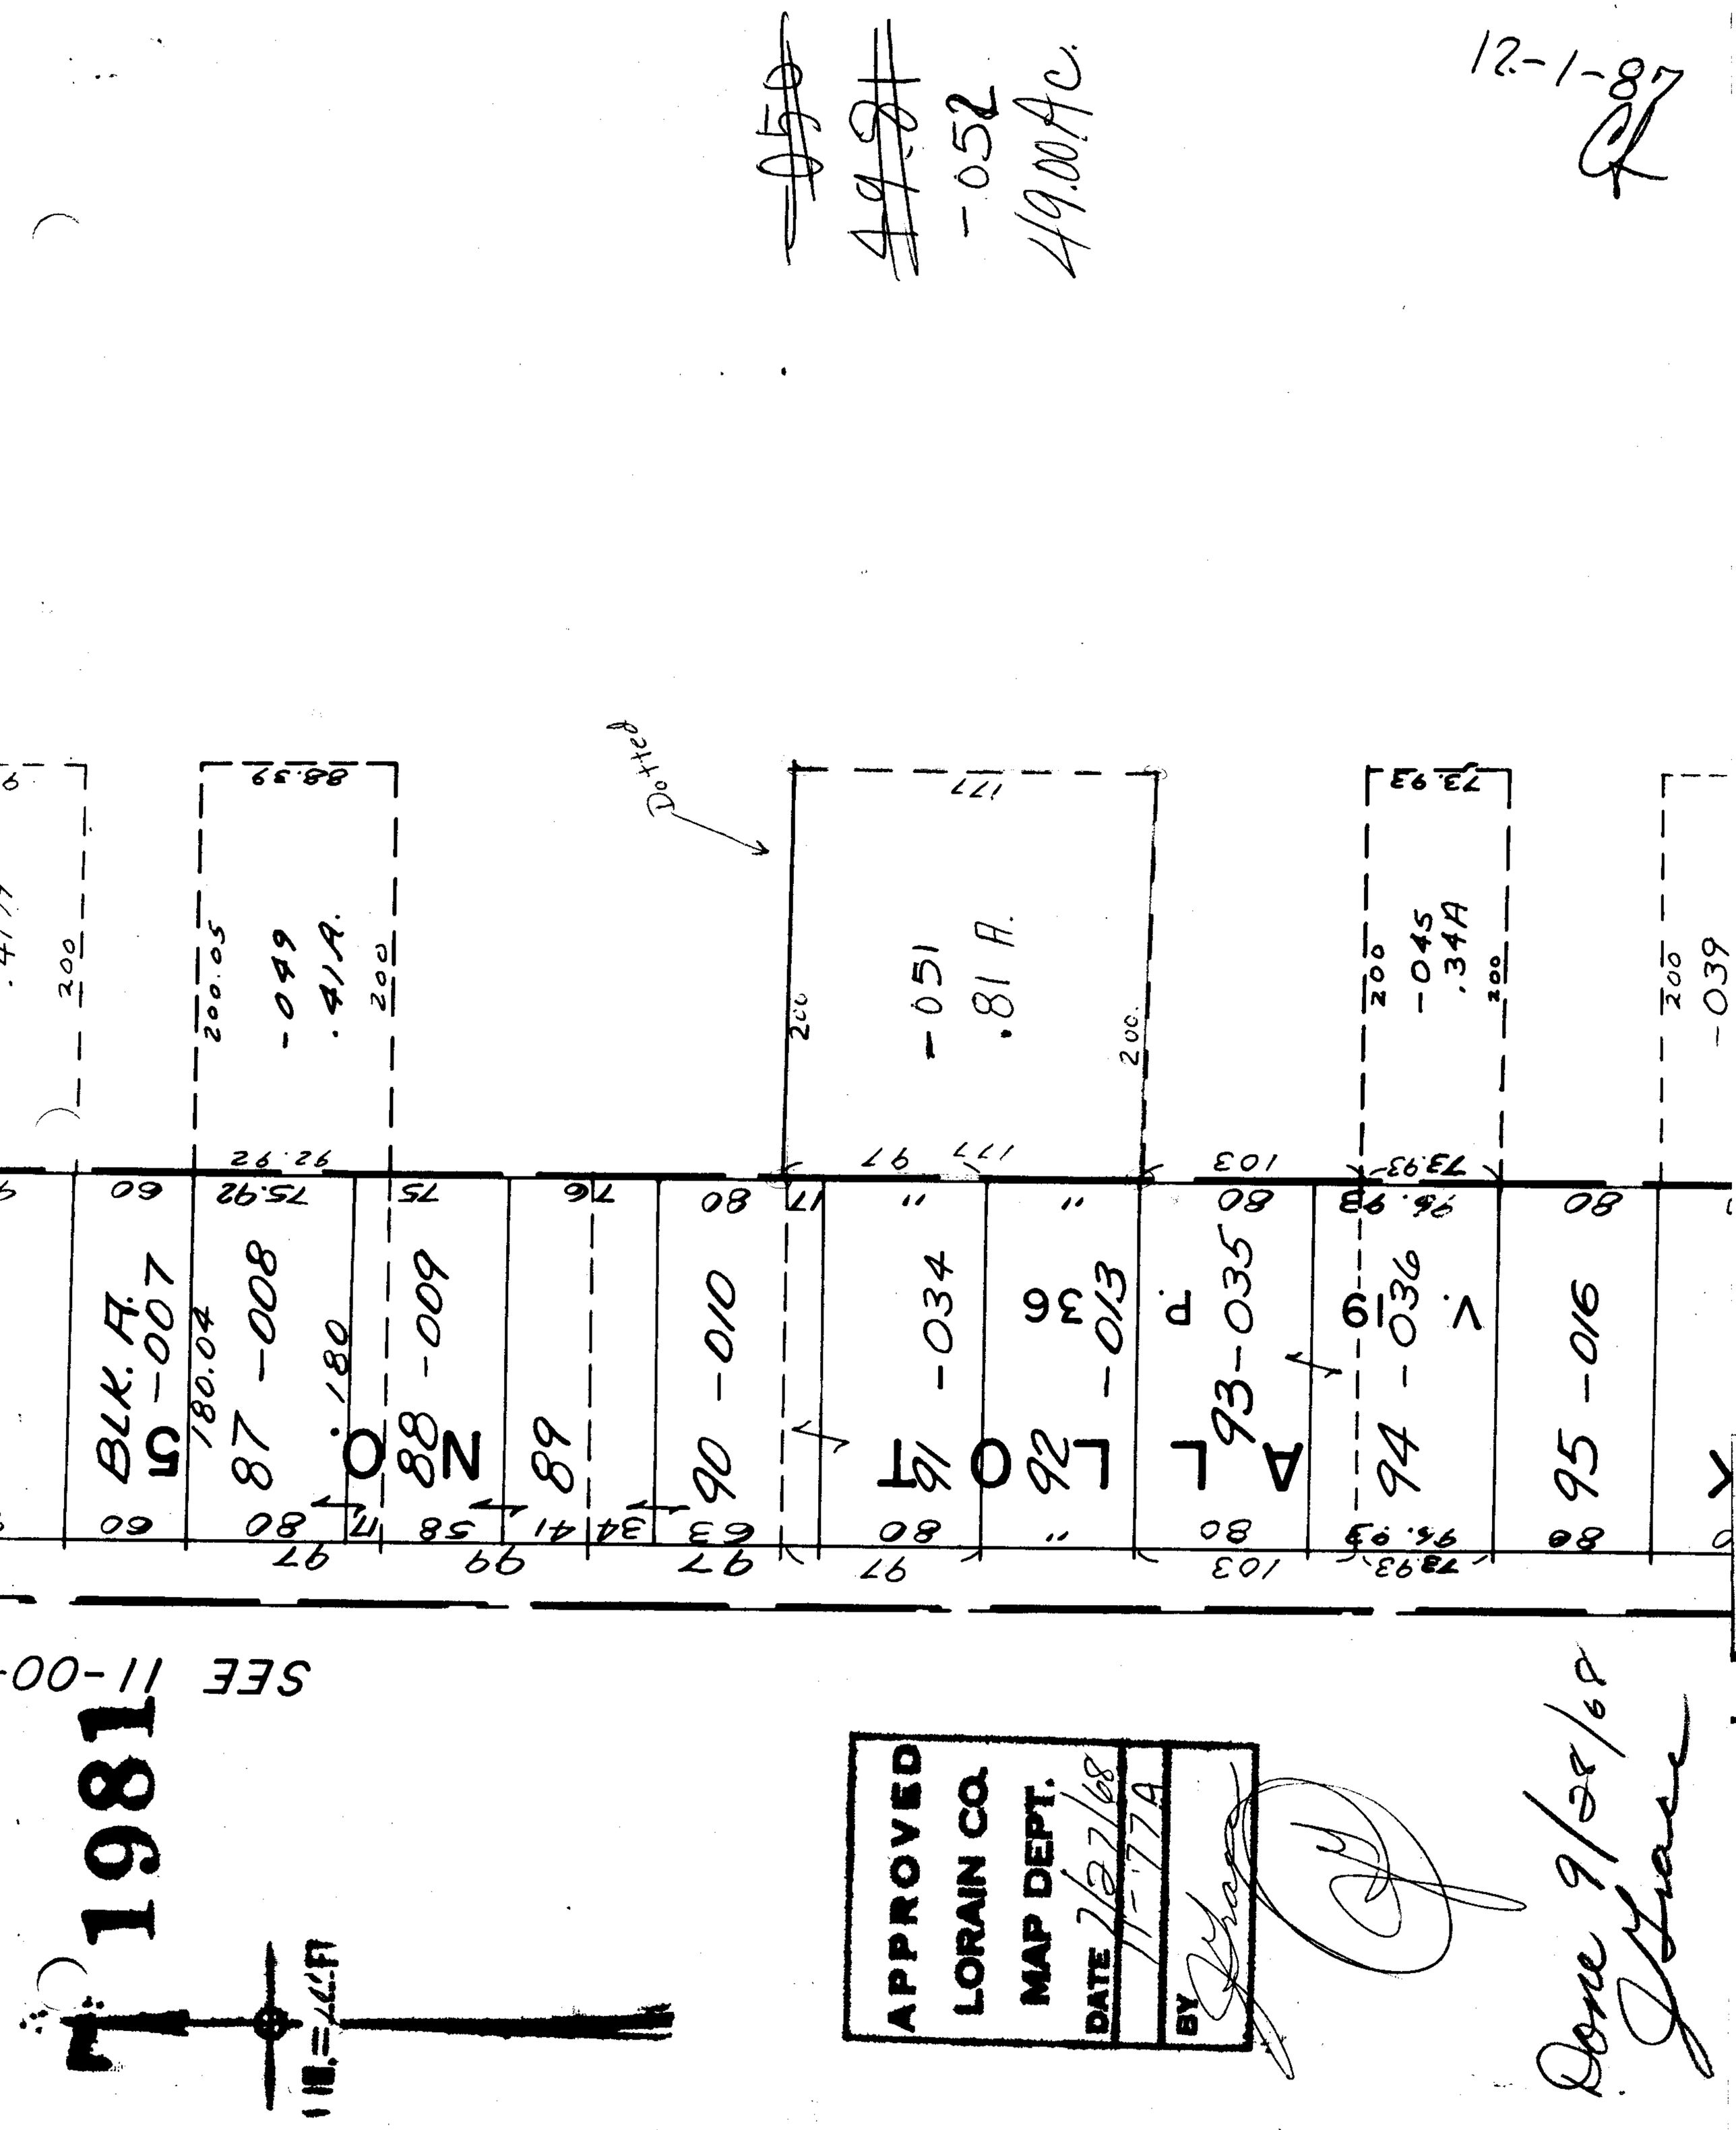

12-1-87
~~050~~
~~49.81~~
-052
49.00 Ac.
Dotted
BLK. A.
5 -007
87 -008
88 -009
89
90 -010
91 -034
92 -013
93 -035
94 -036
95 -016
NO. 180
ALLOT 36 P.
V. 19
-049
.41 A.
-051
.81 A.
-045
.34 A
-039
SEE 11-00-
1981
APPROVED
LORAIN CO.
MAP DEPT.
DATE 7/27/68
11-77A
BY
Done 9/28/68