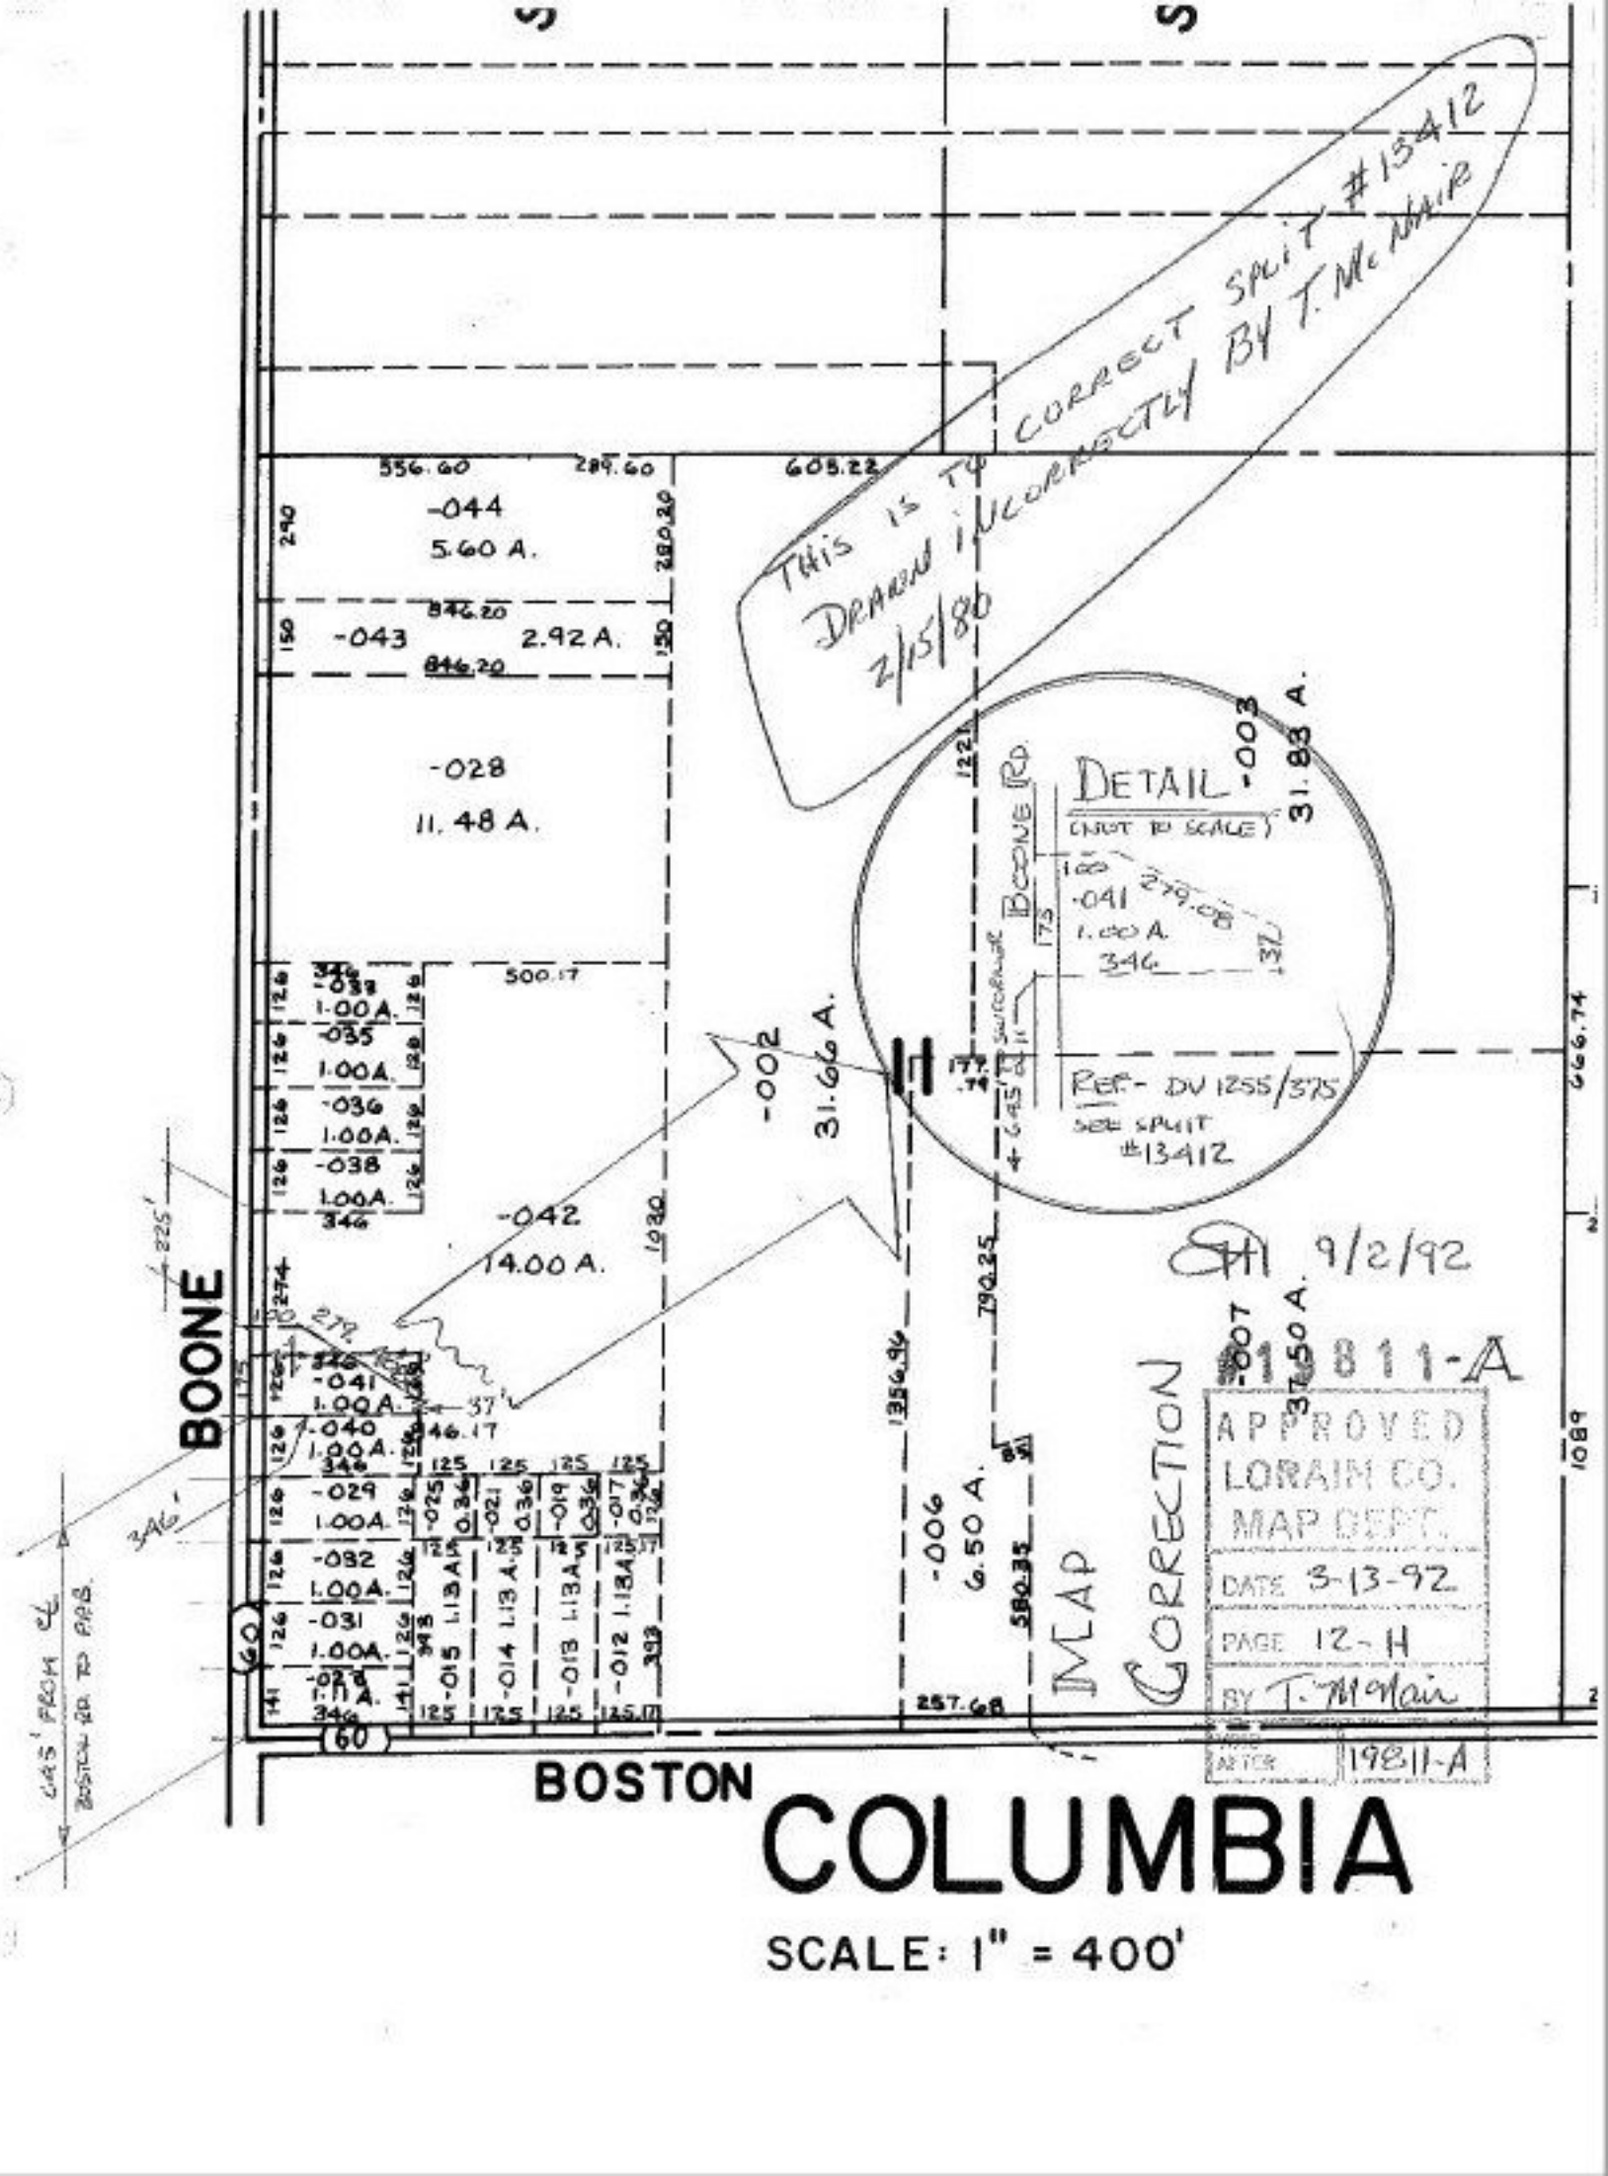
THIS IS TO CORRECT SPLIT #13412
DRAWN INCORRECTLY BY T. McNAIR
2/15/80
DETAIL
(NOT TO SCALE)
BOONE RD
-041
1.00 A.
346
279.08'
-042
14.00 A.
-044
5.60 A.
-043
2.92 A.
-028
11.48 A.
-003
31.83 A.
-002
31.66 A.
-006
6.50 A.
-007
3.50 A.
Ref- DV 1255/375
SEE SPLIT #13412
BOONE
BOSTON
556.60
289.60
605.22
846.20
500.17
1930
1354.94
790.25
580.35
257.68
666.74
1089
APPROVED
LORAIN CO.
MAP DEPT.
DATE 3-13-92
PAGE 12-H
BY T. McNair
AFTER 1981 1-A
MAP CORRECTION
9/2/92
1981 1-A
COLUMBIA
SCALE: 1" = 400'