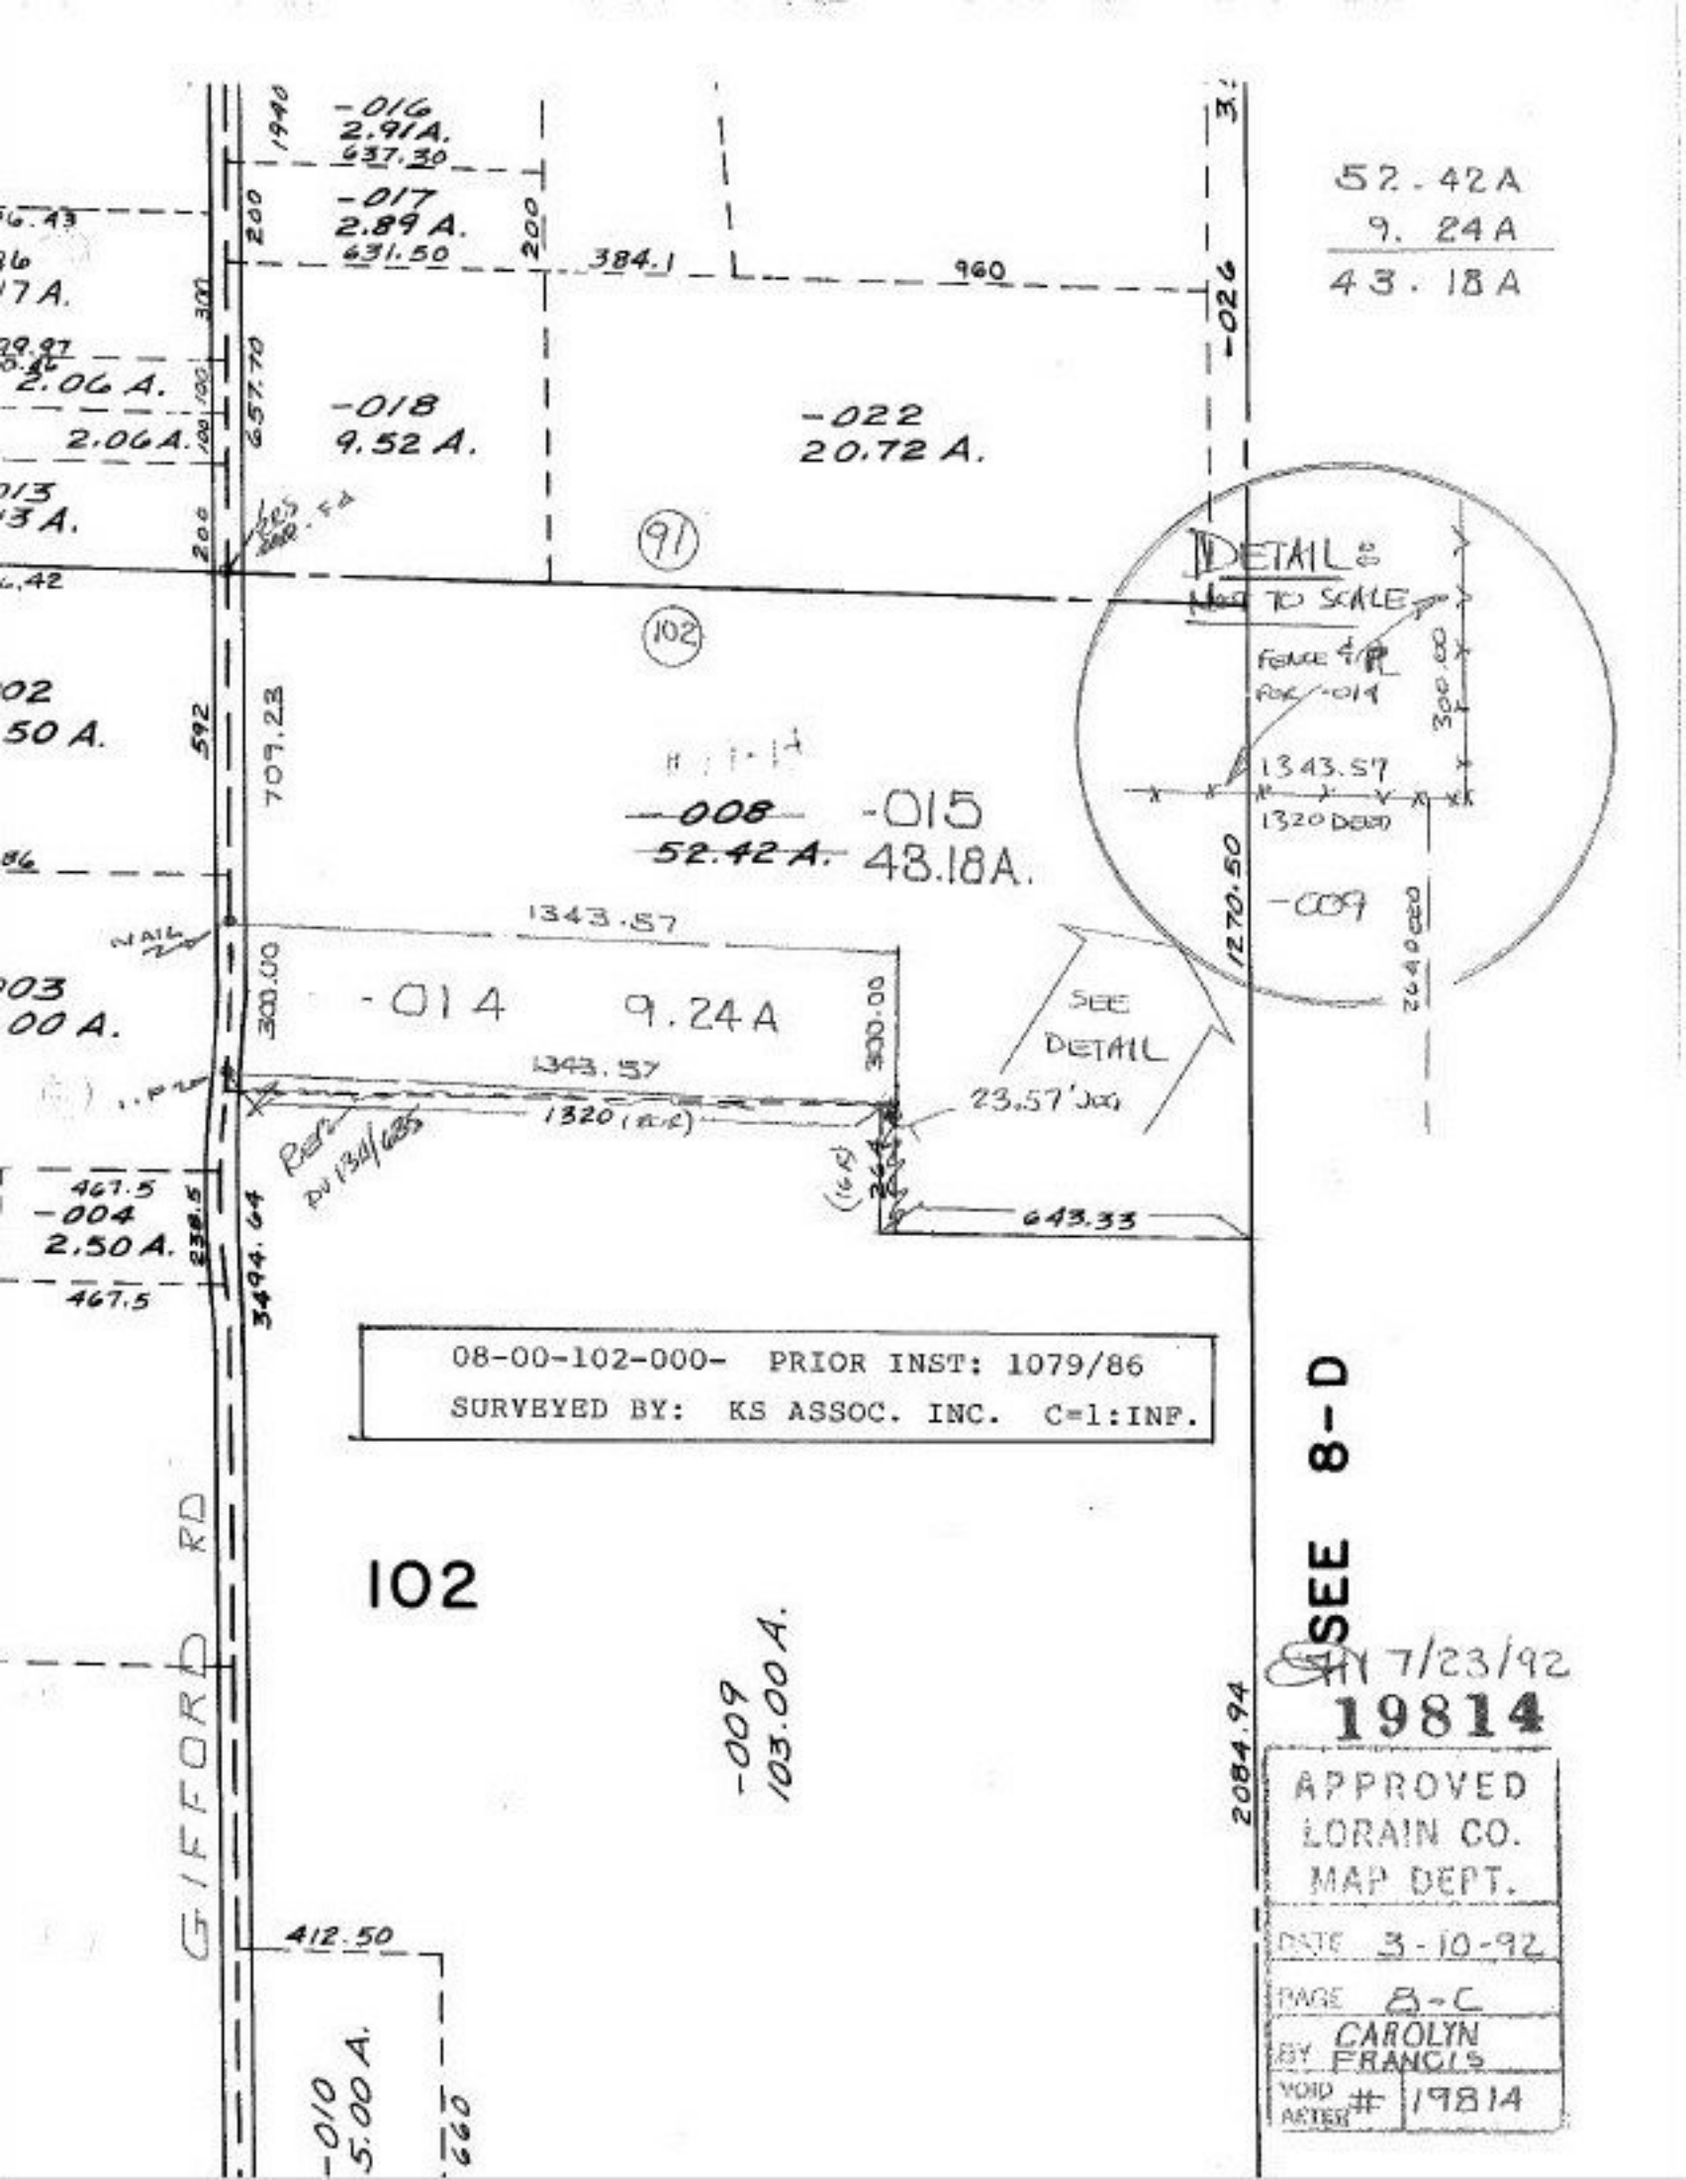

-016
2.91 A.
637.30
-017
2.89 A.
631.50
384.1
960
52.42 A
9.24 A
43.18 A
-018
9.52 A.
-022
20.72 A.
-026
2.06 A.
2.06 A.
91
102
DETAIL:
NOT TO SCALE
FENCE & PL
FOR -014
1343.57
1320 DEED
-009
1270.50
-008
52.42 A.
-015
43.18 A.
1343.57
-014
9.24 A
300.00
SEE
DETAIL
23.57' JOG
1320
643.33
-004
2.50 A.
467.5
3494.64
08-00-102-000- PRIOR INST: 1079/86
SURVEYED BY: KS ASSOC. INC. C=1:INF.
SEE 8-D
102
GIFFORD RD
-009
103.00 A.
2084.94
412.50
-010
5.00 A.
660
7/23/92
19814
APPROVED
LORAIN CO.
MAP DEPT.
DATE 3-10-92
PAGE 8-C
BY CAROLYN FRANCIS
VOID AFTER # 19814