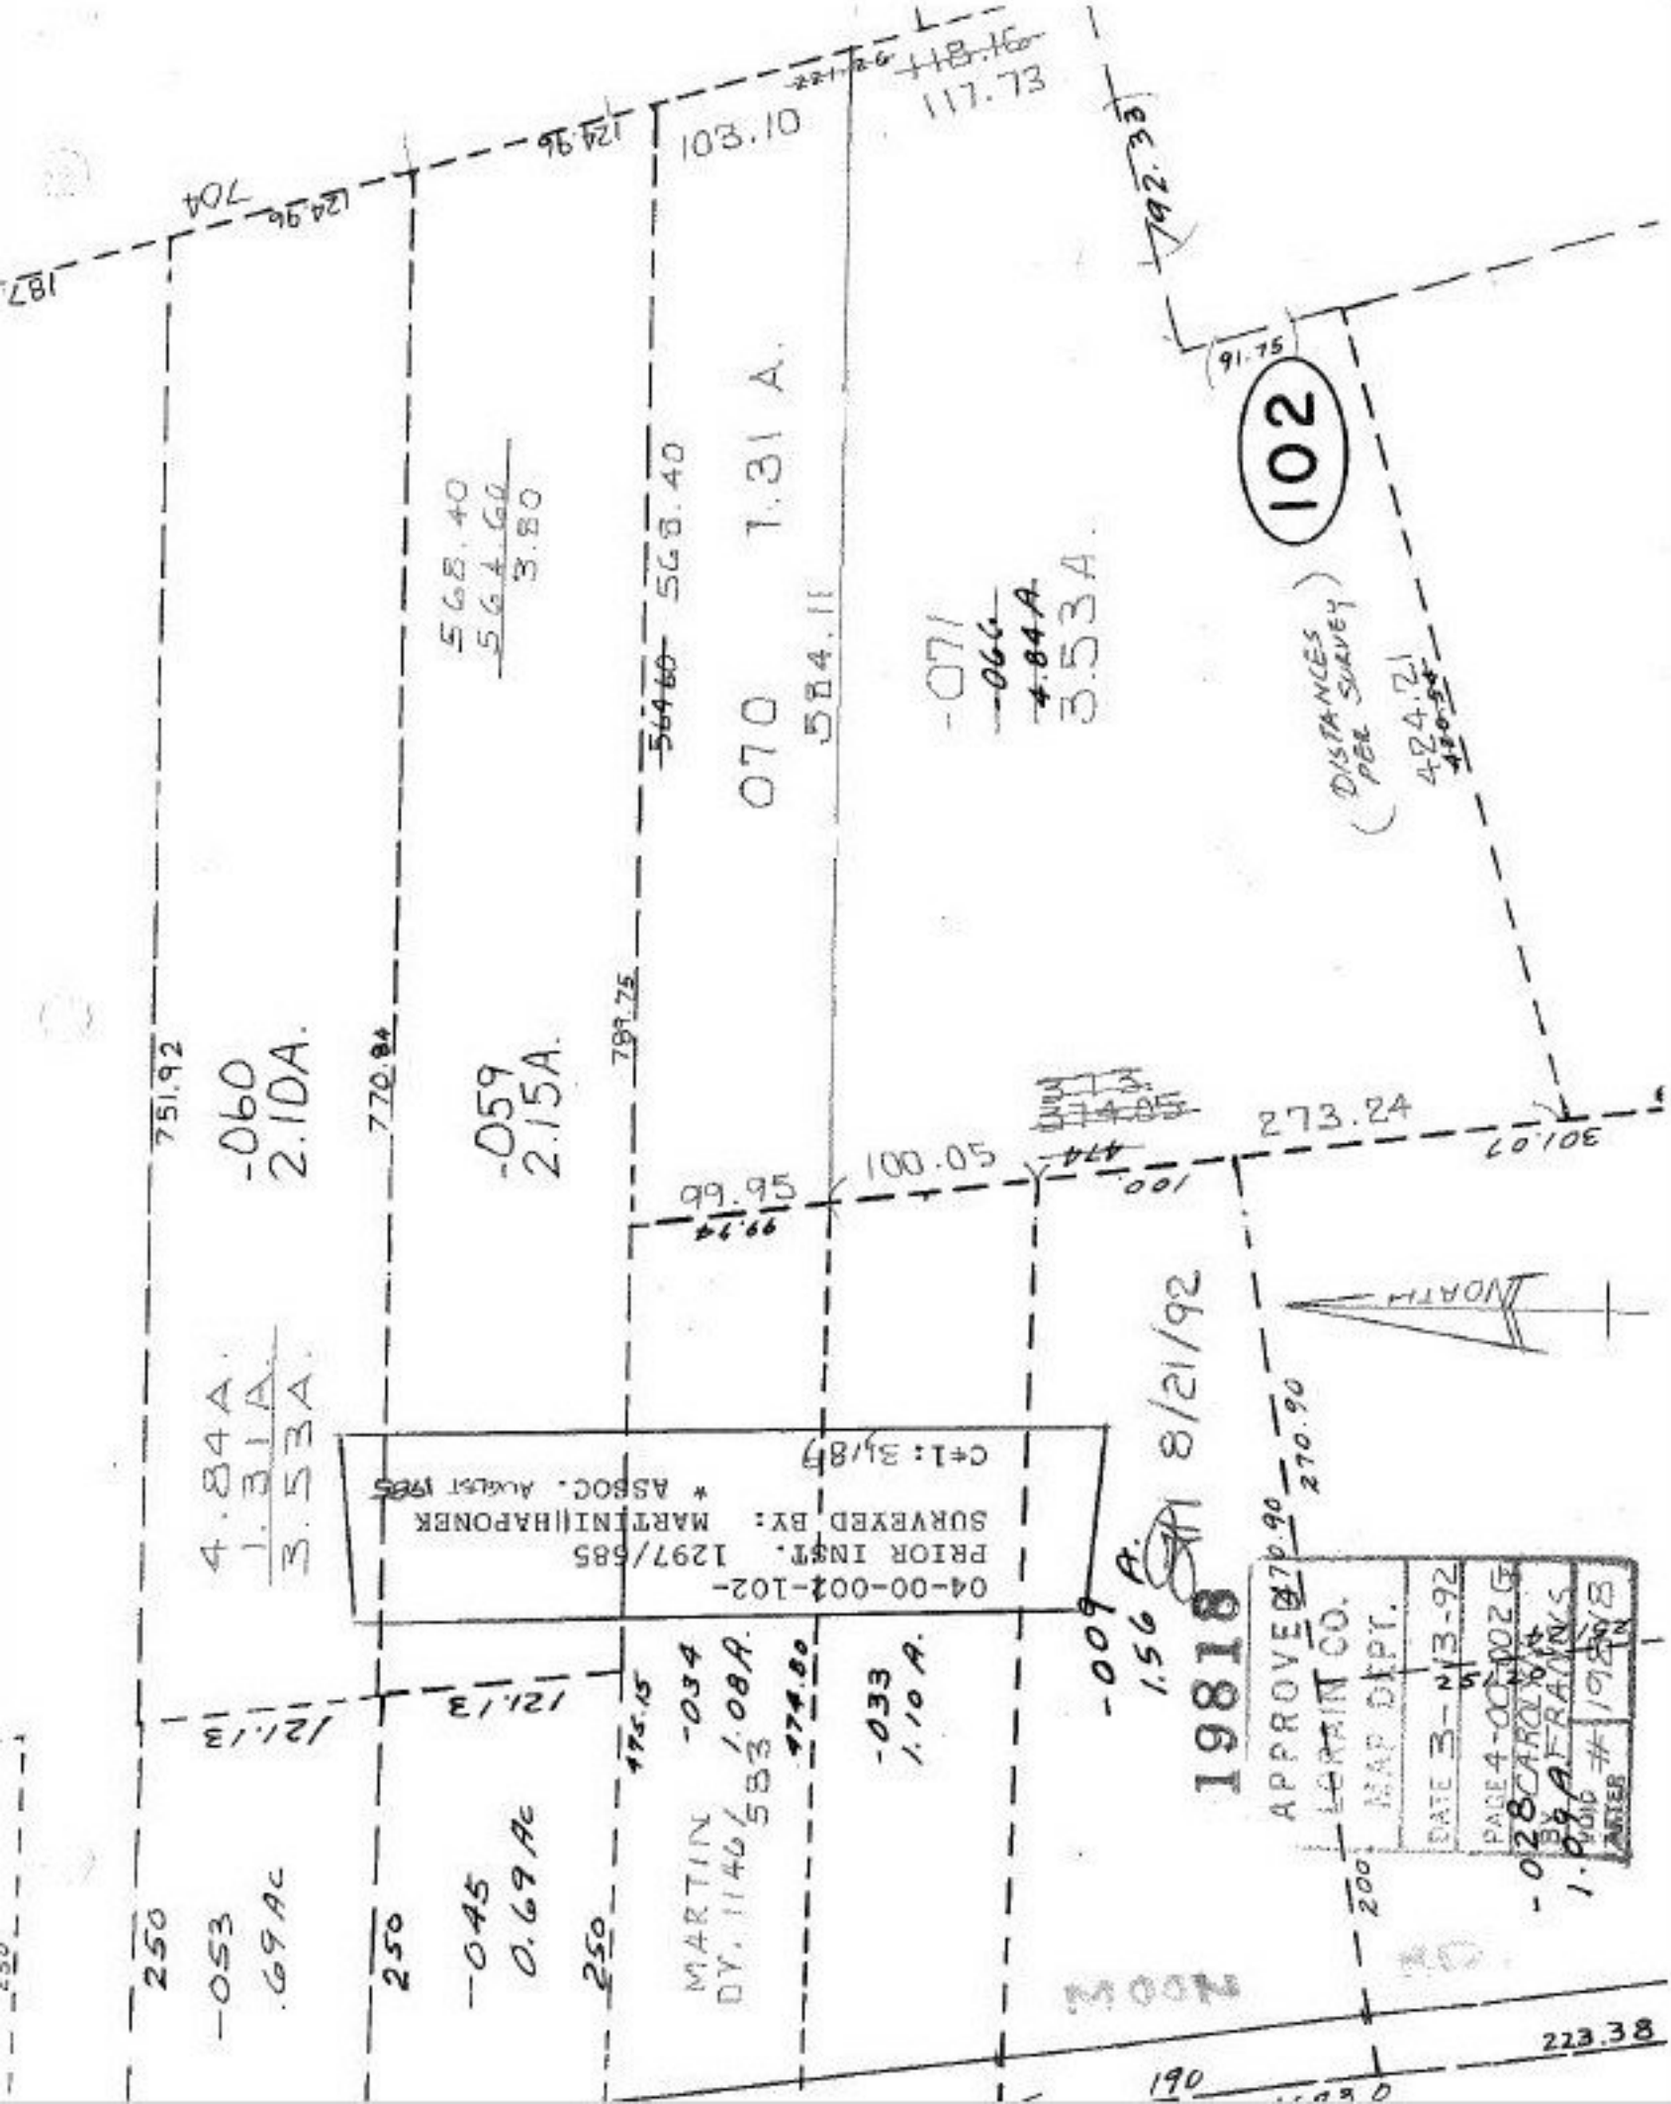
102
DISTANCES PER SURVEY
424.21
-071
3.53A.
070
1.31 A.
584.11
568.40
564.60
3.80
103.10
117.73
792.33
91.75
-060
2.10A.
-059
2.15A.
751.92
770.84
789.75
99.95
100.05
273.24
301.07
4.84A.
1.31A.
3.53A.
NORTH
04-00-002-102-
PRIOR INST. 1297/685
SURVEYED BY: MARTINI HAPONEK
* ASSOC. AUGUST 1985
C#1: 3/1/89
8/21/92
19818
APPROVED
LORAIN CO.
MAP DEPT.
DATE 3-13-92
PAGE 4-00-002 G
CAROLYN
BY FRANKS
VOID #
ENTER
MARTIN
DY. 1146/583
-034
1.08A.
-033
1.10 A.
-009
1.56 A.
-028
1.09 A.
250
-053
.69 Ac
-045
0.69 Ac
121.13
223.38
190
270.90
200