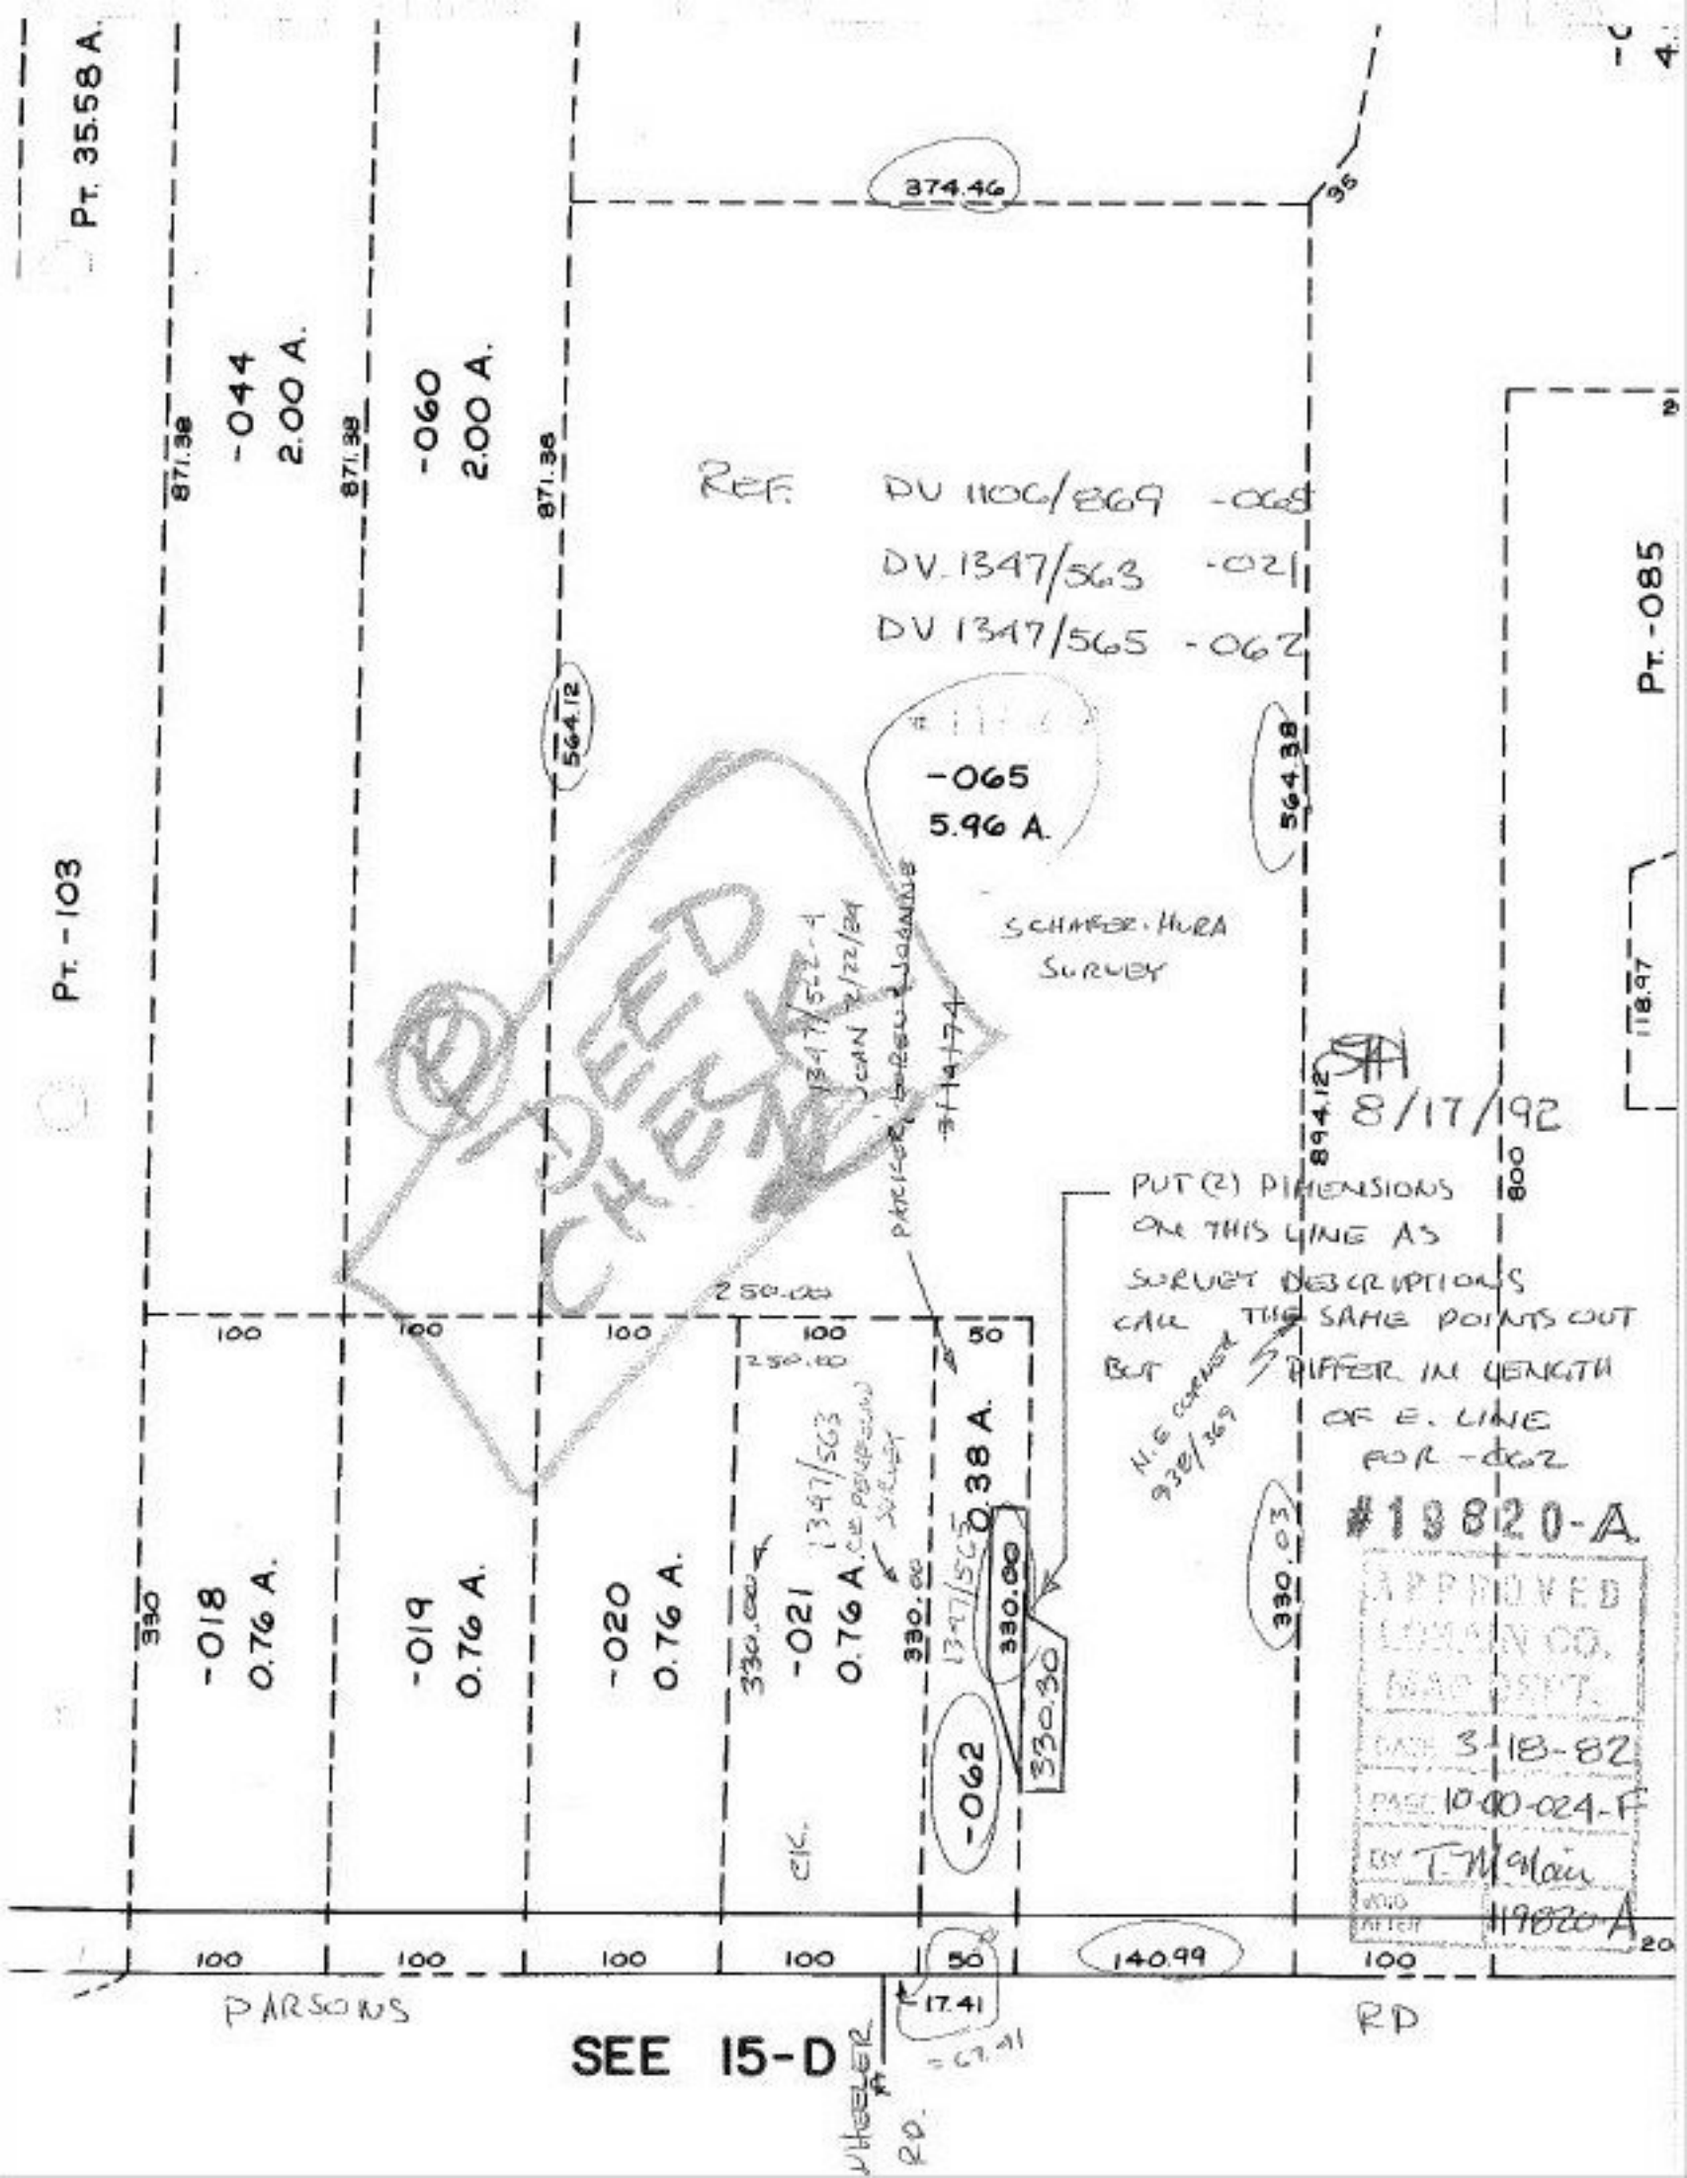

Pt. 35.58 A.
Pt. -103
Pt. -085
374.46
35
871.38
-044
2.00 A.
-060
2.00 A.
REF. DV 1106/869 -065
DV 1347/563 -021
DV 1347/565 -062
564.12
-065
5.96 A.
564.38
SCHAFER-HURA SURVEY
1347/562-4
JOAN 2/22/84
PARKER, LOREN & JOANNE
3/14/74
DEED CHECK
894.12
8/17/92
800
118.97
PUT (2) DIMENSIONS ON THIS LINE AS SURVEY DESCRIPTIONS CALL THE SAME POINTS OUT BUT DIFFER IN LENGTH OF E. LINE FOR -062
N.E. CORNER 938/369
250.00
100
50
330
-018
0.76 A.
-019
0.76 A.
-020
0.76 A.
330.00
-021
0.76 A.
1347/563
C.E. PENFOUND SURVEY
0.38 A.
330.00
330.30
330.03
-062
#19820-A
APPROVED
LOMAIN CO.
MAP DEPT.
DATE 3-18-82
PAGE 10-00-024-F
BY T. McMain
VOID AFTER 119820-A
140.99
17.41
PARSONS
RD
SEE 15-D
WHEELER RD.