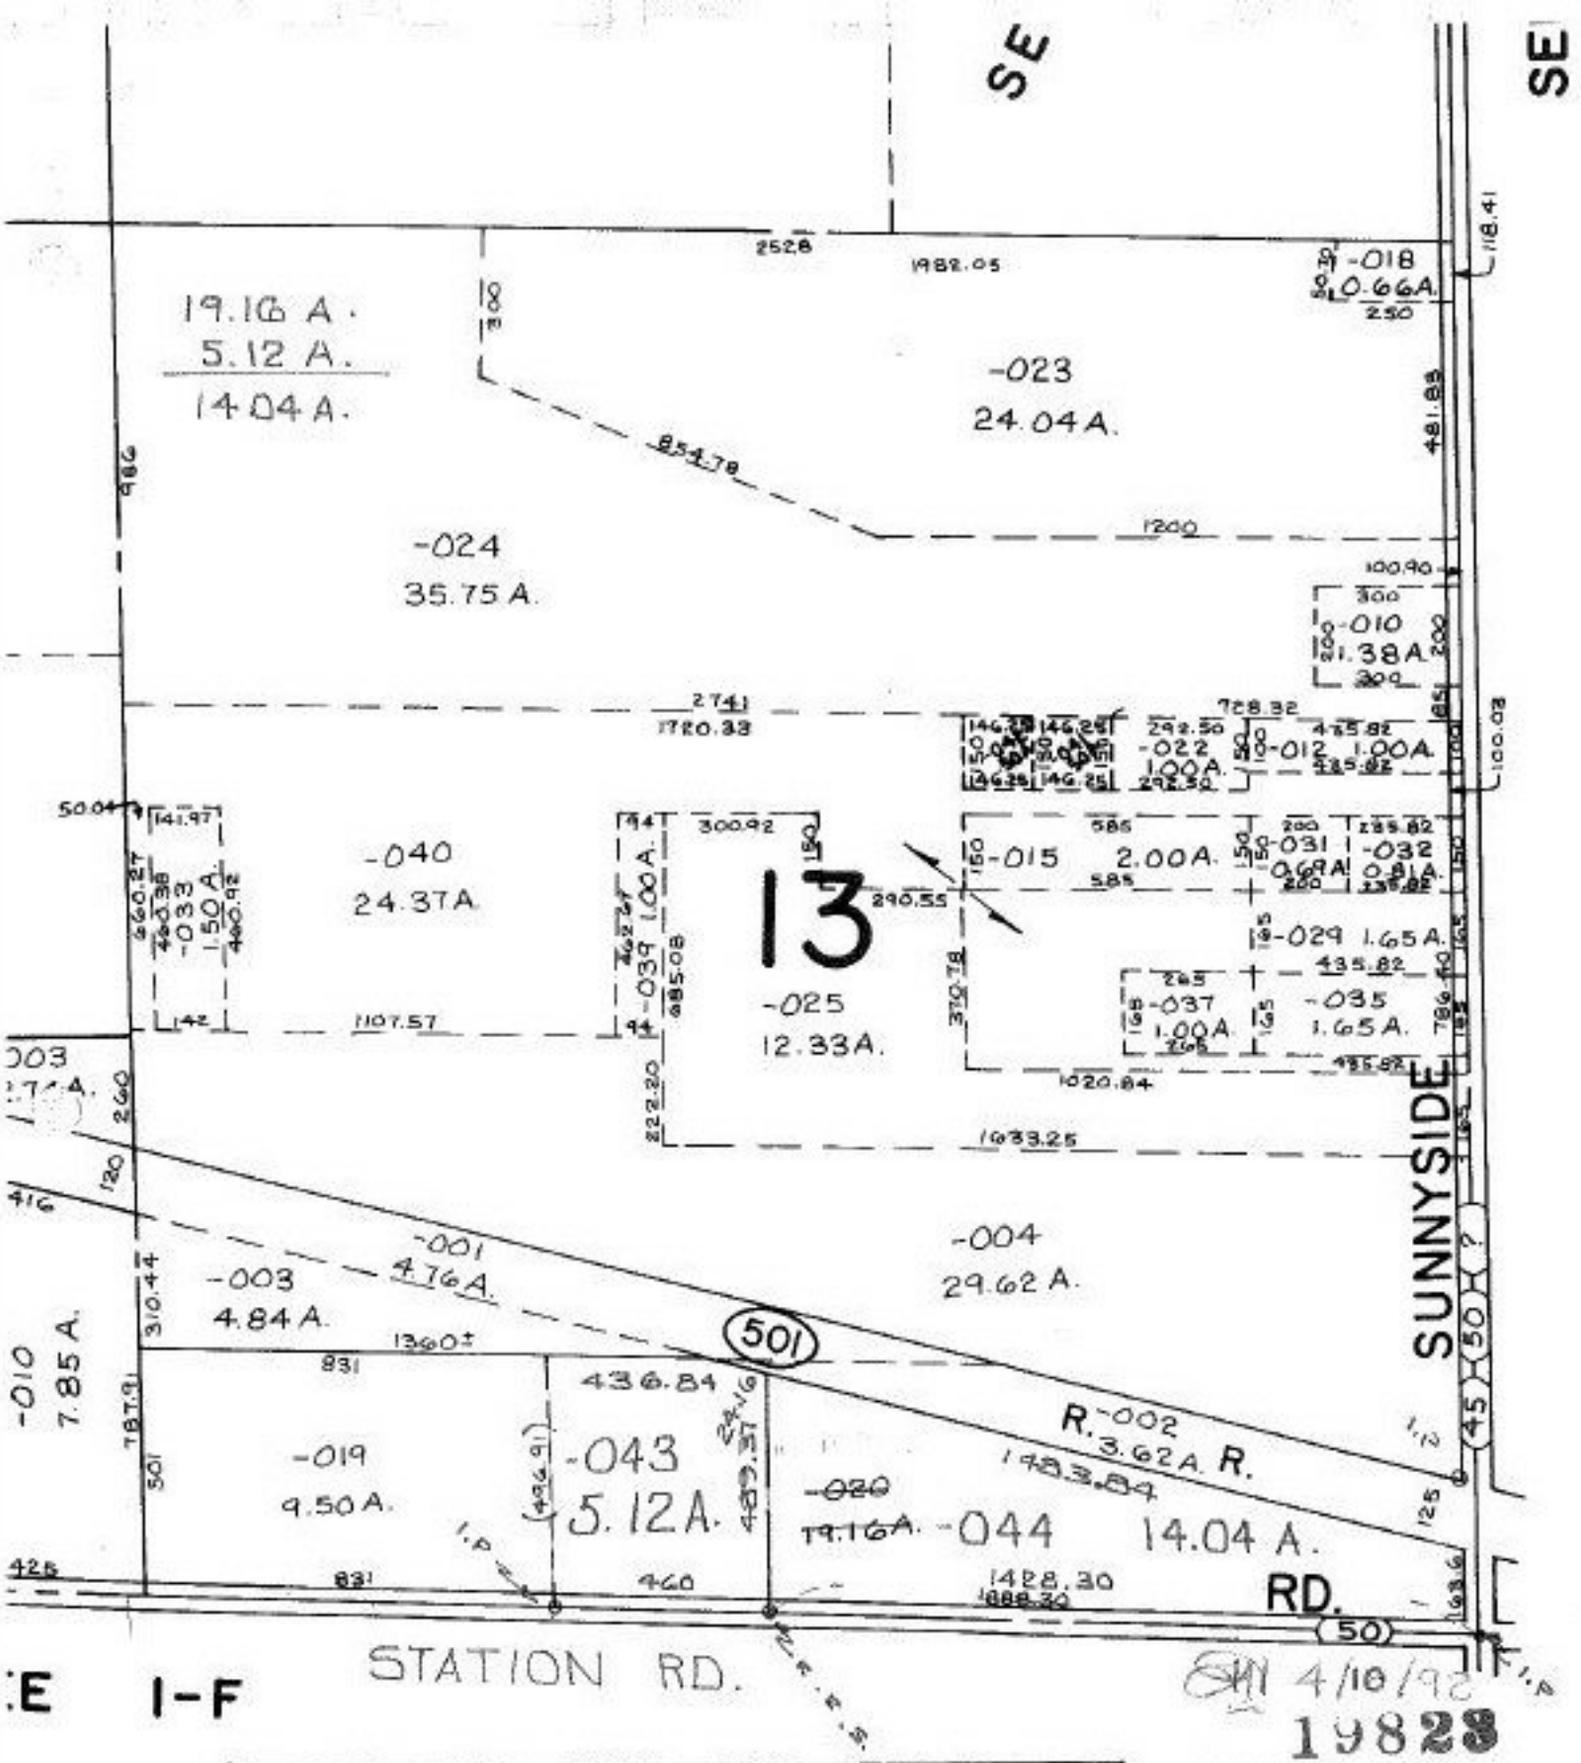

01-00-013-000- PRIOR INST:910/256
SURVEYED BY: ARNOLD KOEPP REG. SURVEYOR
C=1; [redacted] 25,000

APPROVED
LORAIN CO.
MAP DEPT.
DATE 3-17-92
PAGE 1-B
CAROLYN
BY FRANCIS
VOID AFTER # 19823