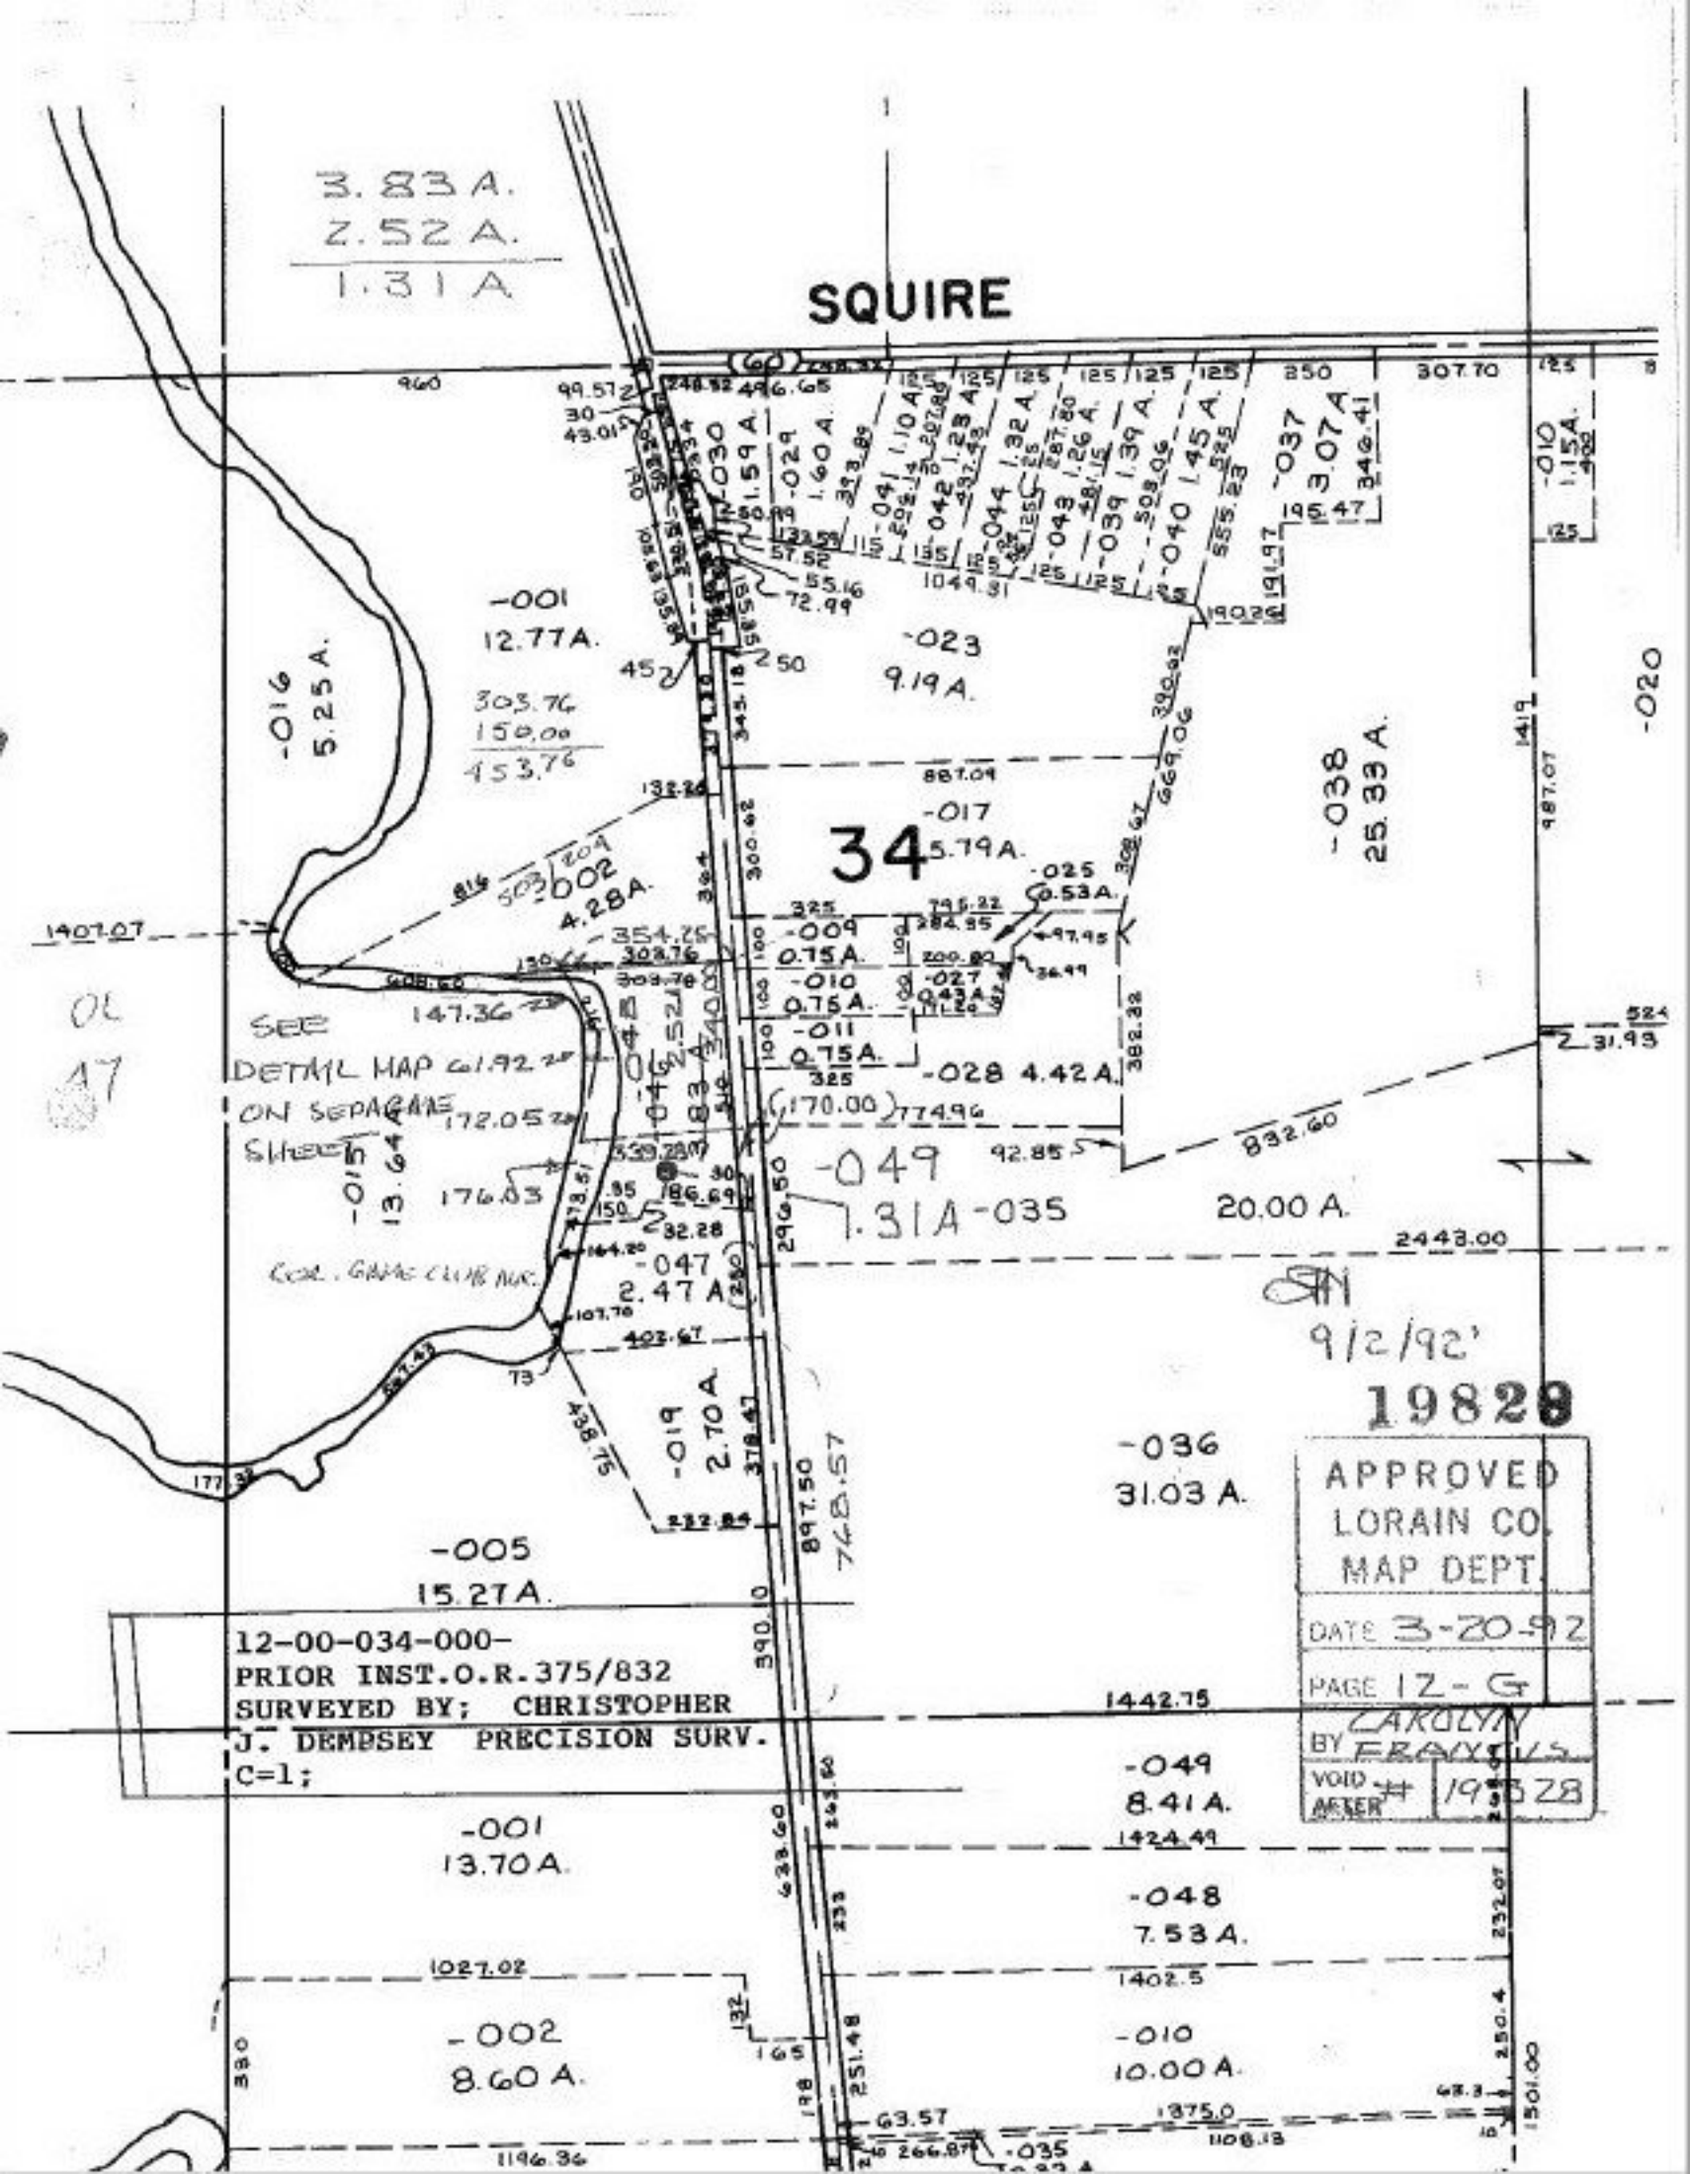
3.83 A.
2.52 A.
1.31 A.
SQUIRE
-001
12.77A.
-016
5.25 A.
-023
9.19 A.
-038
25.33 A.
-020
34
-017
5.79A.
-025
0.53A.
-002
4.28A.
-009
0.75A.
-010
0.75A.
-011
0.75A.
-028 4.42A.
-049
1.31A
-035
20.00 A.
-047
2.47 A
-019
2.70 A.
-036
31.03 A.
-005
15.27A.
-049
8.41A.
-001
13.70A.
-048
7.53A.
-002
8.60 A.
-010
10.00A.
SEE DETAIL MAP ON SEPARATE SHEET
COR. GAME CLUB RD.
12-00-034-000-
PRIOR INST.O.R.375/832
SURVEYED BY; CHRISTOPHER J. DEMPSEY PRECISION SURV.
C=1;
APPROVED
LORAIN CO.
MAP DEPT.
DATE 3-20-92
PAGE 12-G
BY CAROLYN FRANKS
VOID AFTER # 19828
9/2/92'
19828