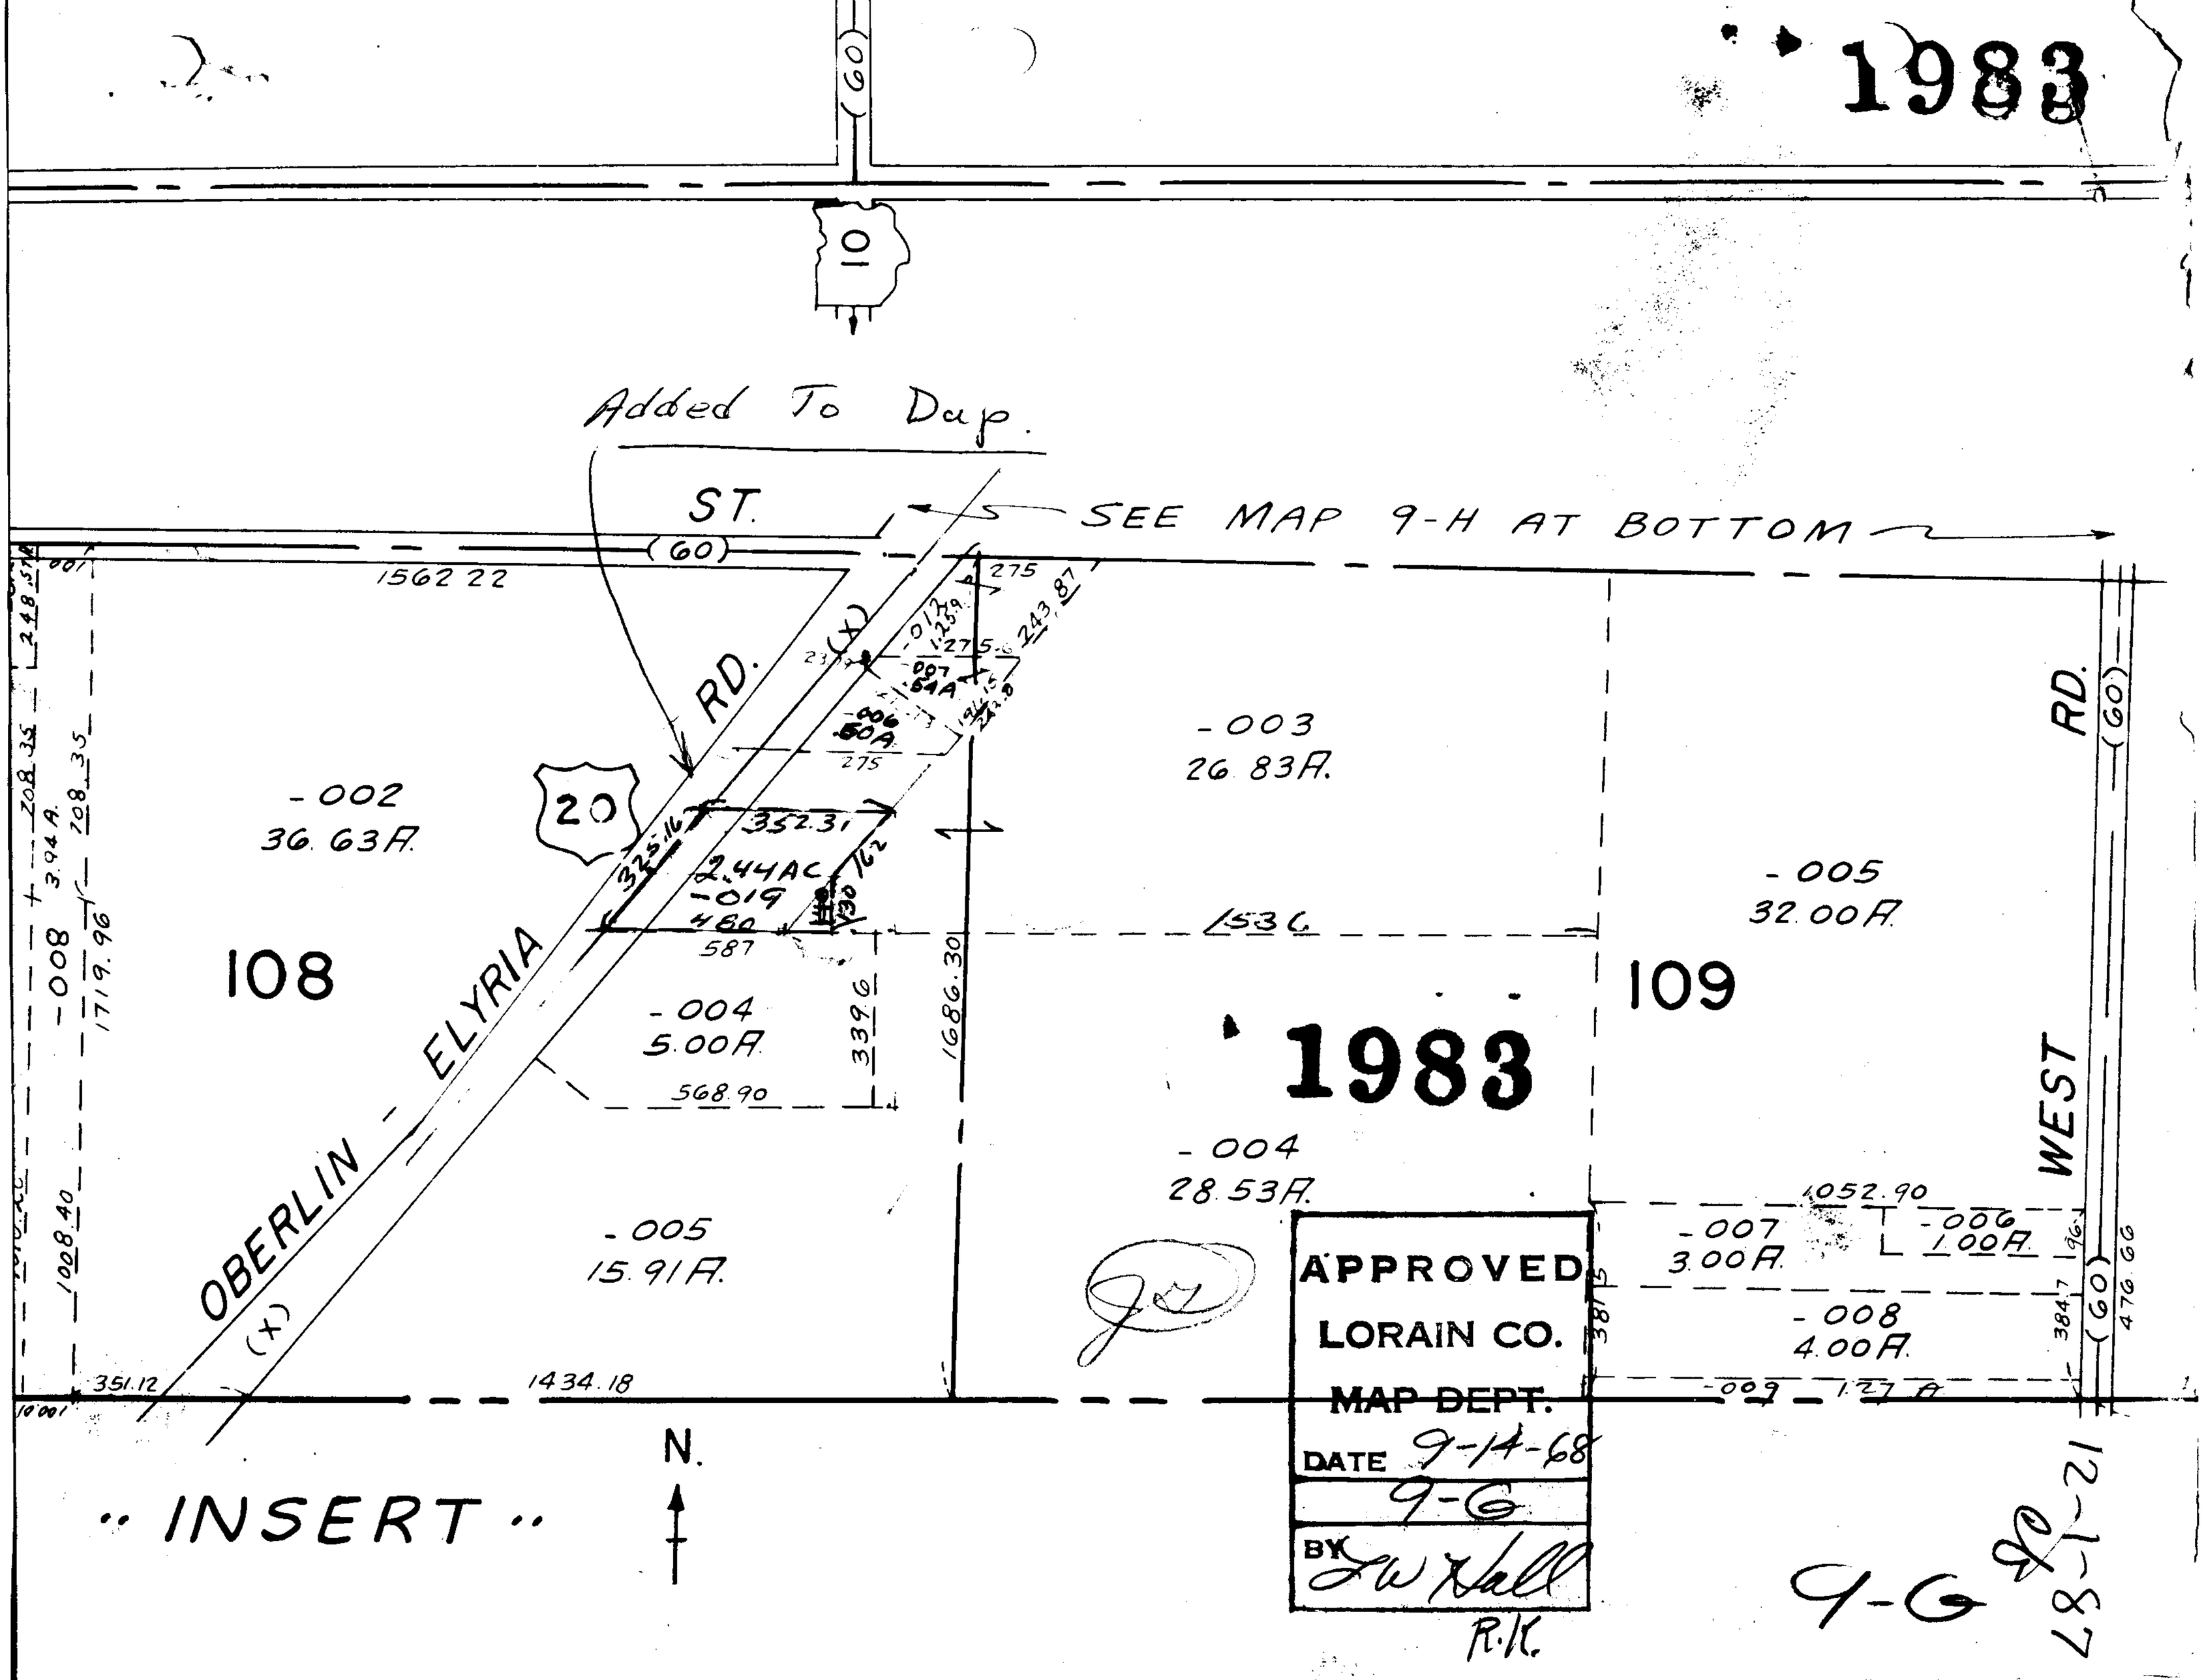
1983
(60)
10
Added To Dup.
ST.
SEE MAP 9-H AT BOTTOM
(60)
1562.22
RD.
(X)
20
-002
36.63A.
108
OBERLIN - ELYRIA
(X)
-003
26.83A.
-005
32.00A.
109
RD.
(60)
WEST
1983
-004
5.00A.
-004
28.53A.
-005
15.91A.
-007
3.00A.
-006
1.00A.
-008
4.00A.
-008
1719.96
1008.40
351.12
1434.18
1686.30
1536
1052.90
-009
1.27A
N.
INSERT
APPROVED
LORAIN CO.
MAP DEPT.
DATE 9-14-68
9-G
BY LW Hall
R.K.
9-G
12-1-87