


38X#

10

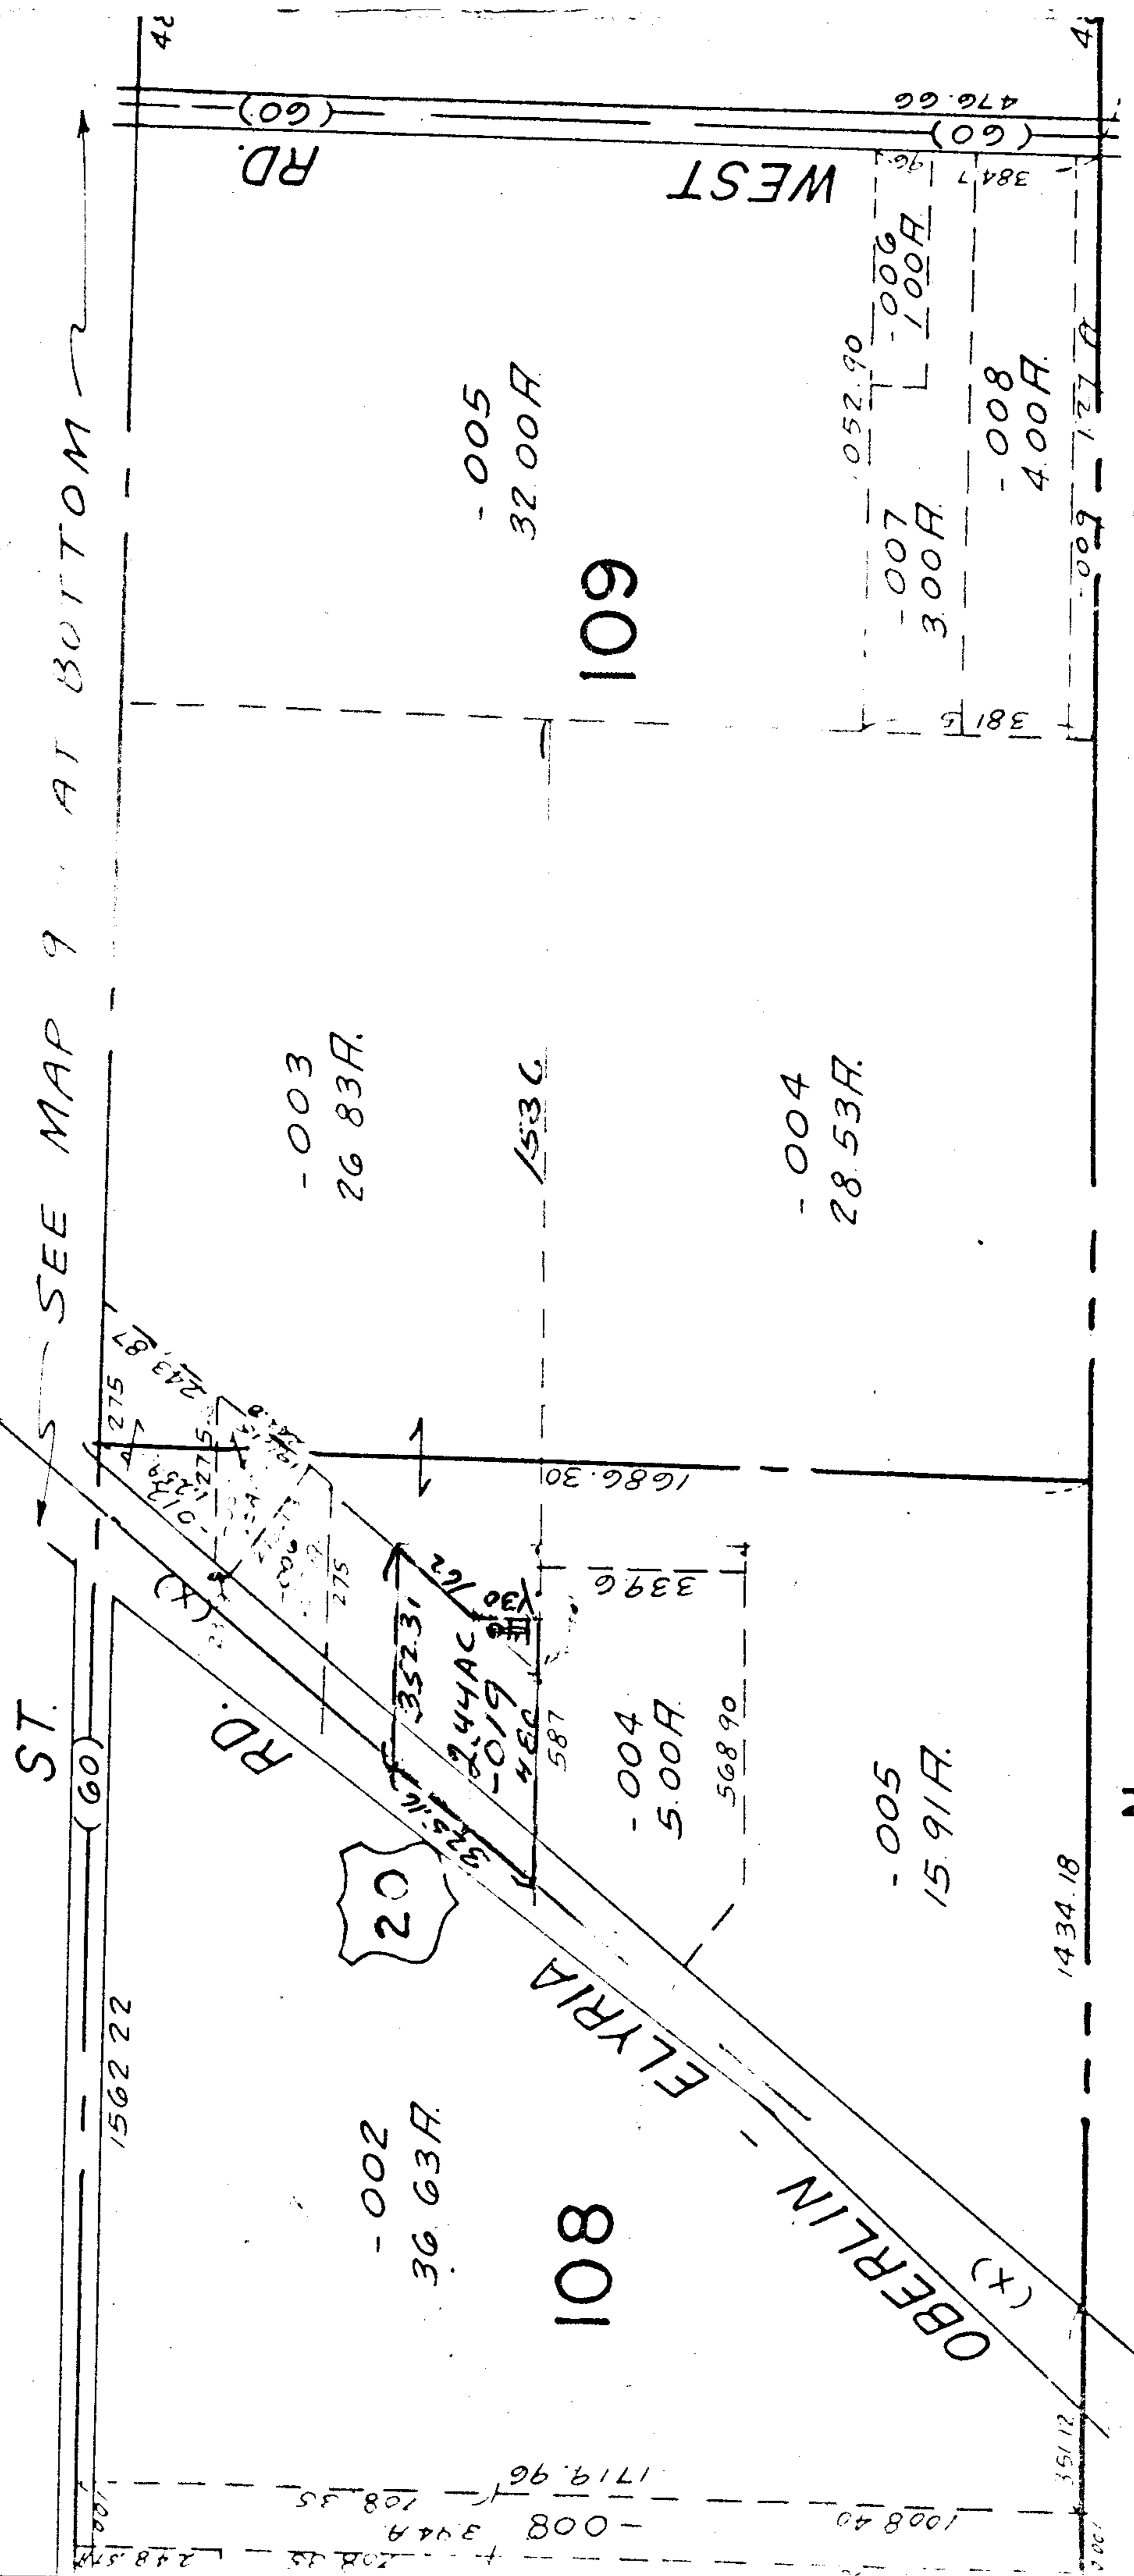

SEE MAP 9 AT BOTTOM

N. ↑

.. INSERT ..

9-6