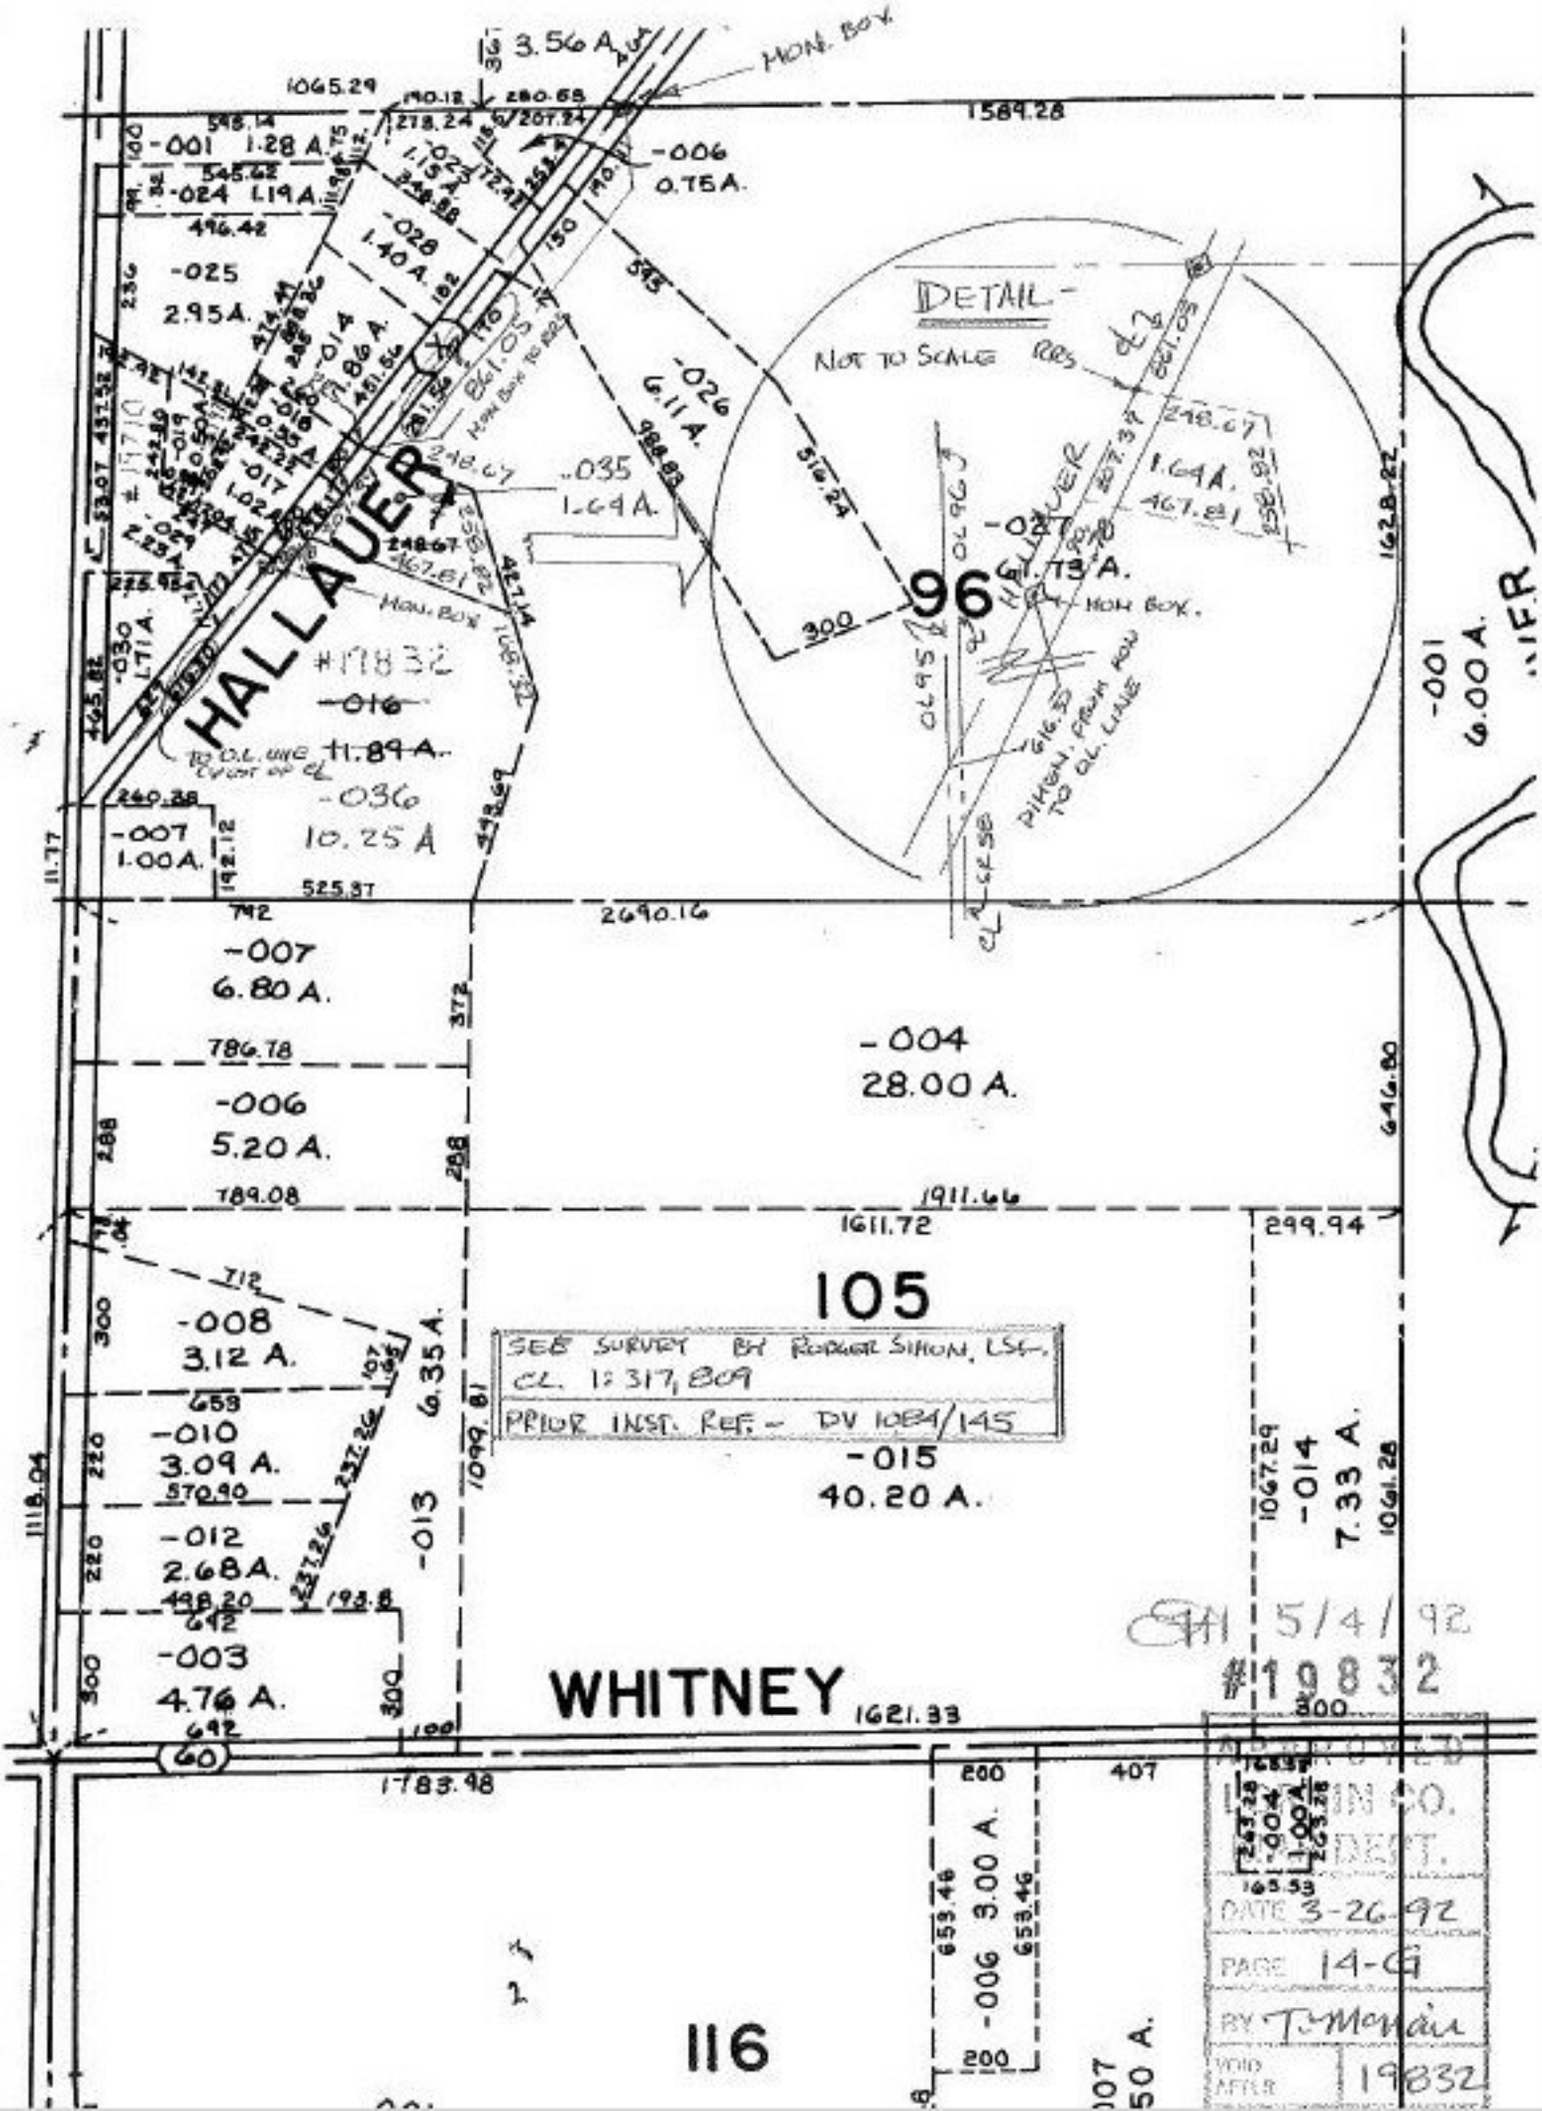

HALLAUER
WHITNEY
DETAIL -
NOT TO SCALE
96
105
116
SEE SURVEY BY RODGER SIMON, LSC.
CL. 1: 317,809
PRIOR INST. REF. - DV 1084/145
-001 1.28 A.
-024 1.19 A.
-025 2.95 A.
-028 1.40 A.
-006 0.75 A.
-026 6.11 A.
-035 1.64 A.
-027 61.73 A.
-016 11.89 A.
-036 10.25 A
-007 1.00 A.
-007 6.80 A.
-006 5.20 A.
-004 28.00 A.
-008 3.12 A.
-010 3.09 A.
-012 2.68 A.
-003 4.76 A.
-013 6.35 A.
-015 40.20 A.
-014 7.33 A.
-001 6.00 A.
-006 3.00 A.
#19832
5/4/92
#19832
APPROVED
DATE 3-26-92
PAGE 14-G
BY T. Monair
VOID AFTER 19832
SEE 14-F