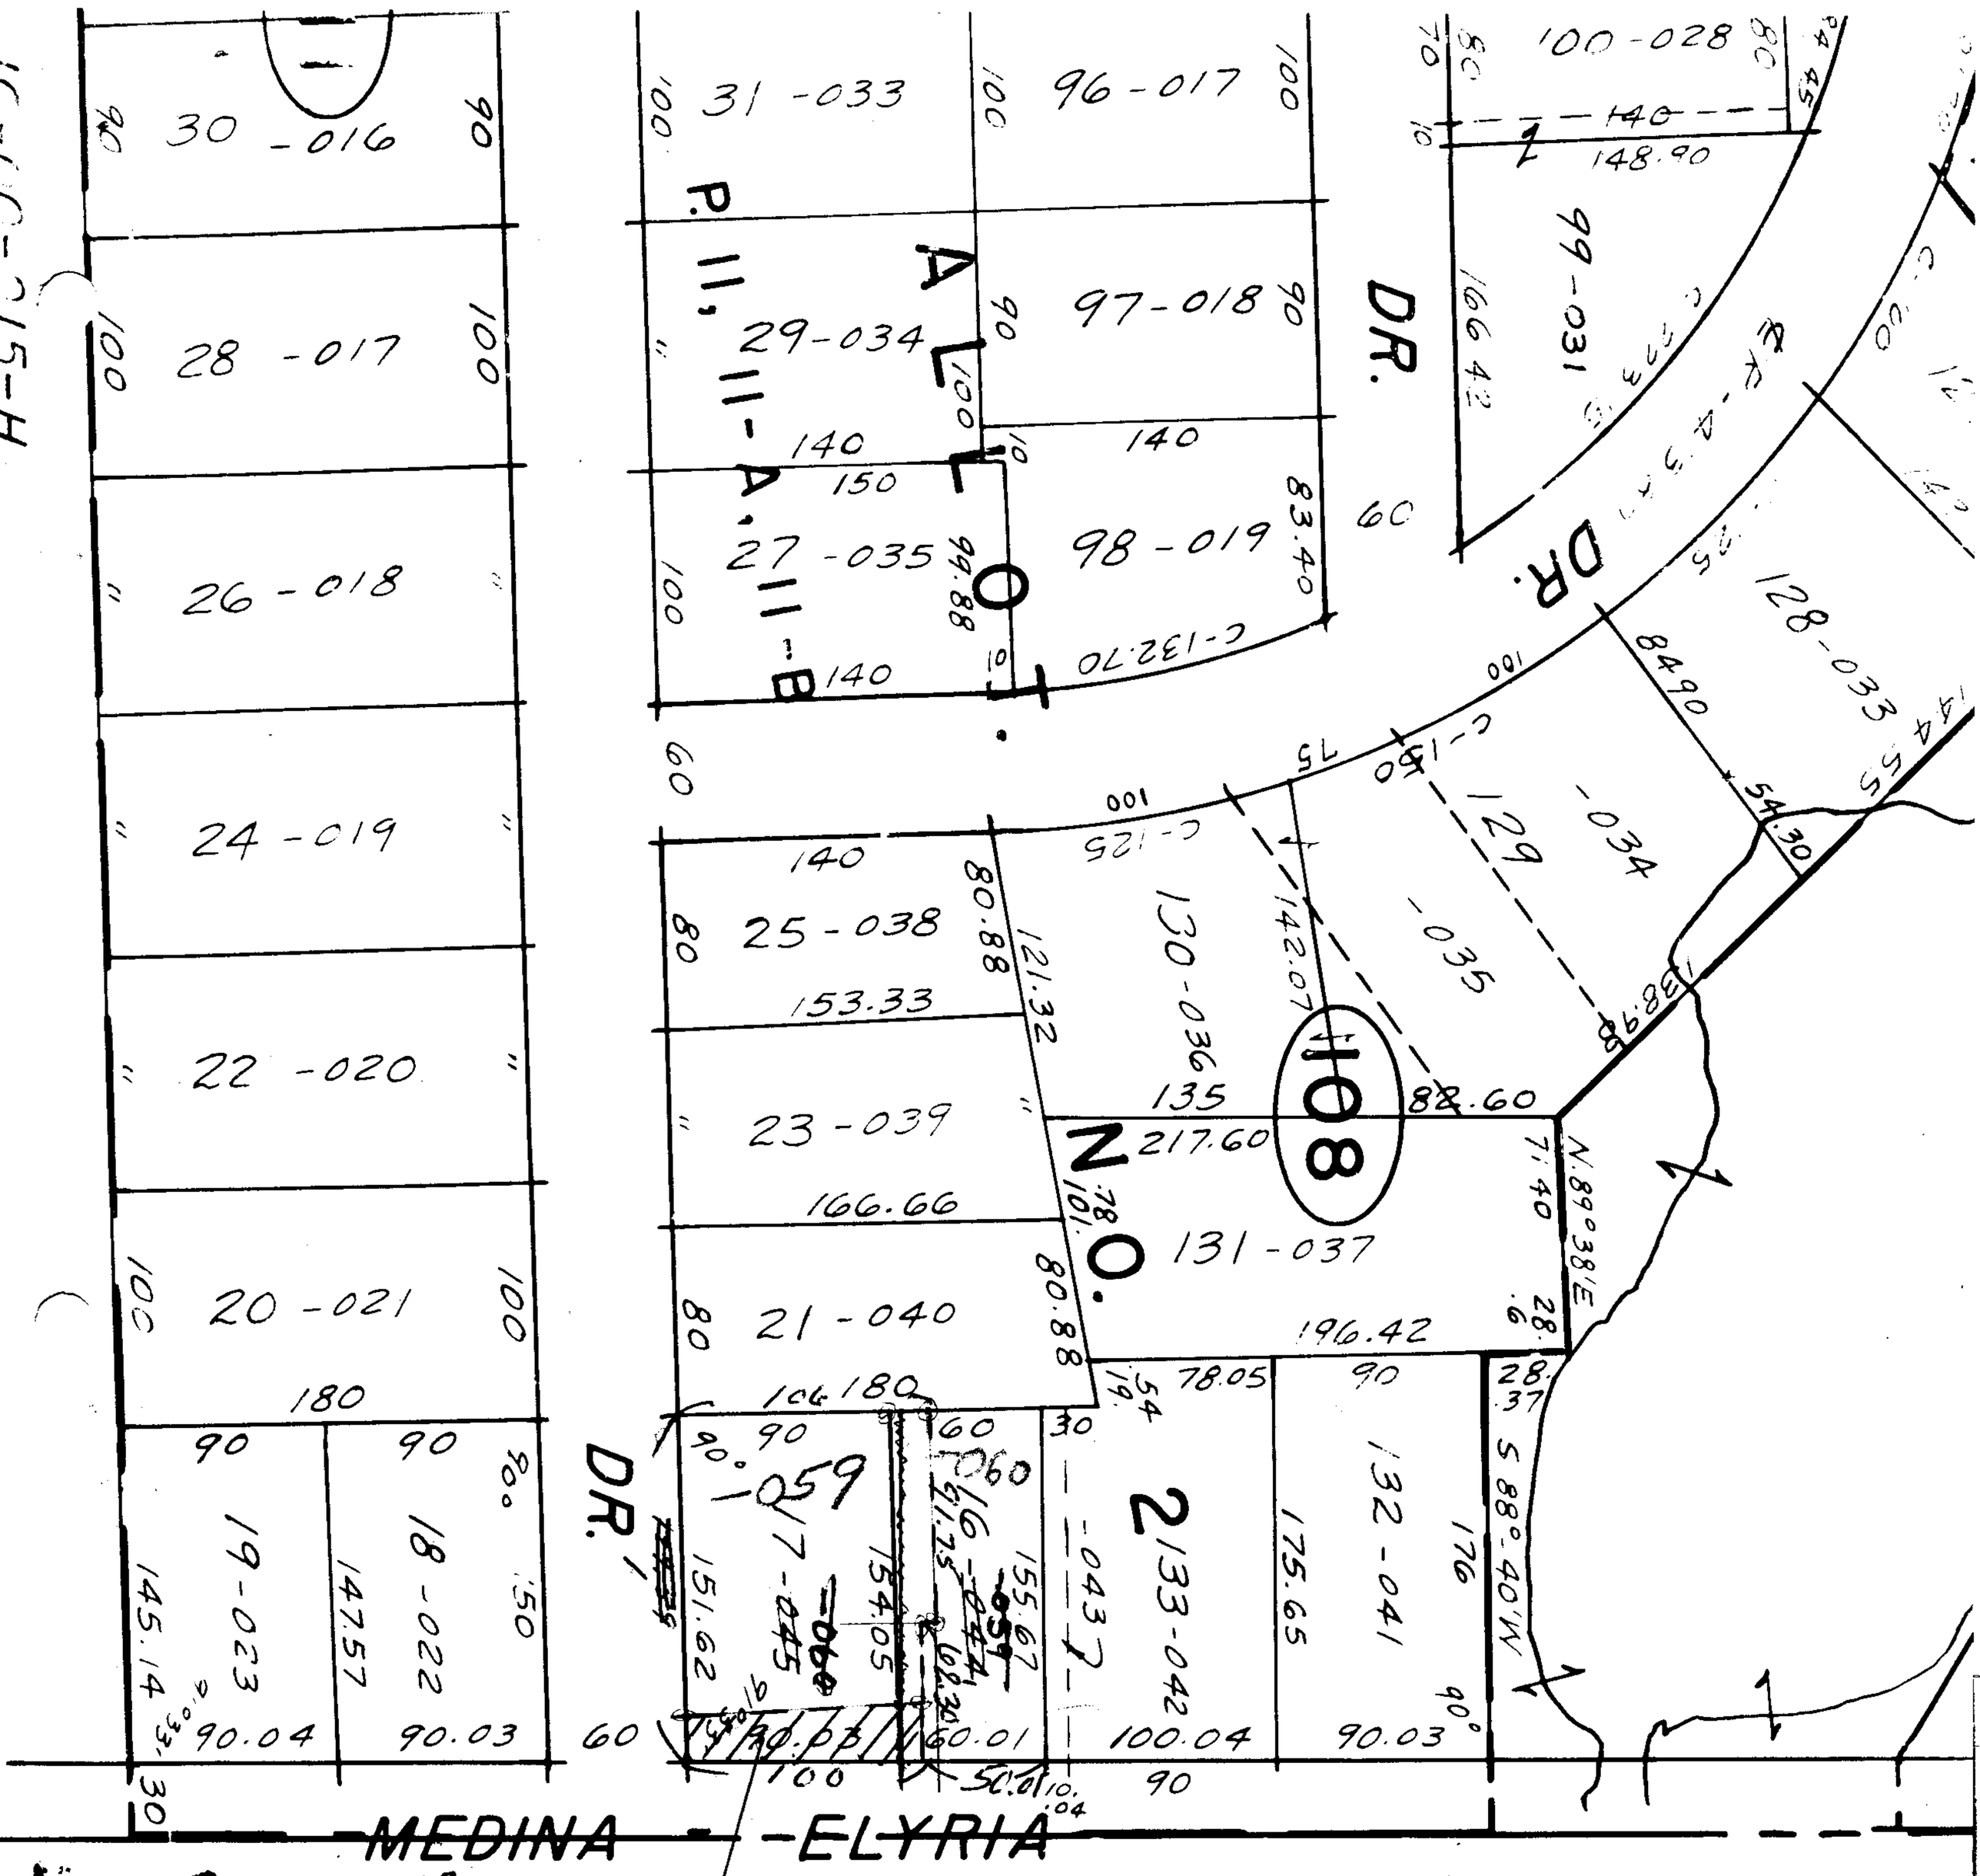
H-51C-01-01
30 -016
28 -017
26 -018
24 -019
22 -020
20 -021
19-023
18-022
31 -033
29-034
27 -035
96-017
97-018
98-019
25-038
23-039
21-040
100-028
99-031
130-036
129-034
129-035
131-037
128-033
132-041
133-042
DR.
P.
A.
B.
MEDINA - ELYRIA
1984
APPROVED
LORAIN CO.
MAP DEPT.
DATE 7-29-68
BY
9/30/68 R.K.
Permanent Easement
State of Ohio
Deed Vol 798 Pg 269
Berghoff To State of Ohio
Highway Plan
Lorain County Right of Way
LoR-57-11.72
Pg 2/14