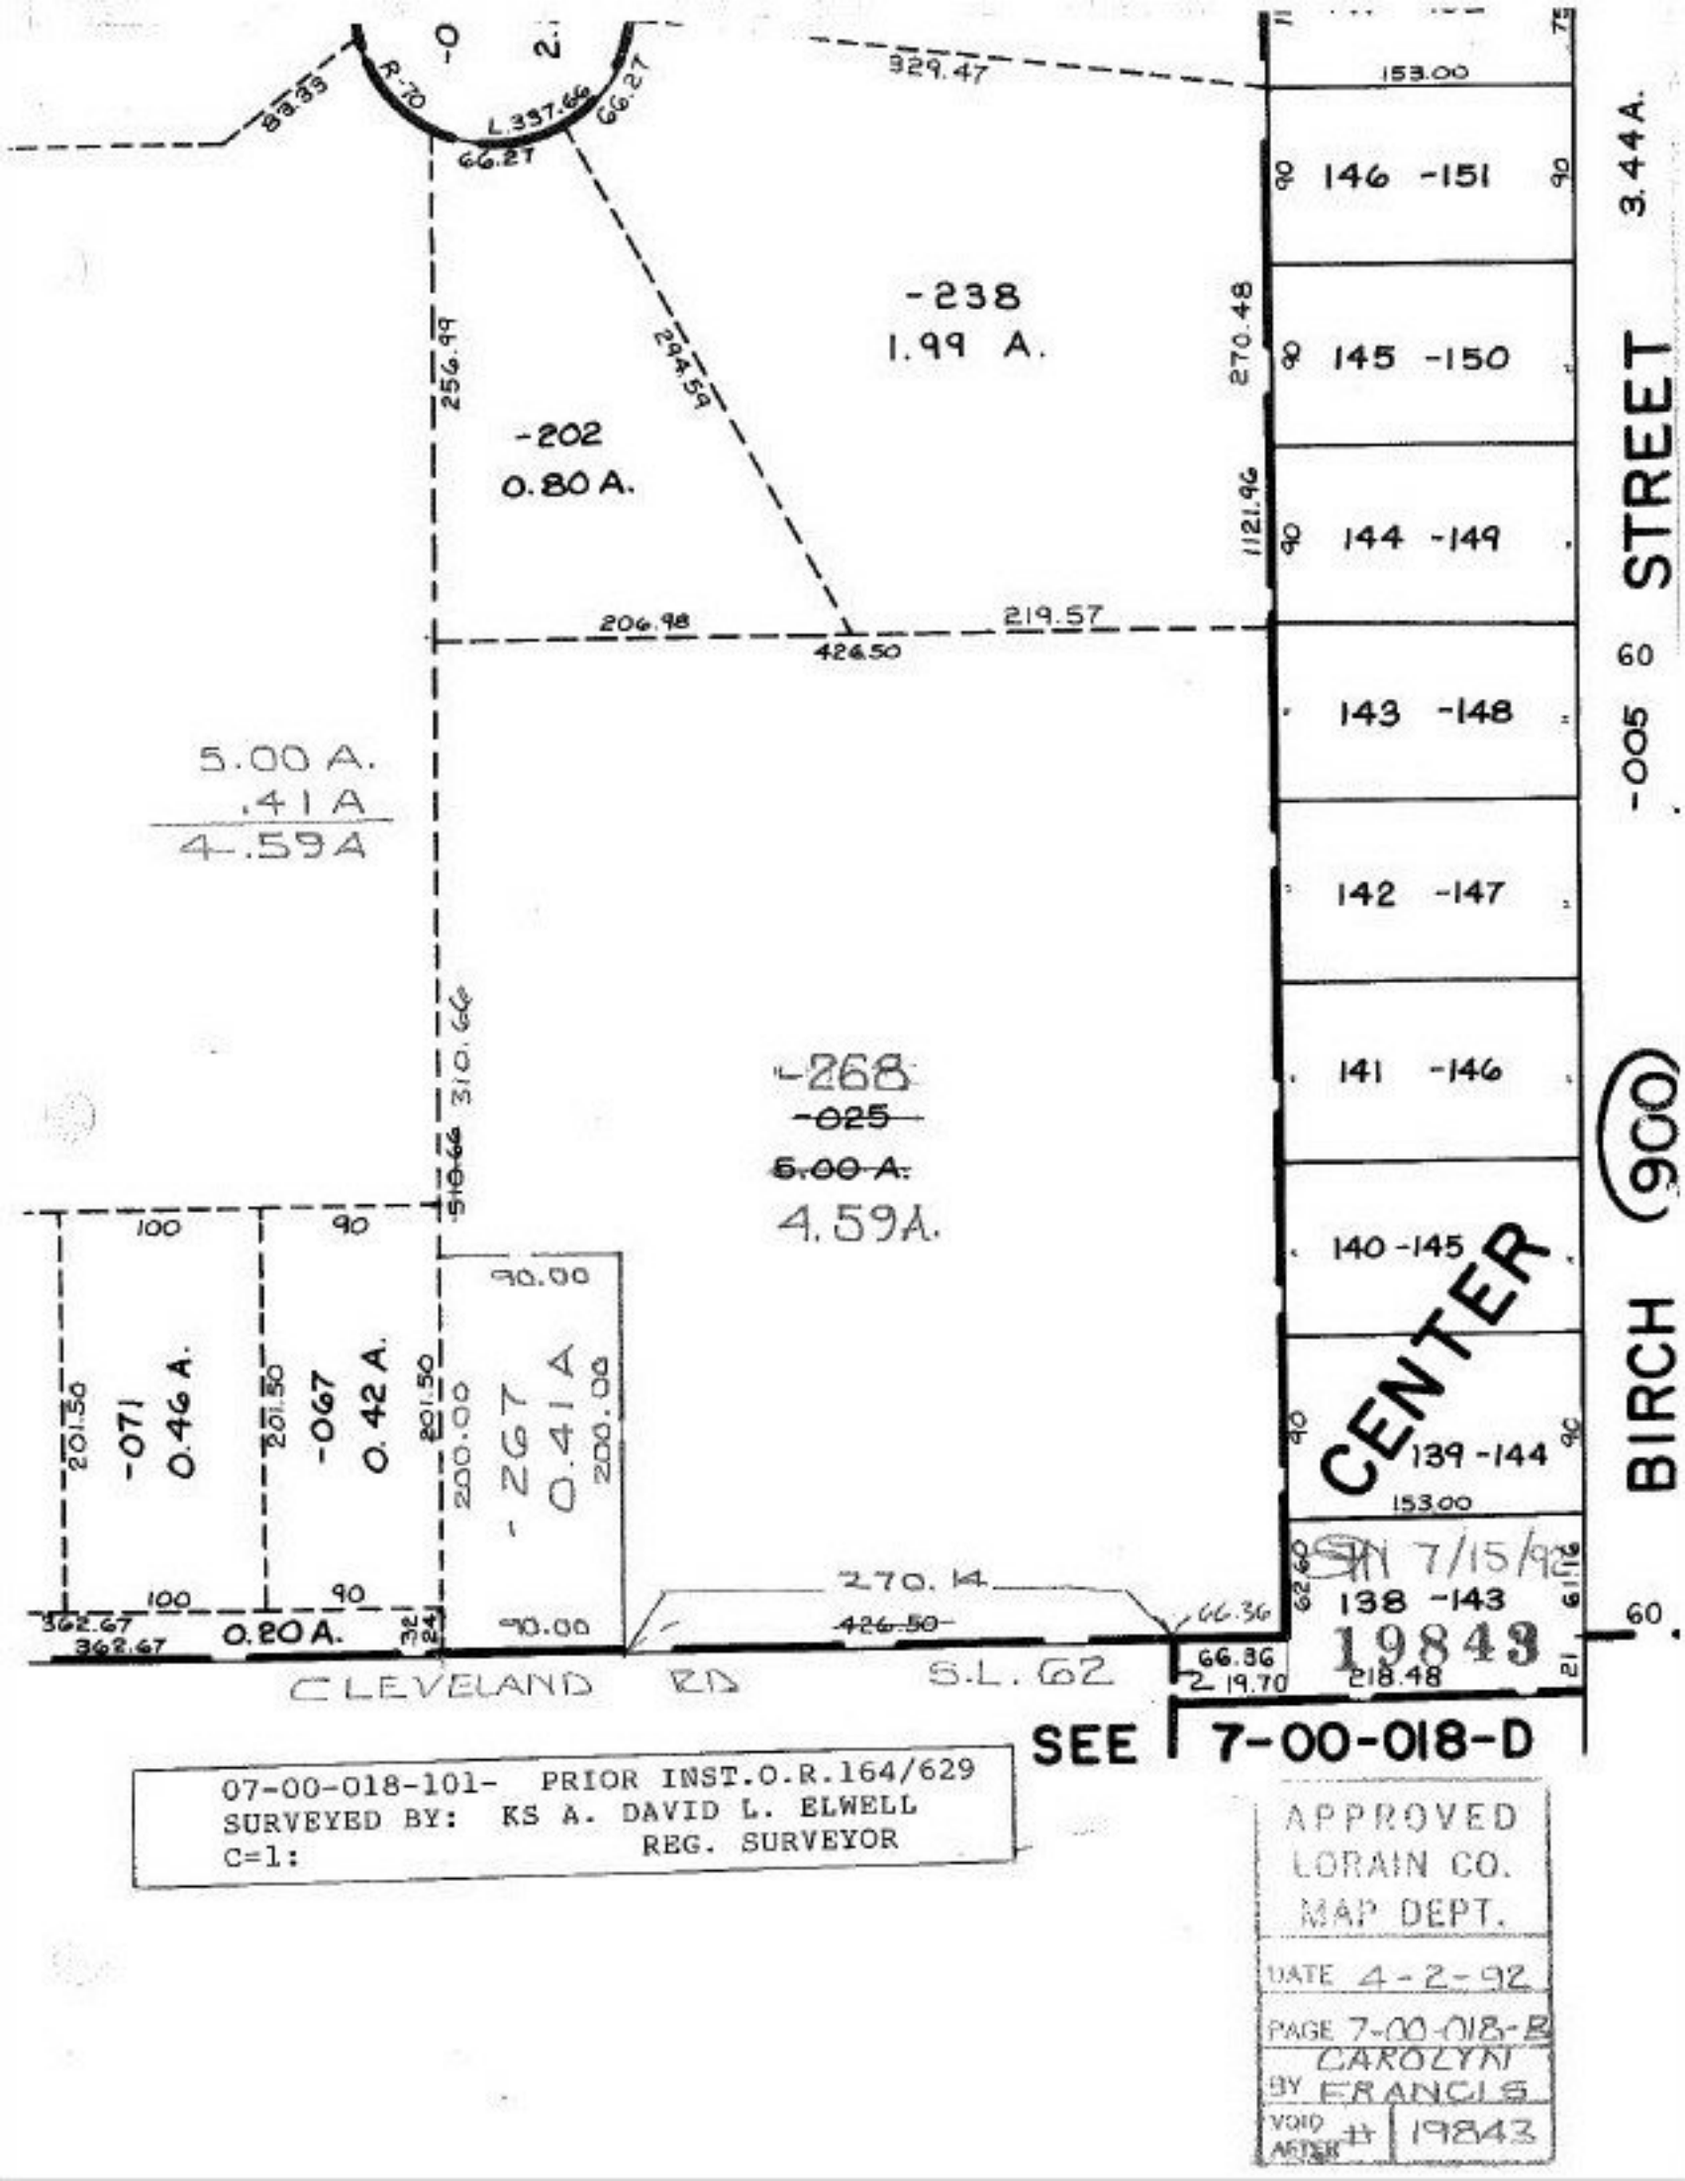

07-00-018-101- PRIOR INST.O.R.164/629
SURVEYED BY: KS A. DAVID L. ELWELL
C=1: REG. SURVEYOR

APPROVED
LORAIN CO.
MAP DEPT.
DATE 4-2-92
PAGE 7-00-018-B
BY CAROLYN FRANCIS
VOID AFTER # 19843