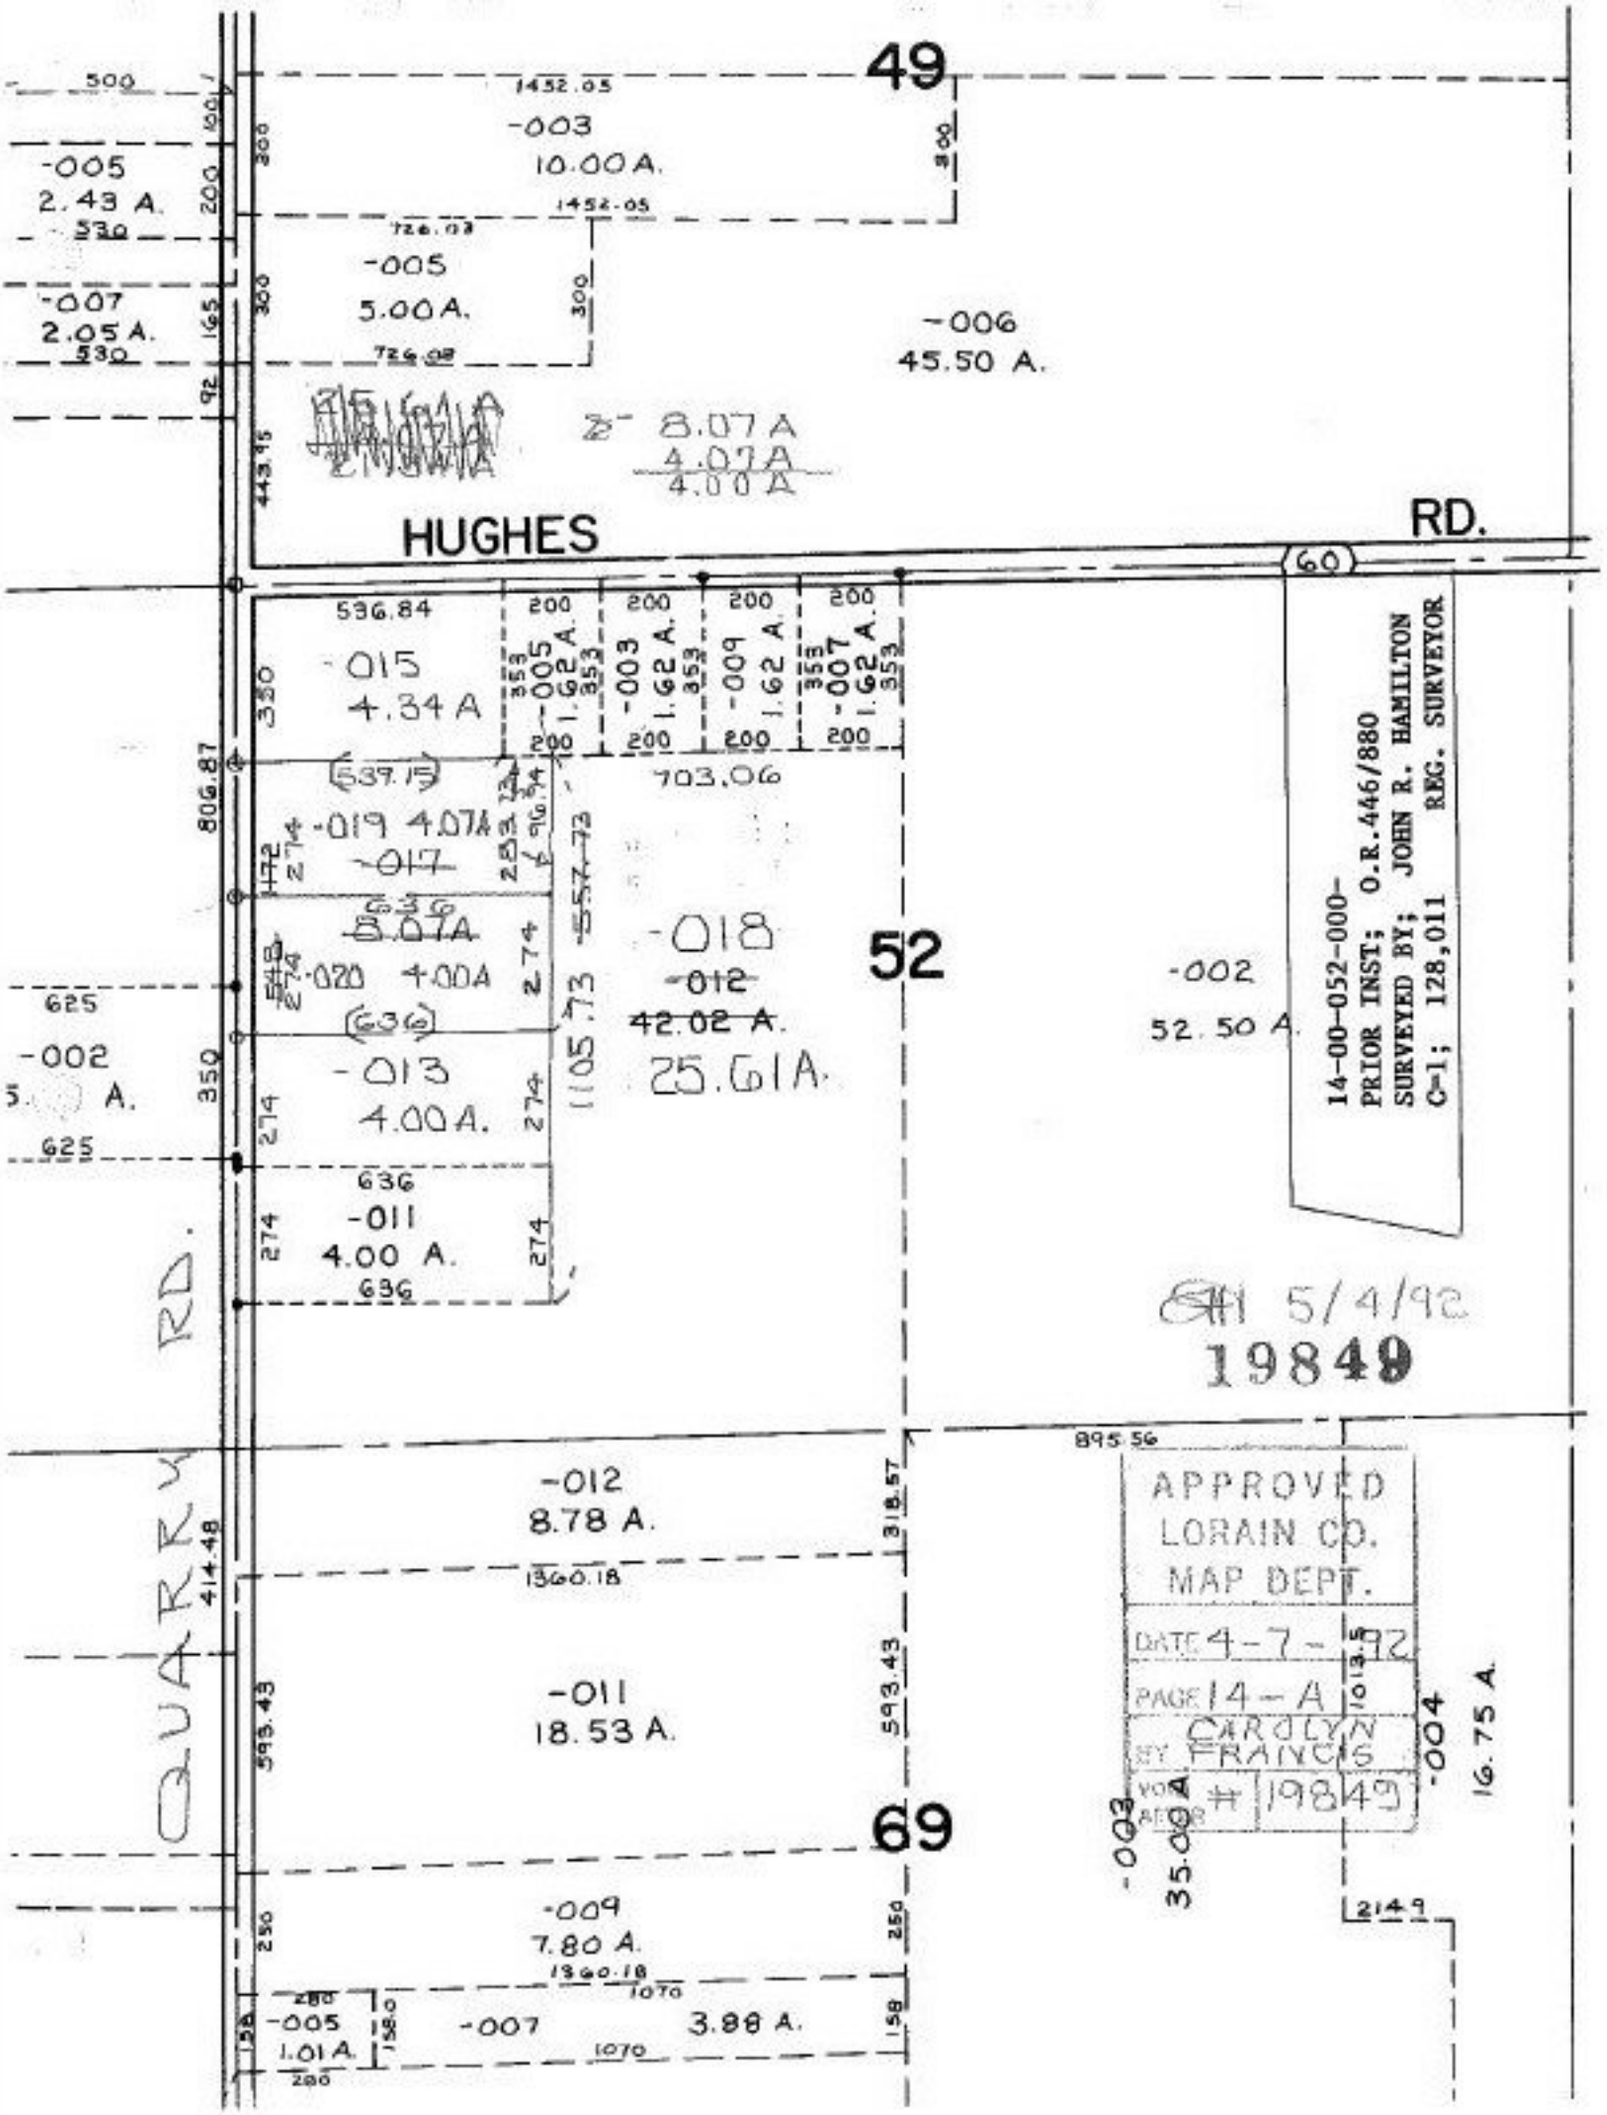
49
-003
10.00 A.
-005
2.43 A.
-005
5.00 A.
-007
2.05 A.
-006
45.50 A.
8.07 A
4.07 A
4.00 A
HUGHES RD.
60
-015
4.34 A
-005 1.62 A.
-003 1.62 A.
-009 1.62 A.
-007 1.62 A.
703.06
-019 4.07A
-017
5.07A
-020 4.00A
-018
-012
42.02 A.
25.61A.
52
-002
52.50 A.
-013
4.00 A.
-011
4.00 A.
14-00-052-000-
PRIOR INST; O.R.446/880
SURVEYED BY; JOHN R. HAMILTON
C-1; 128,011 REG. SURVEYOR
5/4/92
19849
APPROVED
LORAIN CO.
MAP DEPT.
DATE 4-7-92
PAGE 14-A
CAROLYN
BY FRANCIS
VOL # 19849
PAGE
-012
8.78 A.
-011
18.53 A.
69
-009
7.80 A.
-005
1.01 A.
-007
3.88 A.
-004
16.75 A.
-003
35.00 A.
QUARRY RD.