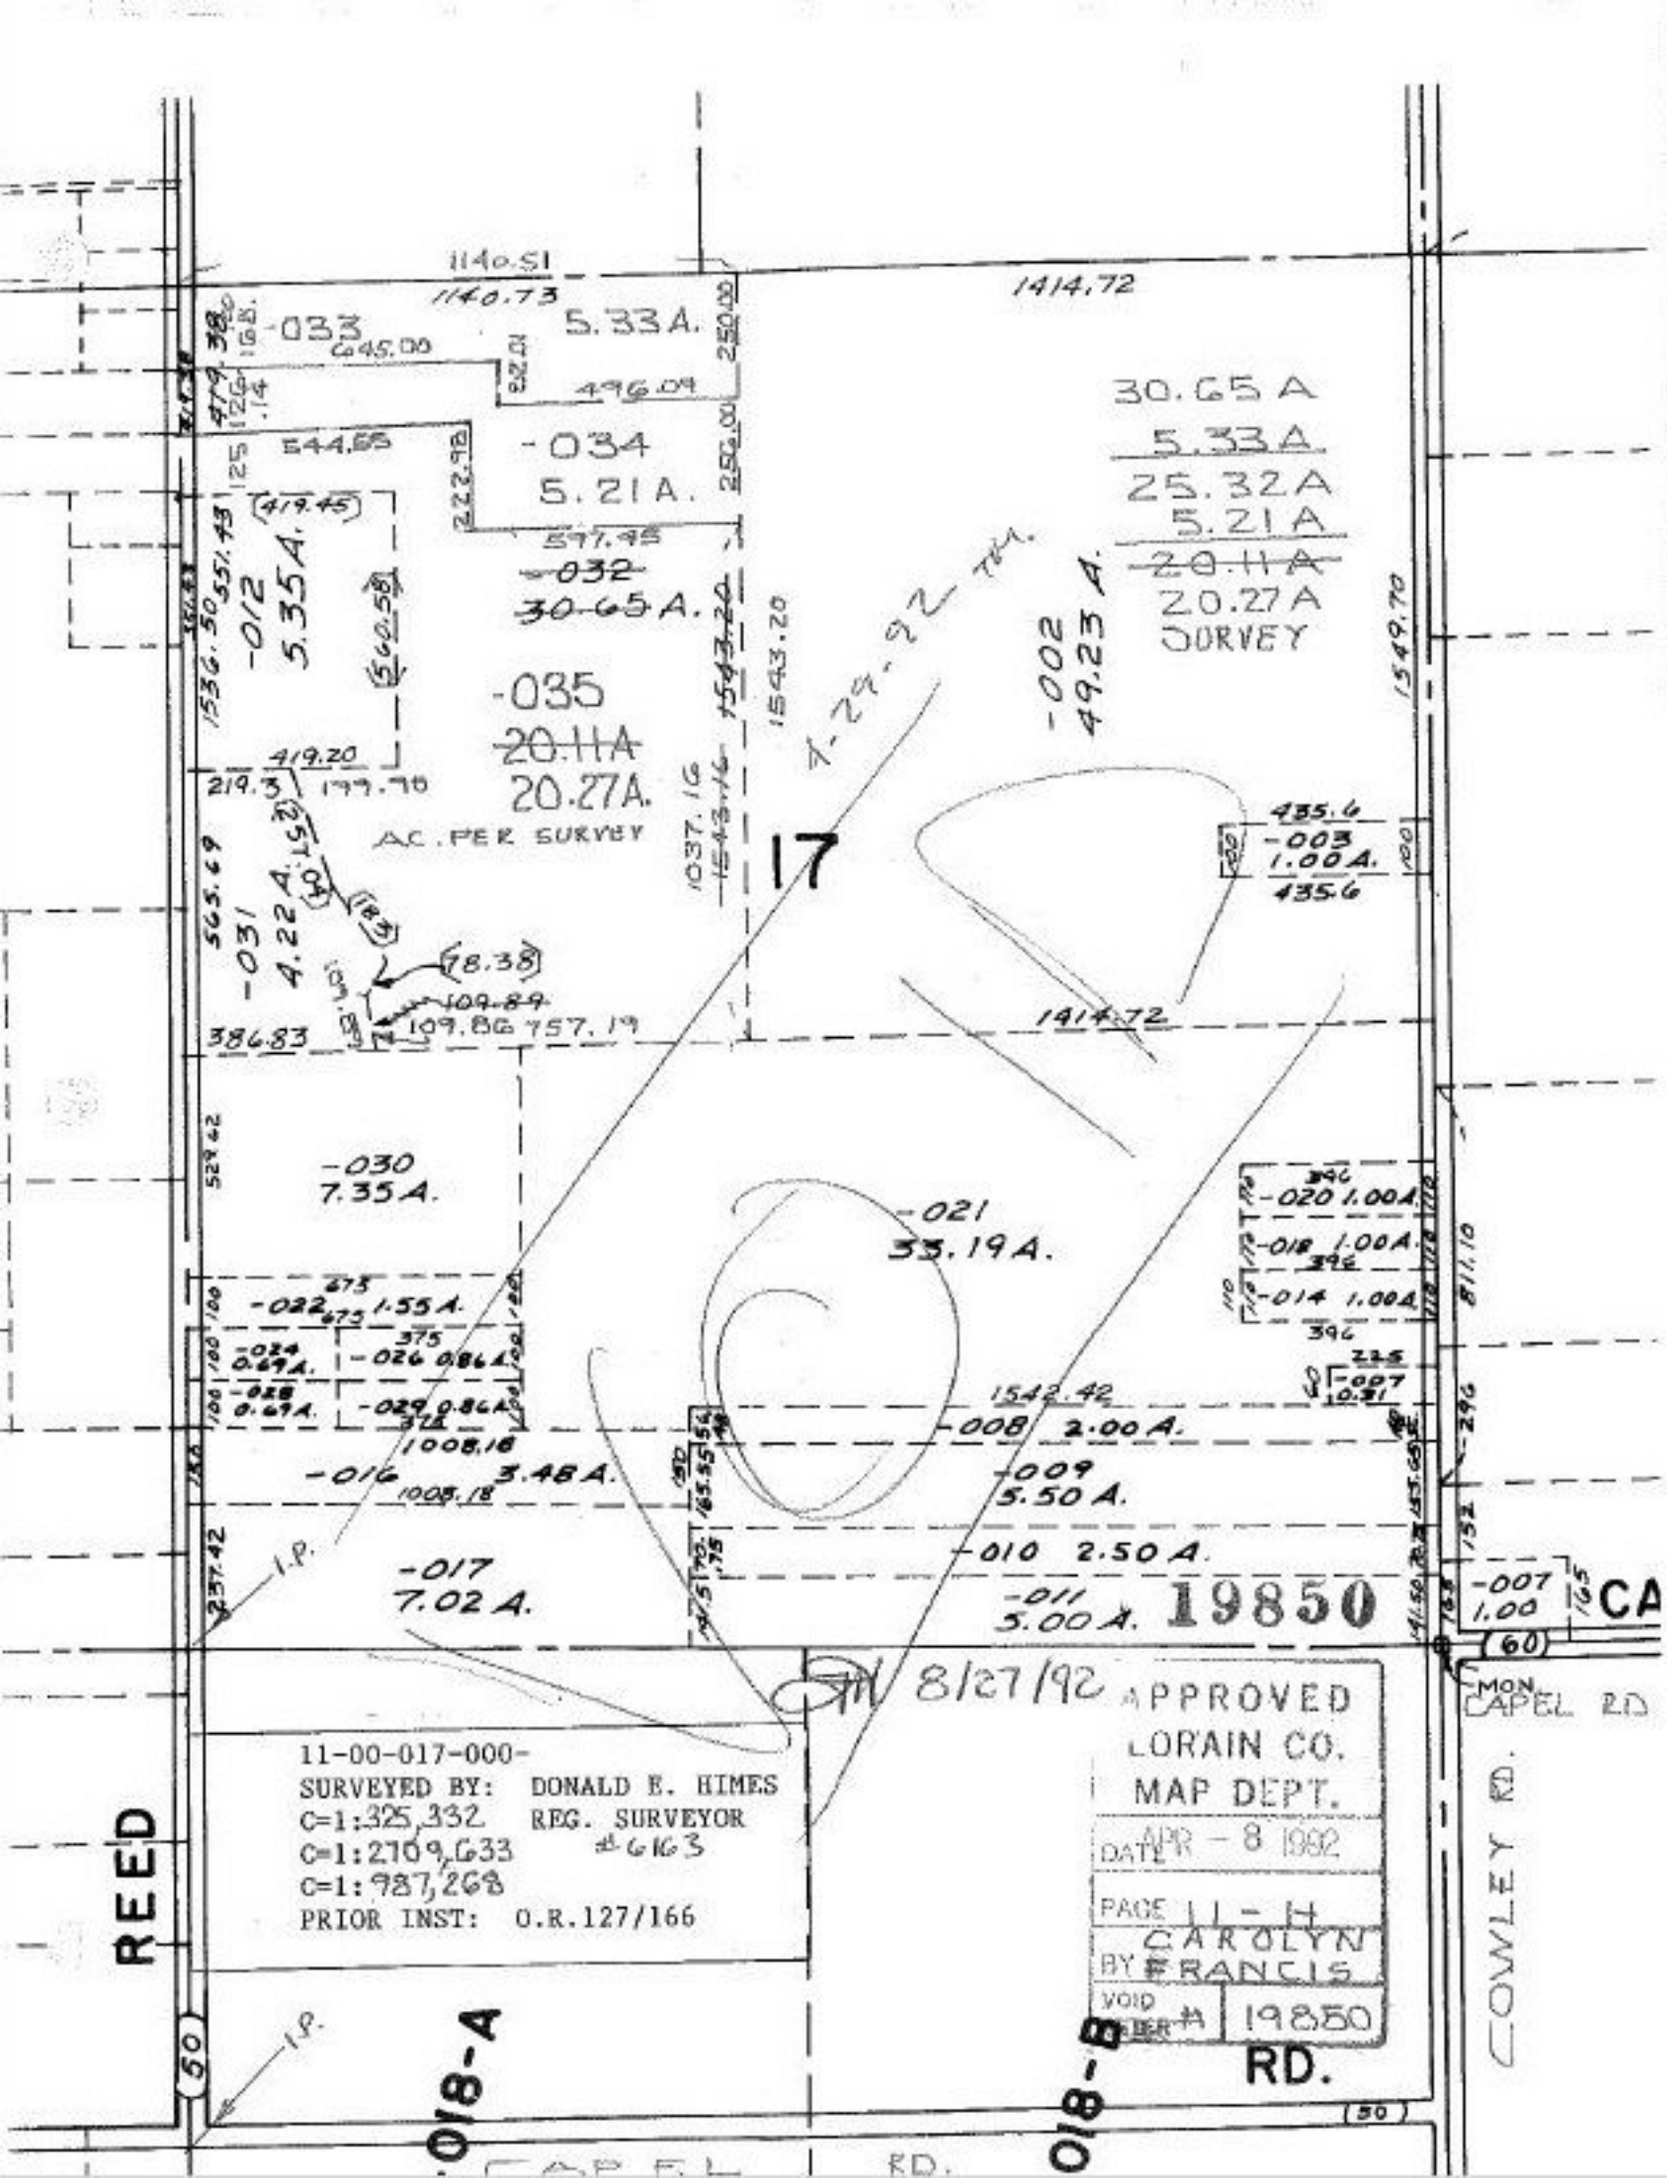

11-00-017-000-
SURVEYED BY: DONALD E. HIMES
C=1:325,332 REG. SURVEYOR
C=1:2709,633 #6163
C=1:987,268
PRIOR INST: O.R.127/166