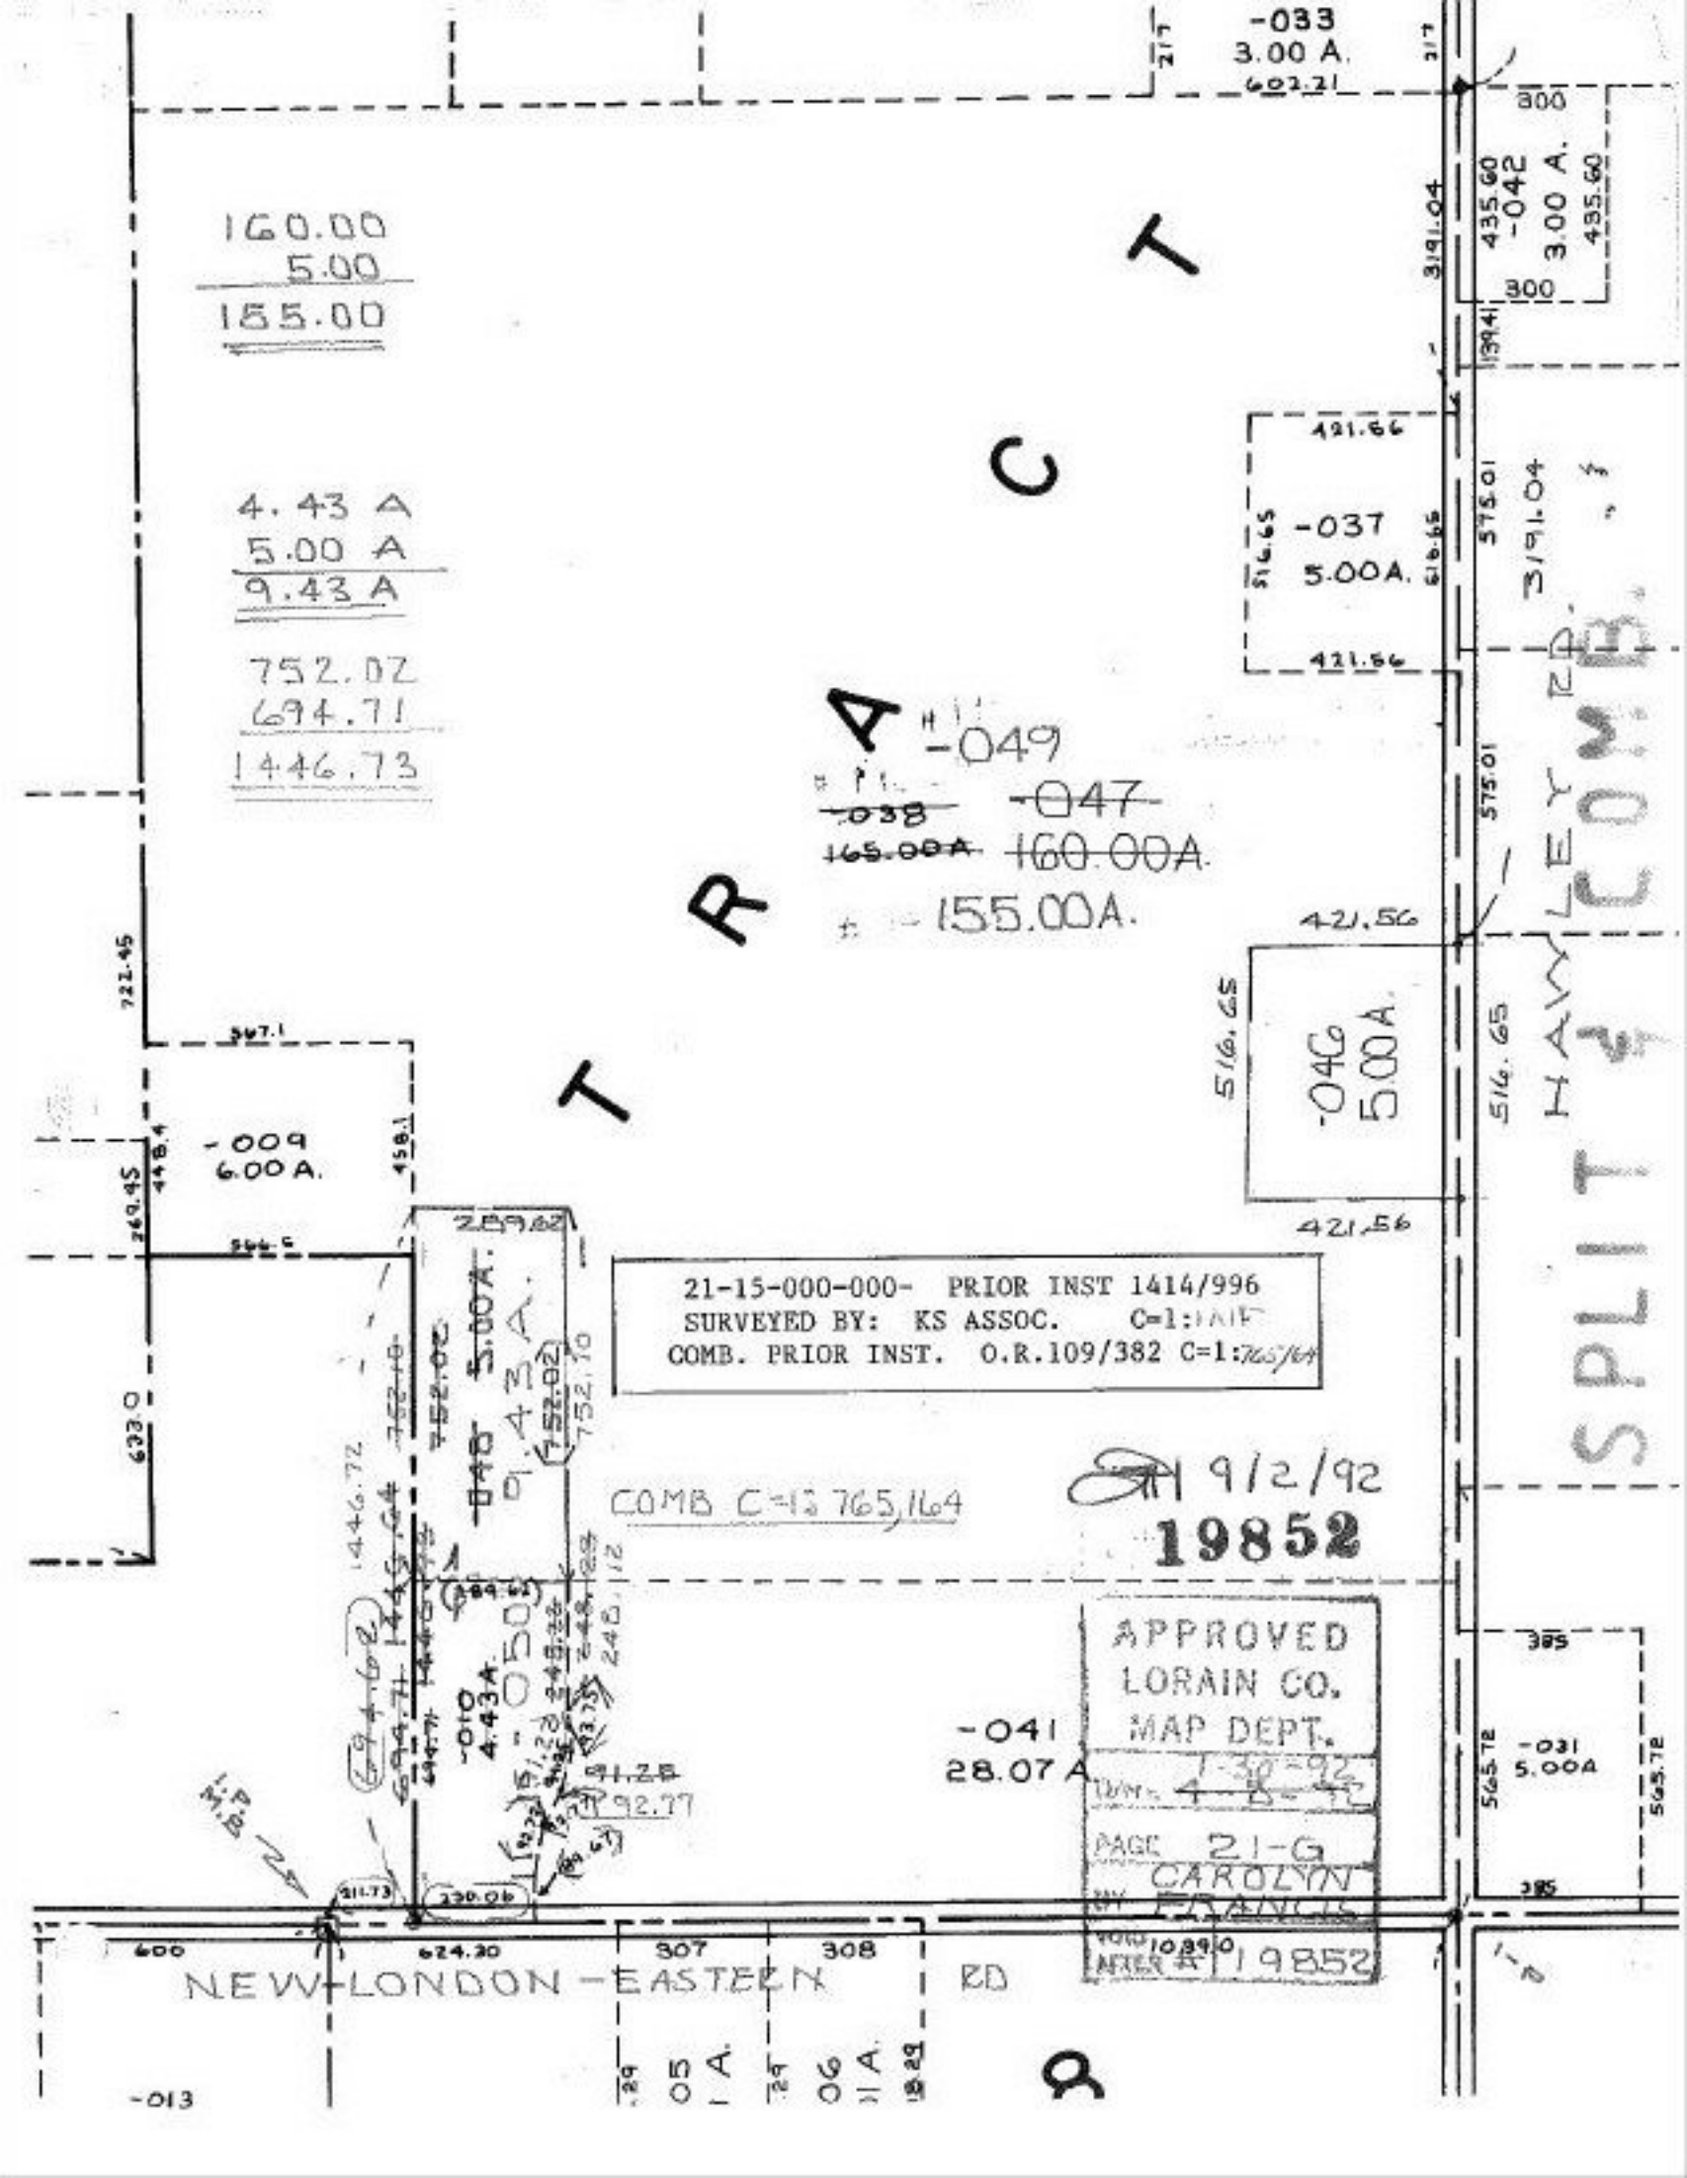

-033
3.00 A.
602.21
217
300
435.60
-042
3.00 A.
435.60
3191.04
300
139.41
160.00
5.00
155.00
421.56
-037
5.00A.
516.65
575.01
3191.04
4.43 A
5.00 A
9.43 A
752.02
694.71
1446.73
-049
~~-038~~
~~165.00A~~
~~-047~~
~~160.00A~~
155.00A.
421.56
516.65
-046
5.00A.
516.65
HAWLEY RD.
SPLIT & COMB.
722.45
567.1
-009
6.00 A.
448.4
458.1
269.45
566.5
289.62
21-15-000-000- PRIOR INST 1414/996
SURVEYED BY: KS ASSOC. C=1:
COMB. PRIOR INST. O.R.109/382 C=1:765/164
633.0
752.02
752.10
9.43 A.
COMB C=1: 765,164
9/2/92
19852
1446.72
1446.64
-010
4.43A.
-050
-041
28.07 A
APPROVED
LORAIN CO.
MAP DEPT.
1-30-92
PAGE 21-G
CAROLYN
FRANCIS
19852
385
565.72
-031
5.00A
565.72
385
211.73
230.06
600
624.30
307
308
NEW LONDON - EASTERN RD
-013