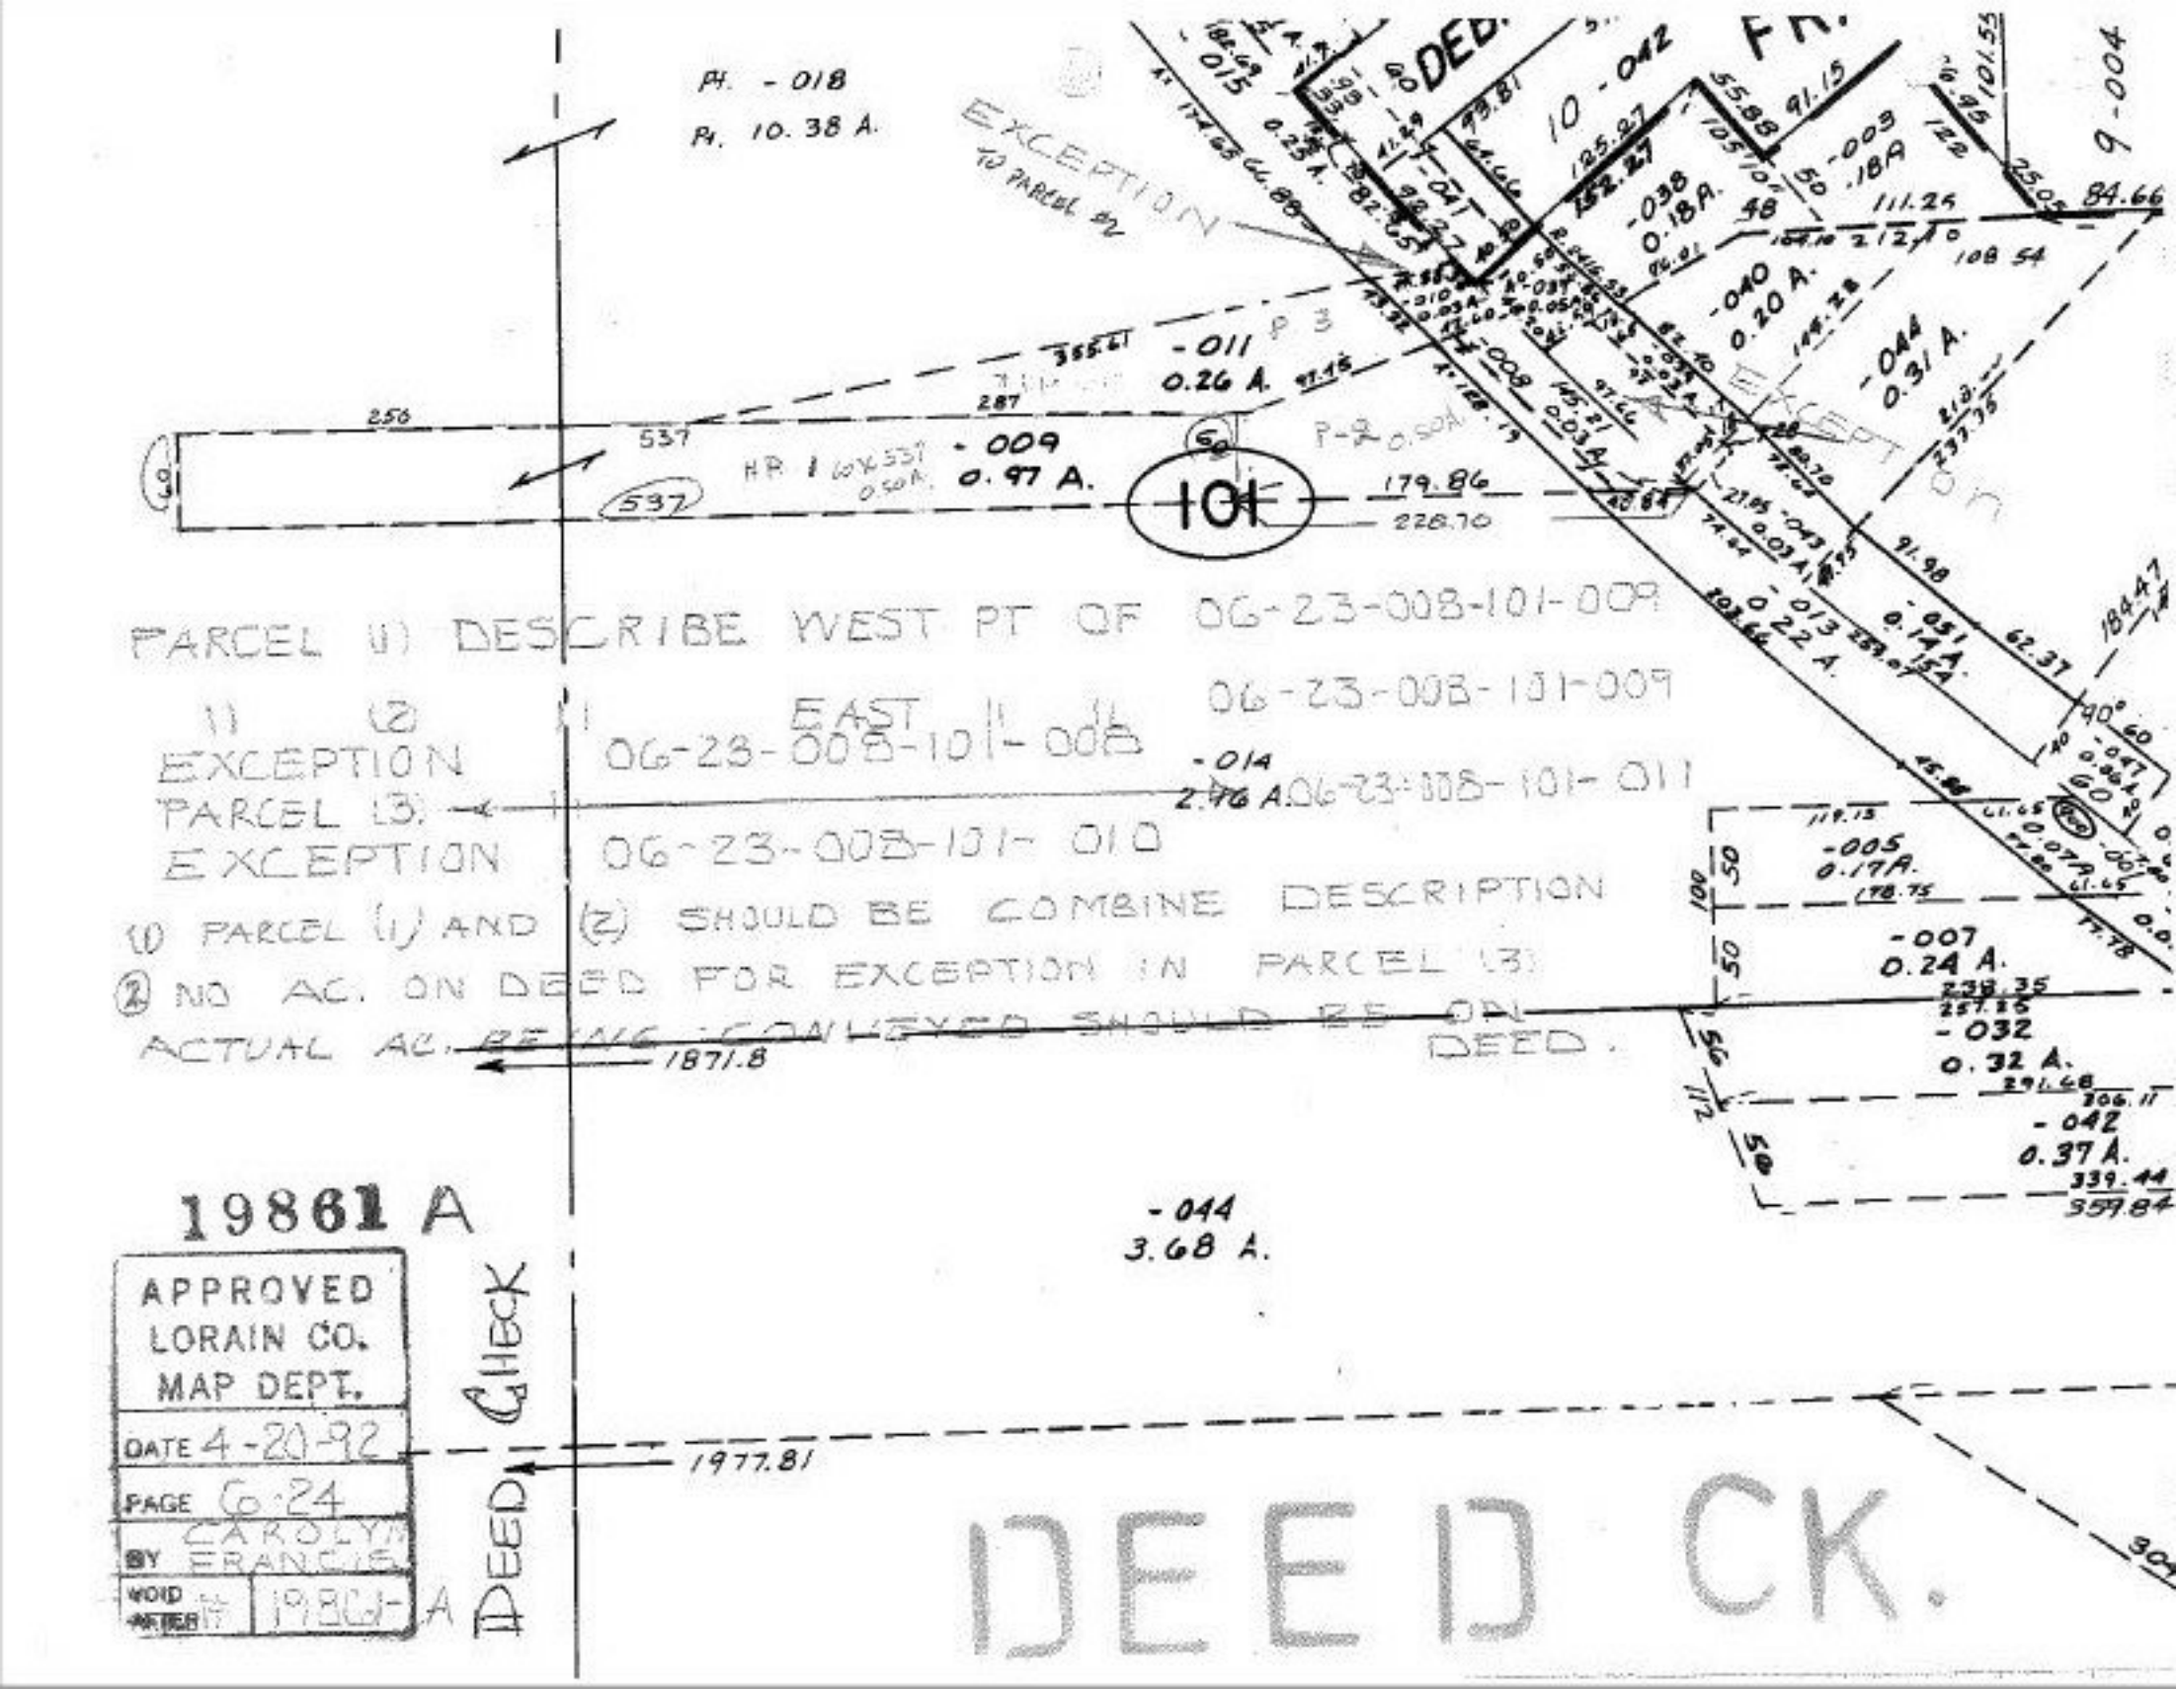

PARCEL (1) DESCRIBE WEST PT OF 06-23-008-101-009

(1) (2) EAST 06-23-008-101-009

EXCEPTION 06-23-008-101-008 06-23-008-101-011

PARCEL (3) 06-23-008-101-010

EXCEPTION

(1) PARCEL (1) AND (2) SHOULD BE COMBINE DESCRIPTION

(2) NO AC. ON DEED FOR EXCEPTION IN PARCEL (3)

ACTUAL AC. BEING COMBINED SHOULD BE ON DEED.

19861 A

APPROVED
LORAIN CO.
MAP DEPT.
DATE 4-20-92
PAGE 6-24
BY CAROLYN FRANCIS
VOID AFTER 19861-A

DEED CHECK