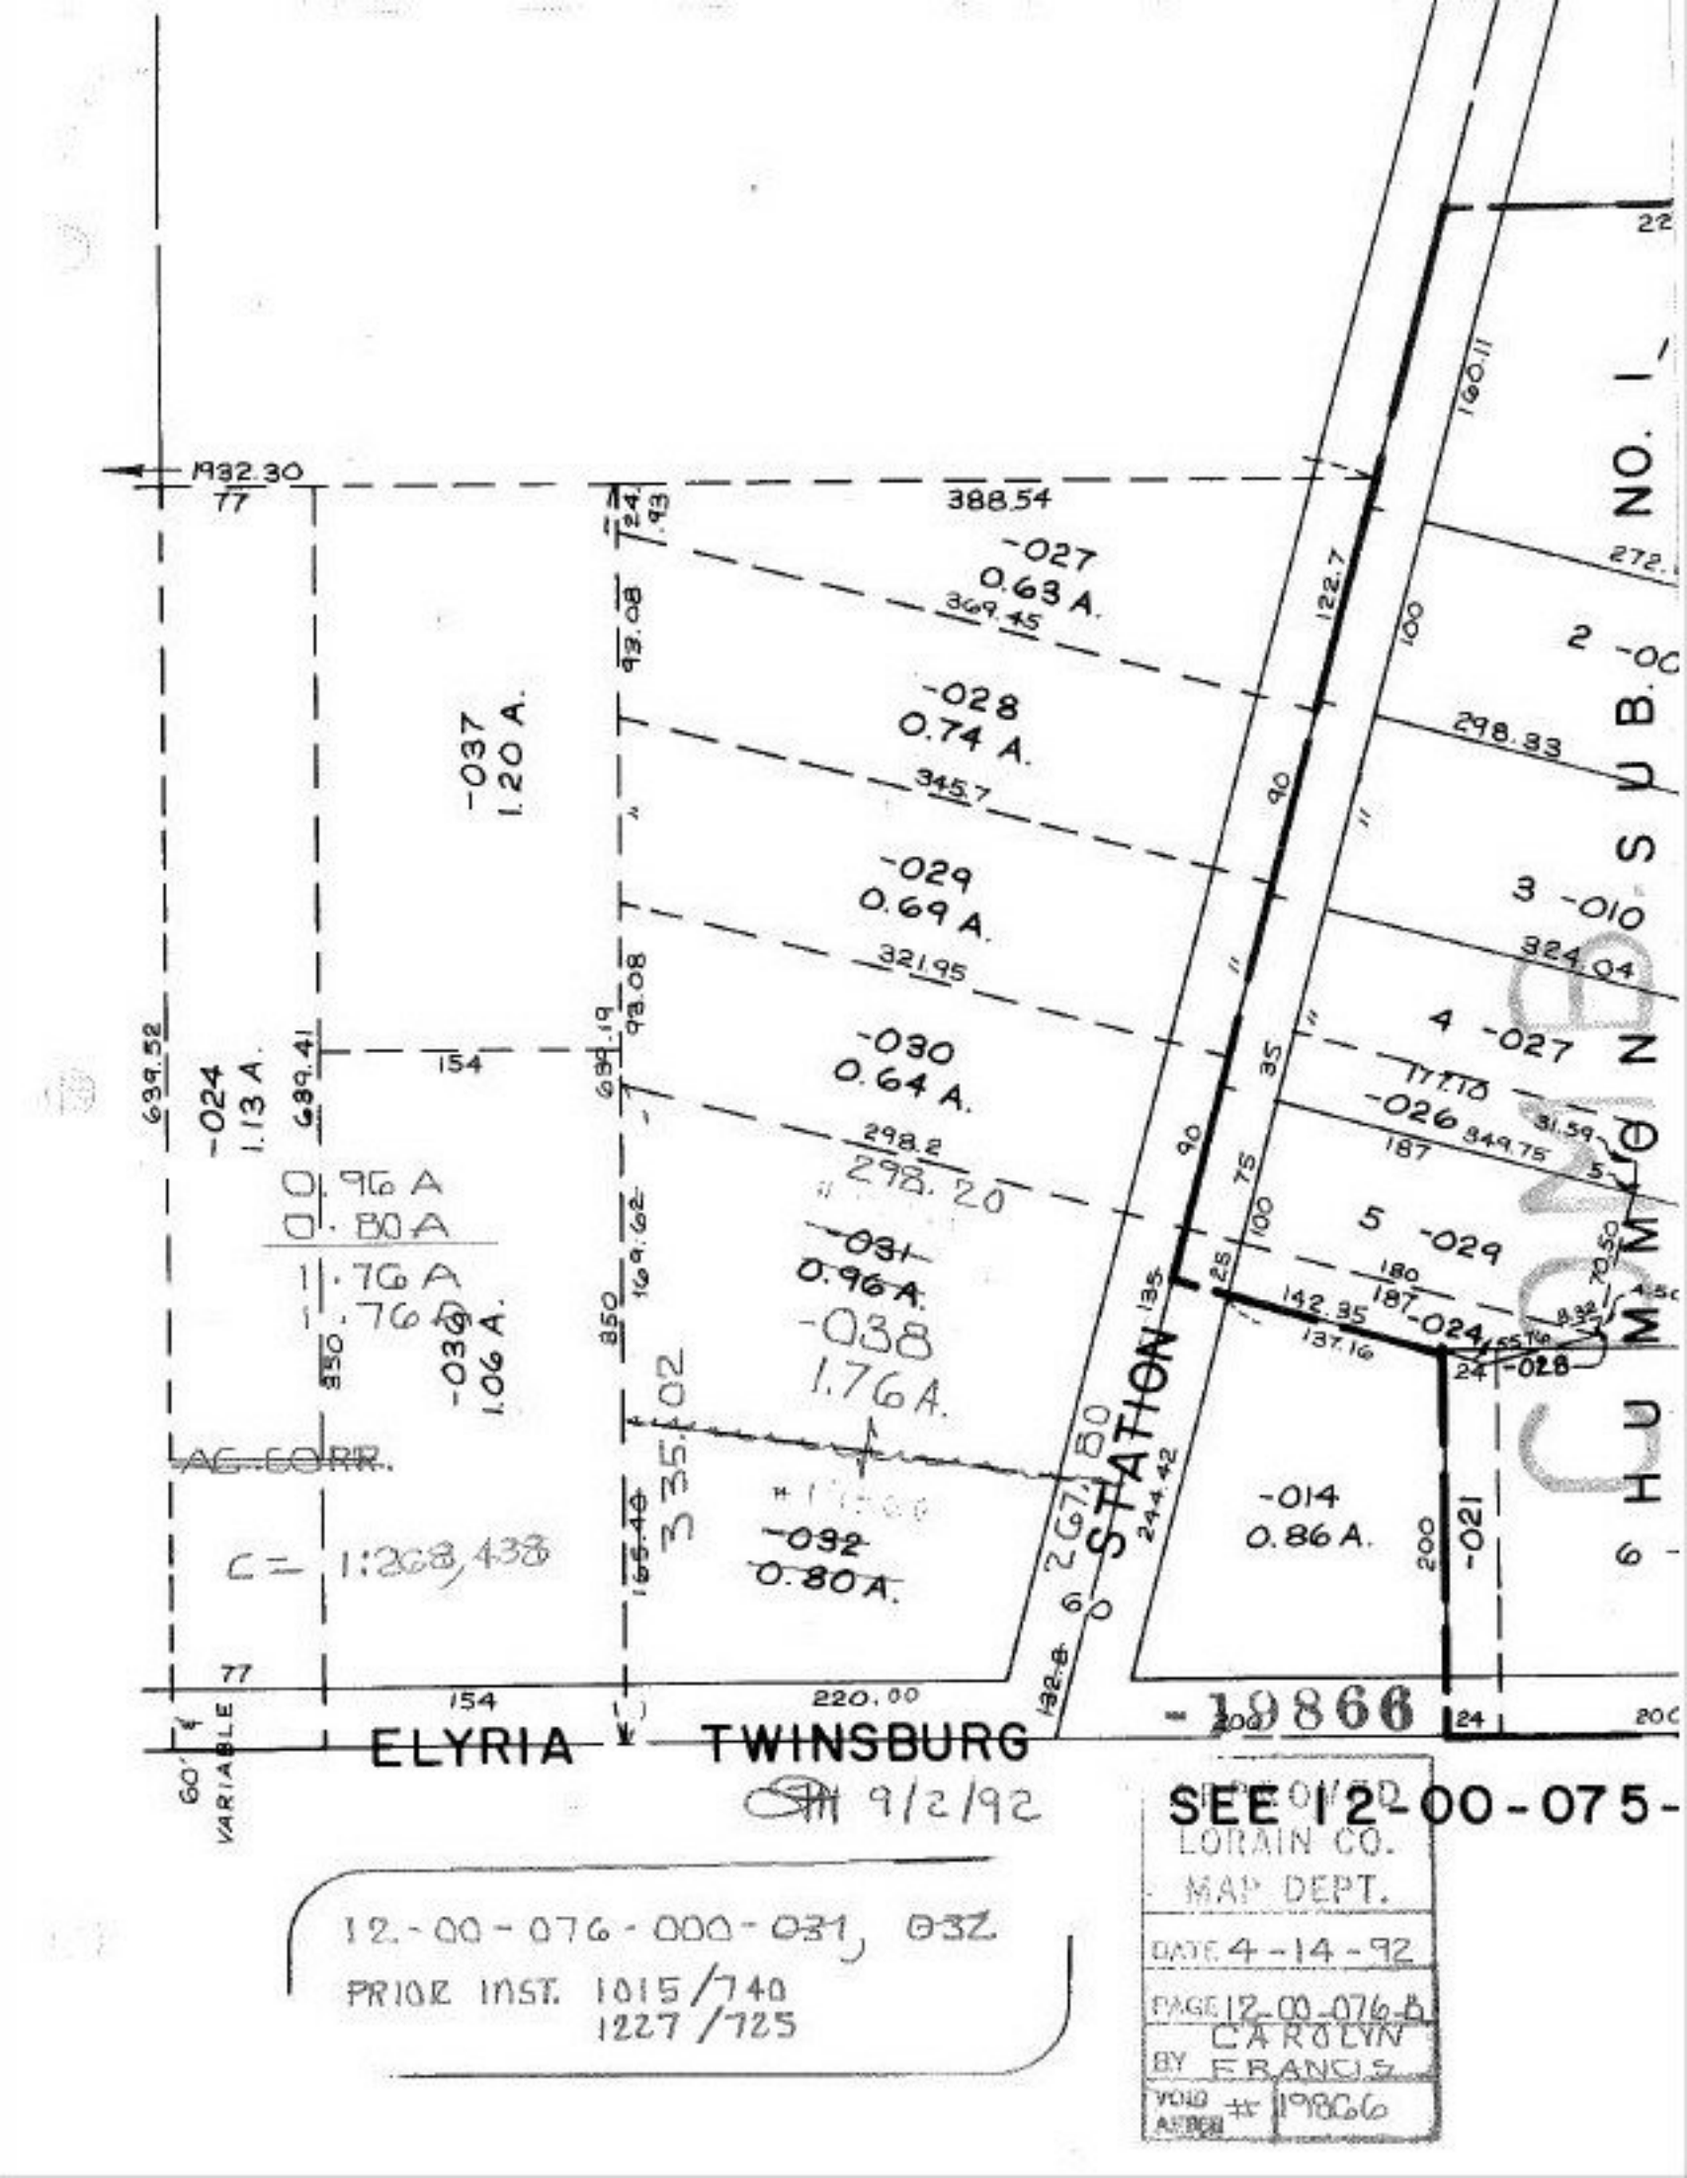
1932.30
77
388.54
-027
0.63 A.
369.45
-028
0.74 A.
345.7
-029
0.69 A.
321.95
-030
0.64 A.
298.2
298.20
-031
0.96 A.
-038
1.76 A.
-037
1.20 A.
-024
1.13 A.
639.52
689.41
154
0.96 A
0.80 A
1.76 A
-036
1.06 A.
AG. CORR.
C = 1:208,438
335.02
-032
0.80 A.
-027
0.86 A.
-021
-014
0.86 A.
244.42
267.80
STATION
ELYRIA
TWINSBURG
220.00
77
154
60' VARIABLE
9/2/92
SEE 12-00-075-
19866
LORAIN CO.
MAP DEPT.
DATE 4-14-92
PAGE 12-00-076-B
CAROLYN
BY FRANCIS
VOID AFFIDAVIT # 19866
12-00-076-000-031, 032
PRIOR INST. 1015/740
1227/725
SUB. NO. 1
HUMMEL