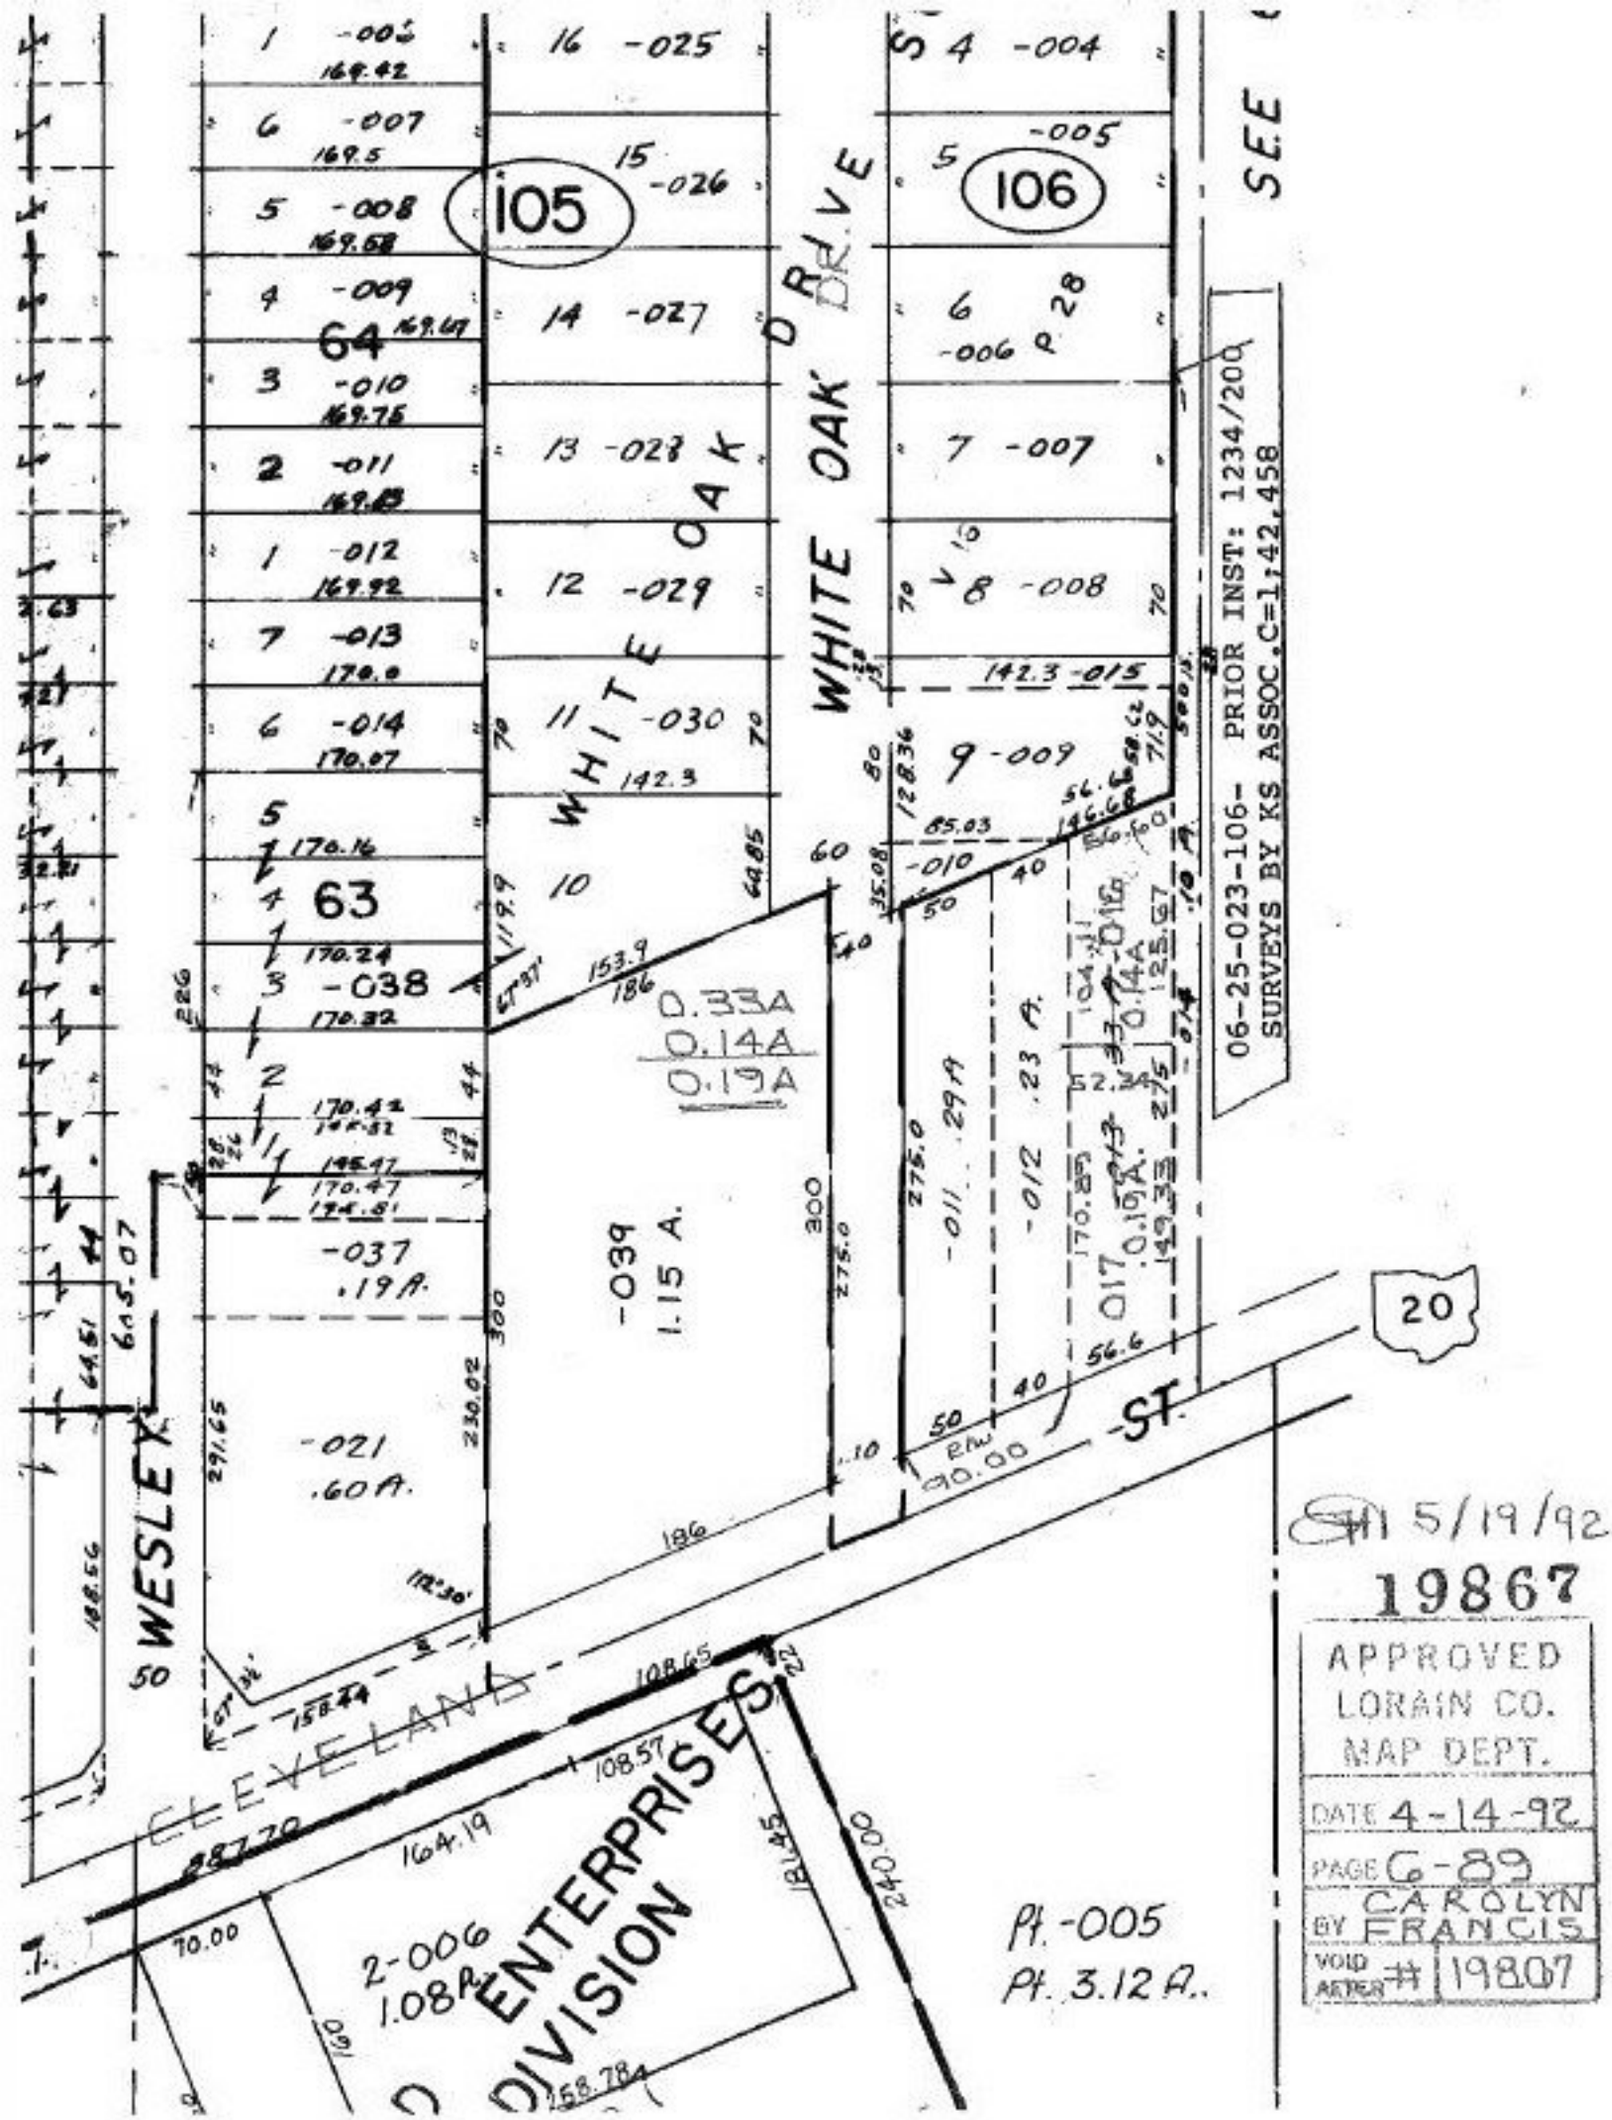


5/19/92

19867

APPROVED
LORAIN CO.
MAP DEPT.

DATE 4-14-92

PAGE 6-89

BY CAROLYN FRANCIS

VOID AFTER # 19807