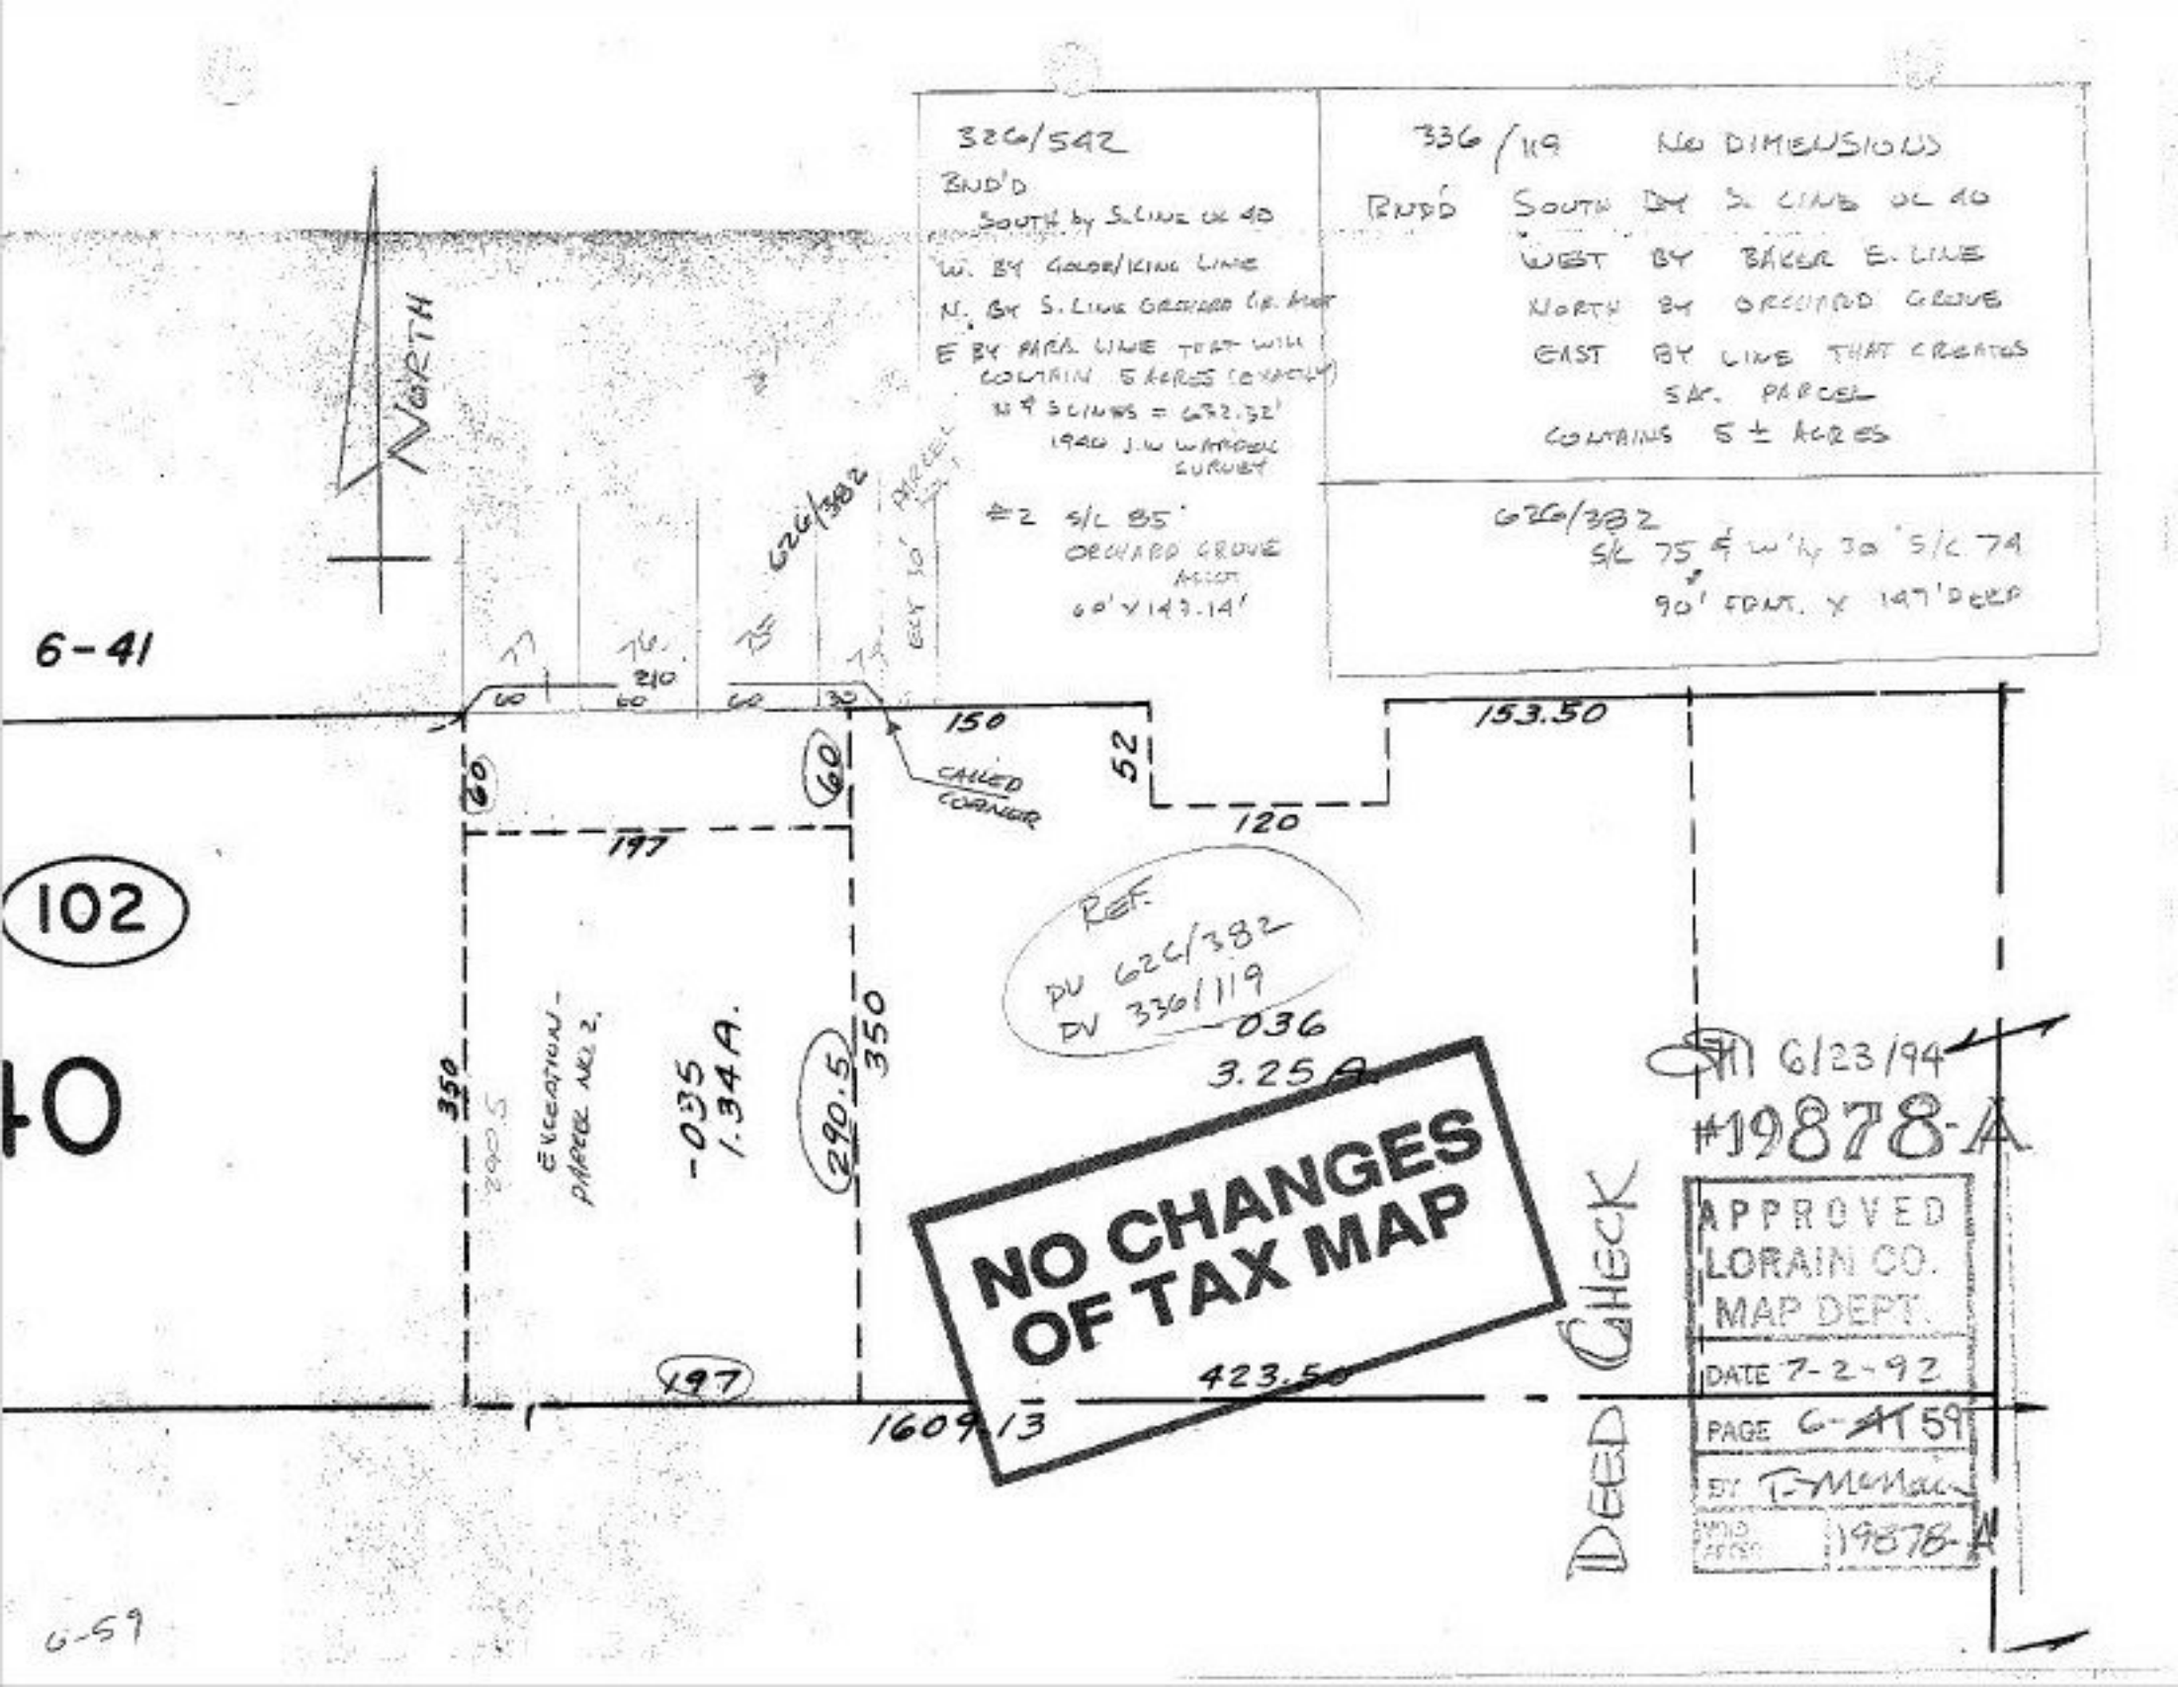
326/542
BND'D
SOUTH by S. LINE OF 40
W. BY GOLDER/KING LINE
N. BY S. LINE ORCHARD GR. ADDT
E BY PARA. LINE THAT WILL CONTAIN 5 ACRES (EXACTLY)
N & S LINES = 672.32'
1940 J.W. WARNER SURVEY
#2 S/L 85'
ORCHARD GROVE ADDT
60' X 147.14'
336/119 NO DIMENSIONS
BND'D SOUTH BY S. LINE OF 40
WEST BY BAKER E. LINE
NORTH BY ORCHARD GROVE
EAST BY LINE THAT CREATES SAL. PARCEL
CONTAINS 5 ± ACRES
626/382
S/L 75 & W'LY 30 S/L 74
90' FRNT. X 147' DEEP
N
6-41
102
40
626/382
PARCEL
EXC 30'
60
210
60
60
60
30
150
CALLED CORNER
52
153.50
120
197
350
290.5
-035
1.34 A.
-036
3.25 A
423.50
1609.13
REF.
DV 626/382
DV 336/119
NO CHANGES OF TAX MAP
DEED CHECK
6/23/94
#19878-A
APPROVED
LORAIN CO.
MAP DEPT.
DATE 7-2-92
PAGE 6-A 59
BY D. McMahon
PARCEL # 19878-A
6-59