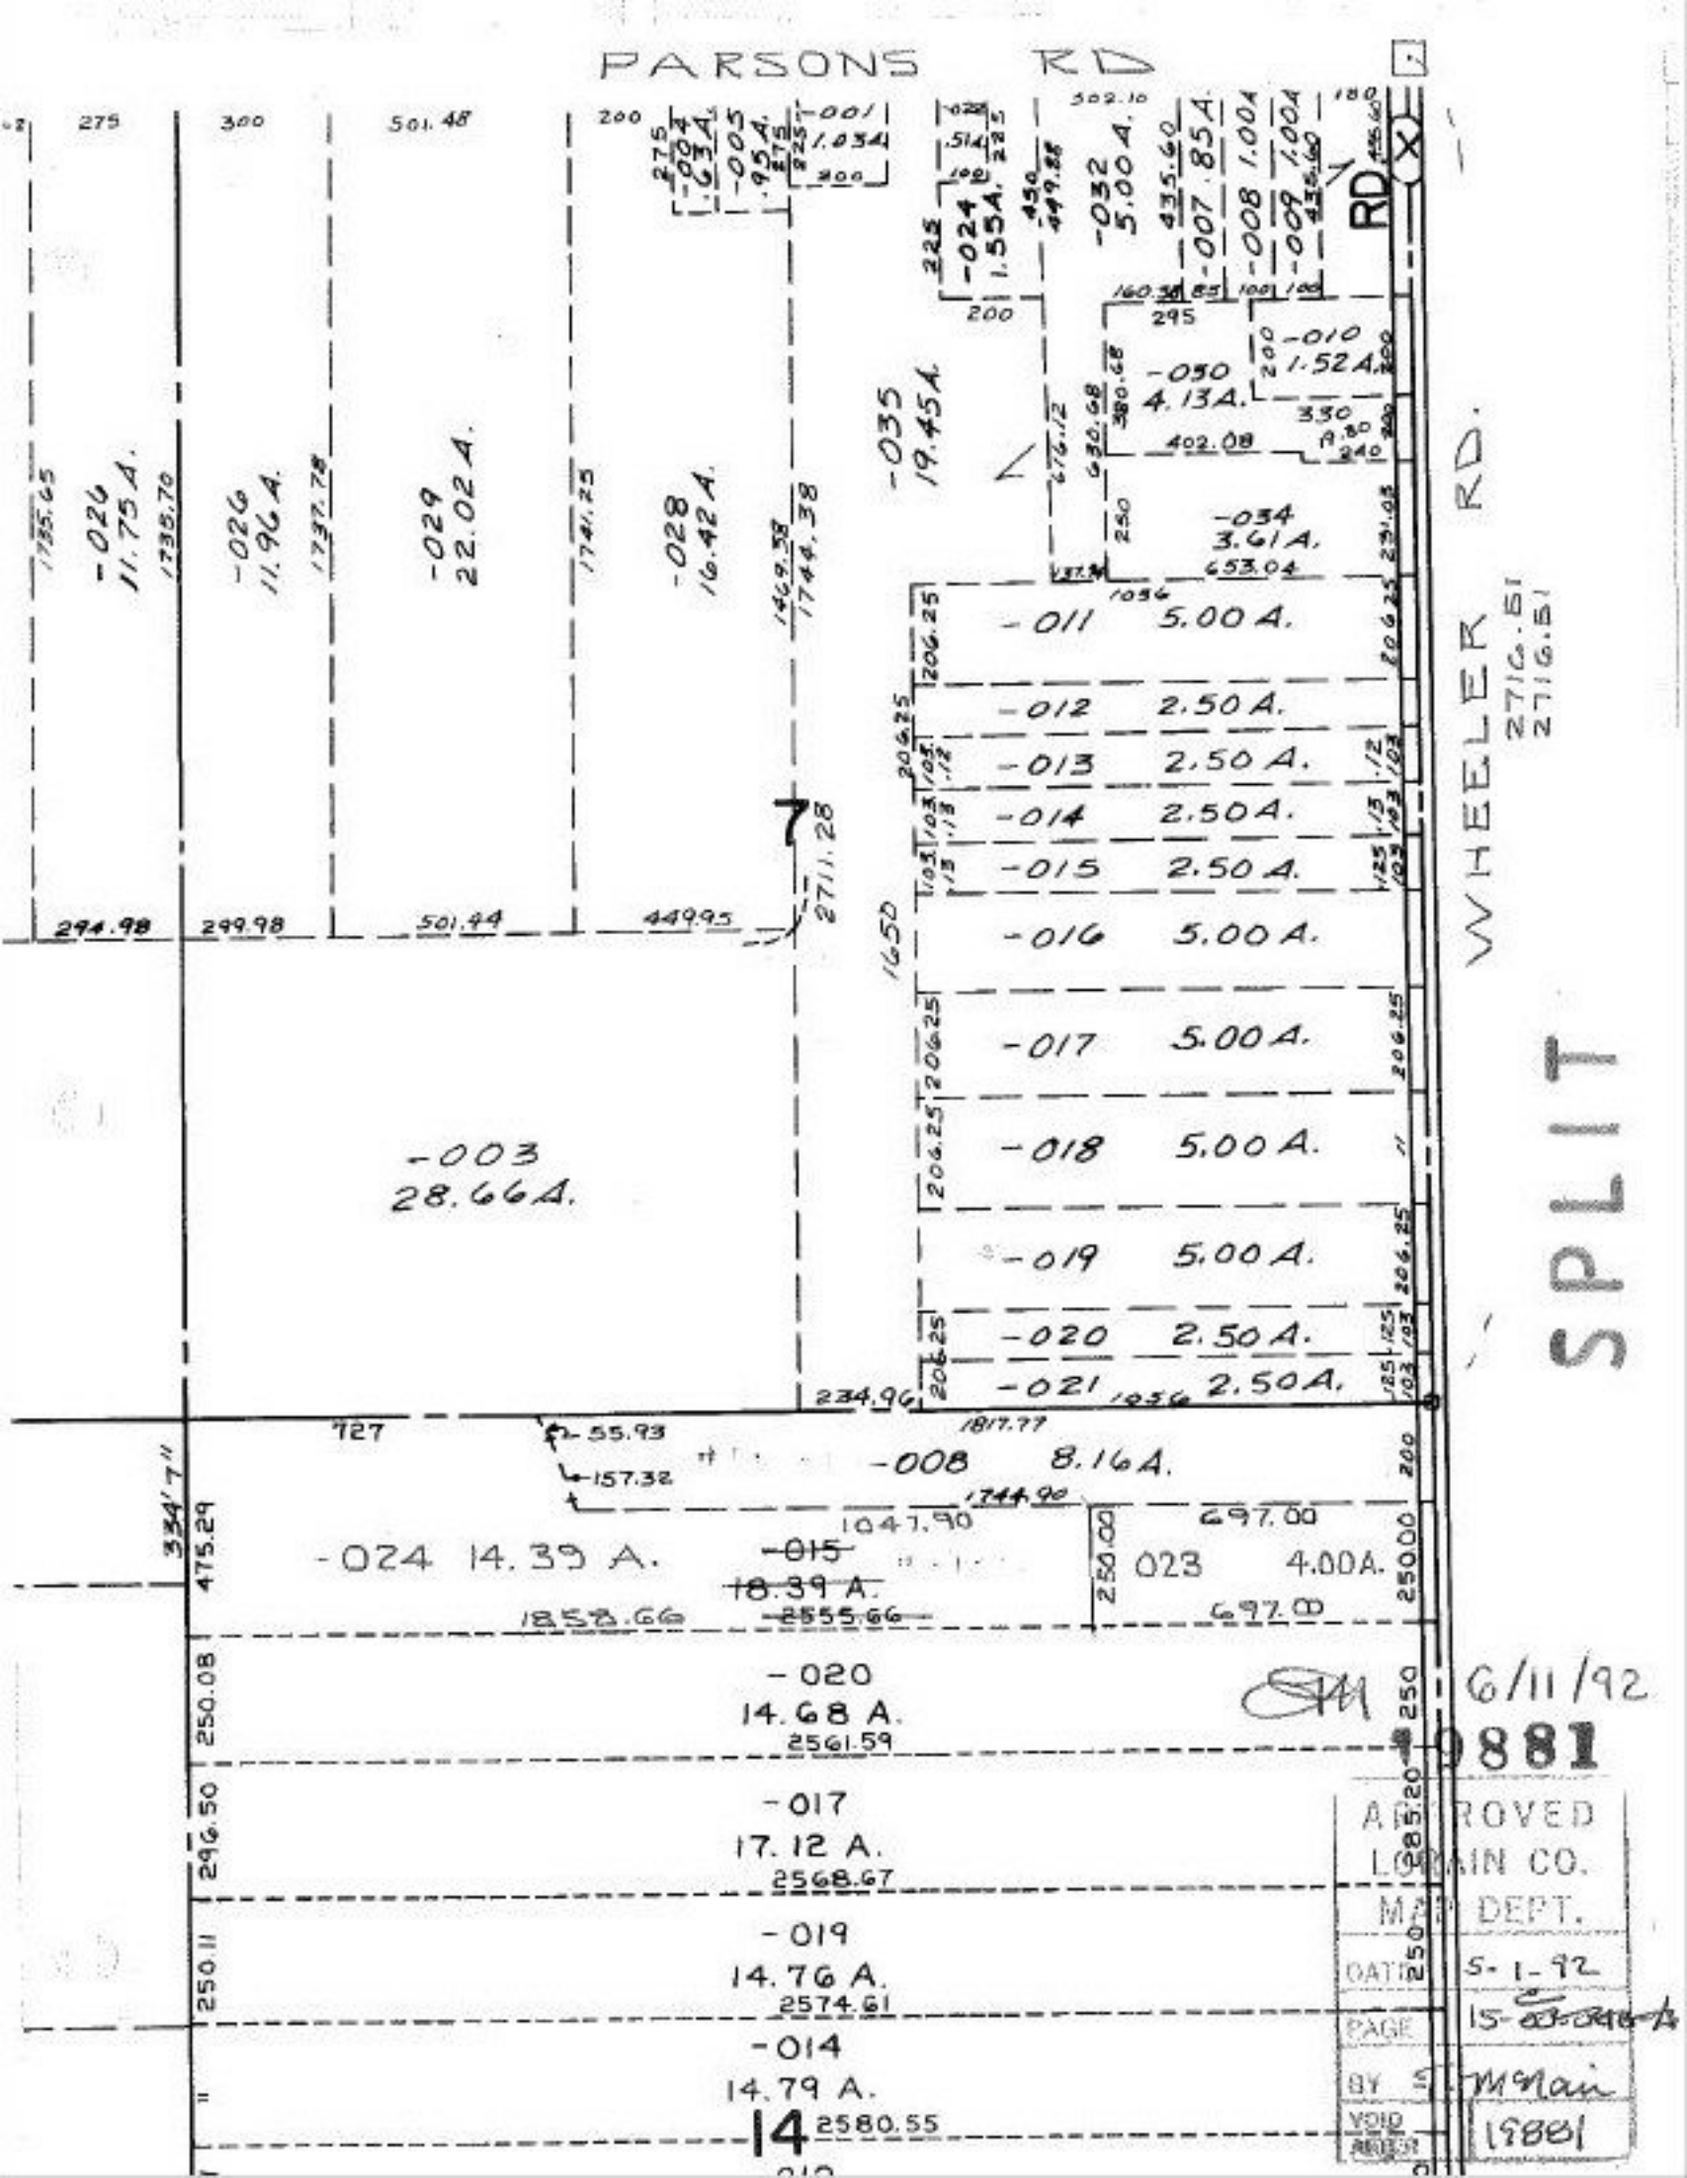
PARSONS RD
WHEELER RD.
SPLIT
-026 11.75A.
-026 11.96A.
-029 22.02A.
-028 16.42A.
-035 19.45A.
-003 28.66A.
-032 5.00A.
-007 .85A.
-008 1.00A.
-009 1.00A.
-010 1.52A.
-050 4.13A.
-034 3.61A.
-011 5.00A.
-012 2.50A.
-013 2.50A.
-014 2.50A.
-015 2.50A.
-016 5.00A.
-017 5.00A.
-018 5.00A.
-019 5.00A.
-020 2.50A.
-021 2.50A.
-024 14.39 A.
-015 18.39 A.
-008 8.16A.
023 4.00A.
-020 14.68 A.
-017 17.12 A.
-019 14.76 A.
-014 14.79 A.
14
7
6/11/92
0881
APPROVED
LORAIN CO.
MAP DEPT.
DATE 5-1-92
PAGE 15-03-016-A
BY M Main
VOID 19881