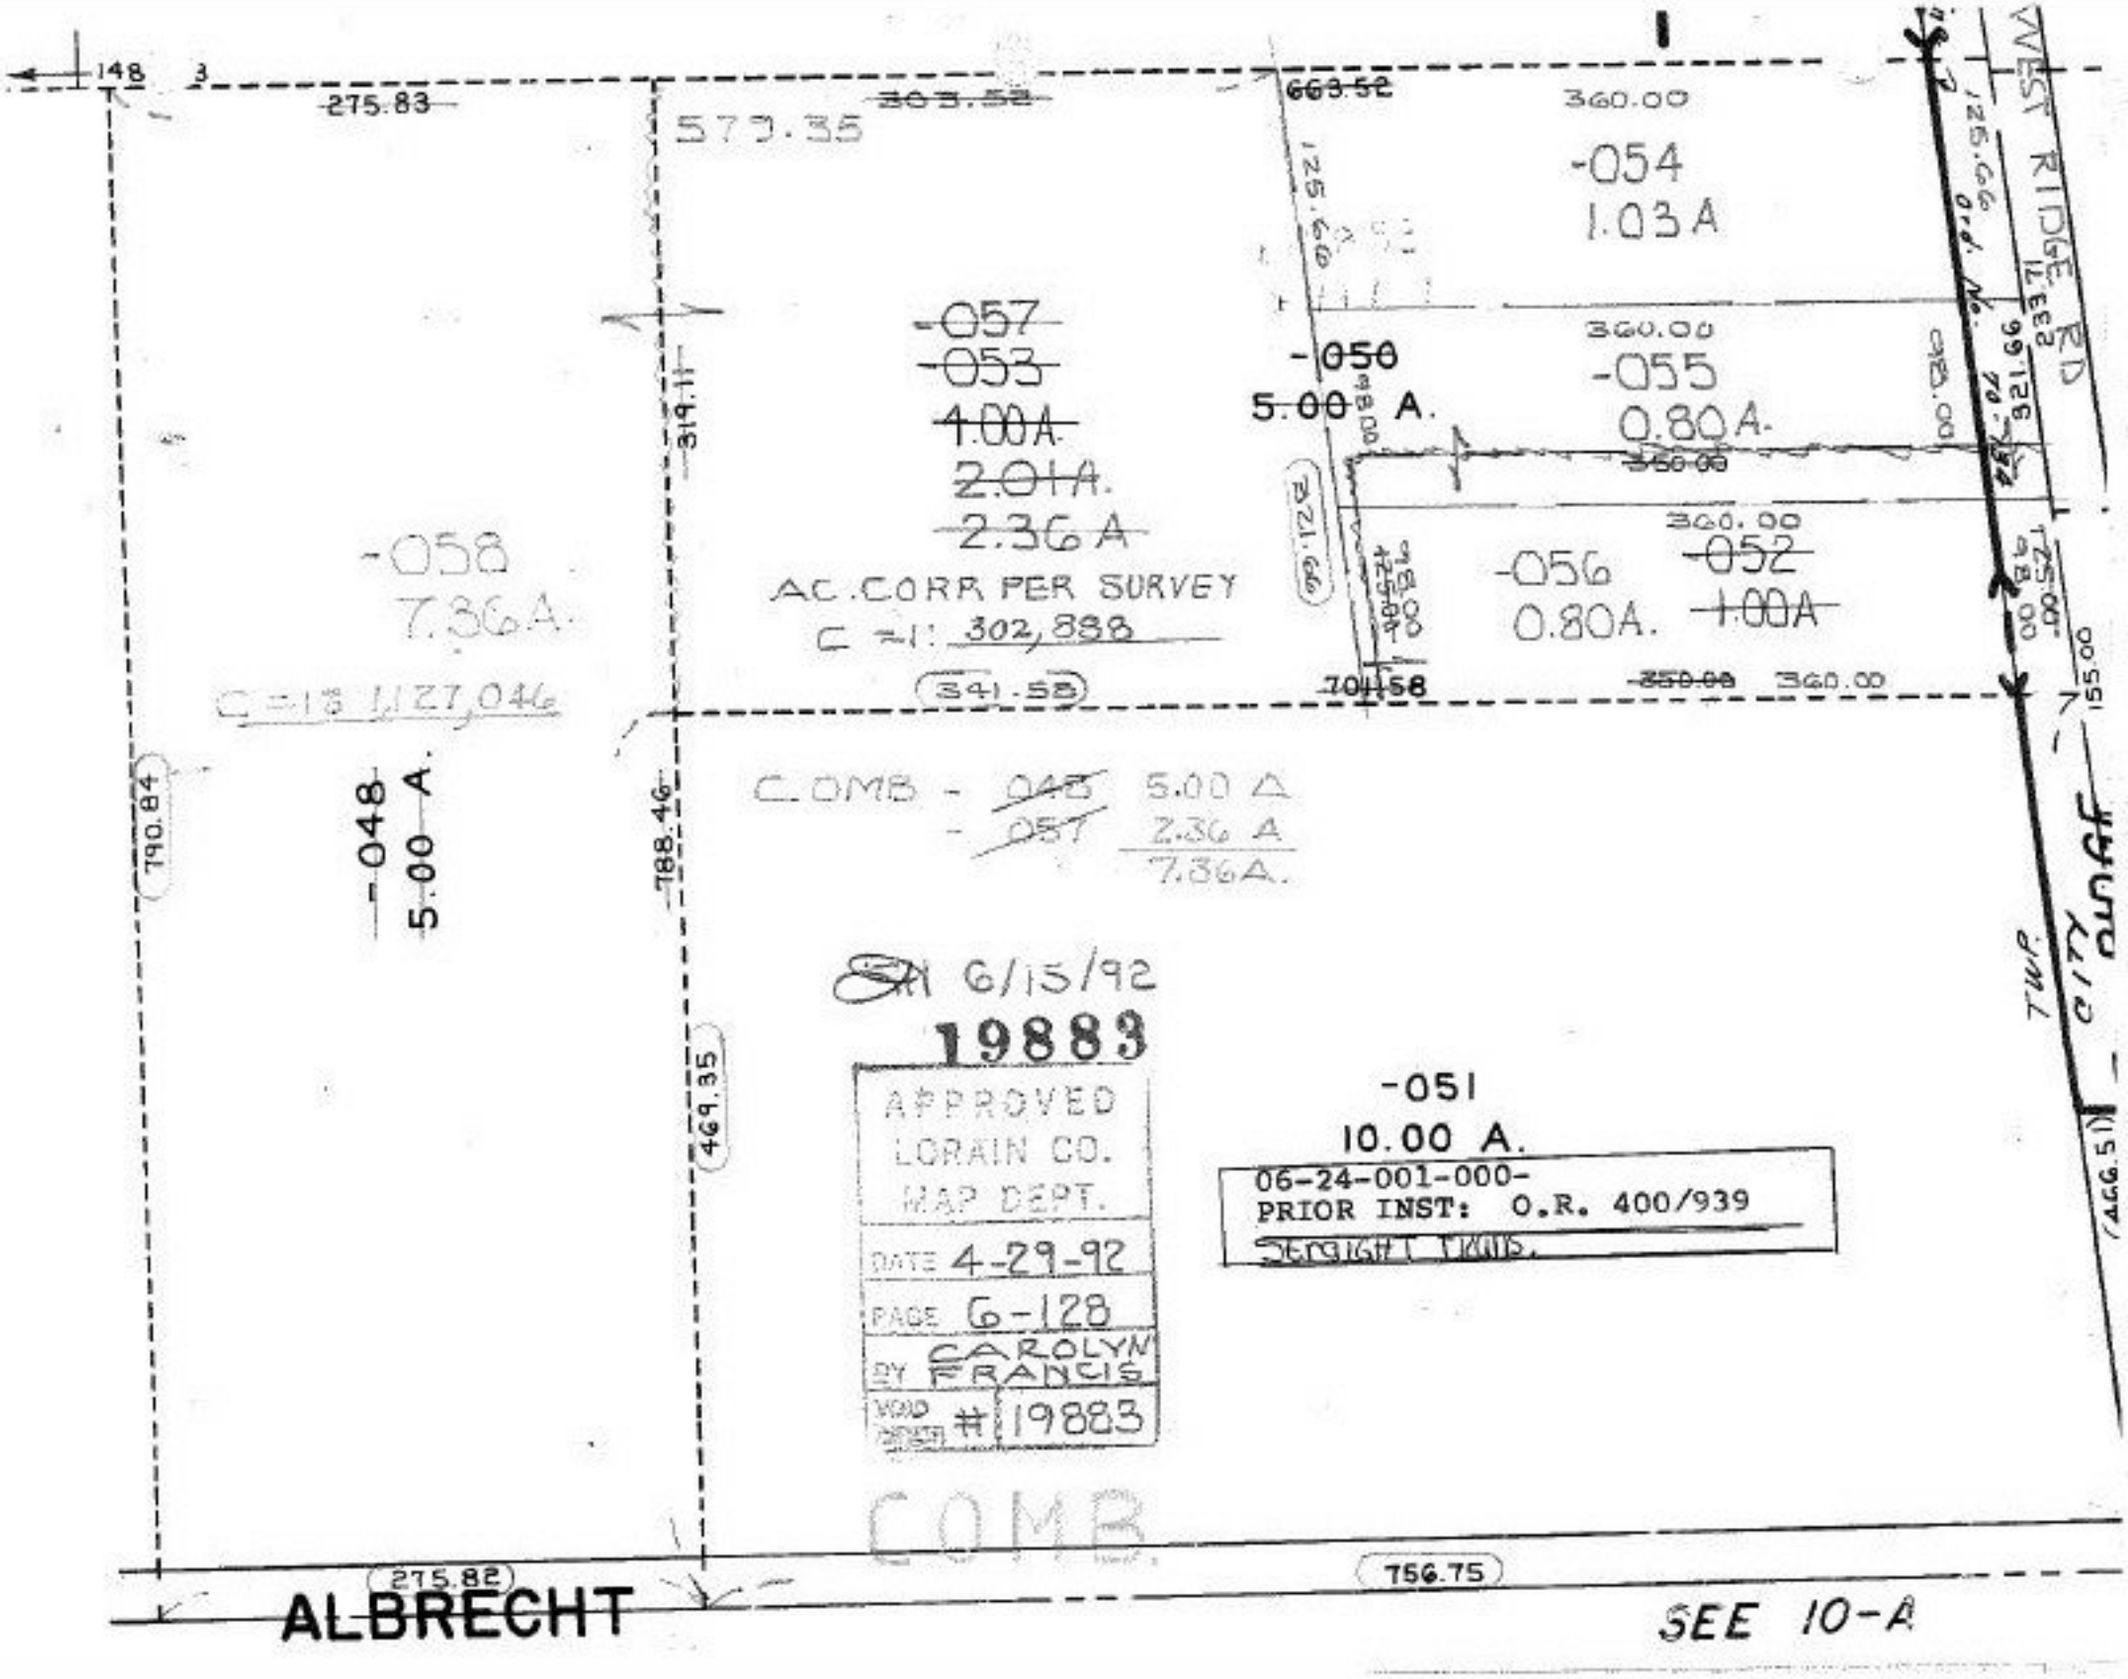
148
275.83
303.52
570.35
663.52
360.00
-054
1.03A
125.66
321.66
-057
-053
1.00A
2.01A.
2.36A
AC. CORR PER SURVEY
C = 1: 302,888
-050
5.00 A.
360.00
-055
0.80A.
360.00
-056
0.80A.
360.00
-052
1.00A
360.00
319.11
341.58
701.58
-058
7.36A.
C = 13 1127,046
-048
5.00 A.
790.84
788.46
469.35
COMB - 048 5.00 A
- 057 2.36 A
7.36A.
6/15/92
19883
APPROVED
LORAIN CO.
MAP DEPT.
DATE 4-29-92
PAGE 6-128
BY CAROLYN FRANCIS
VOID BRUSH # 19883
COMB.
-051
10.00 A.
06-24-001-000-
PRIOR INST: O.R. 400/939
STRAIGHT TRANS.
WEST RIDGE RD
E3271
155.00
(466.51)
275.82
ALBRECHT
756.75
SEE 10-A